


12-6
18

00025

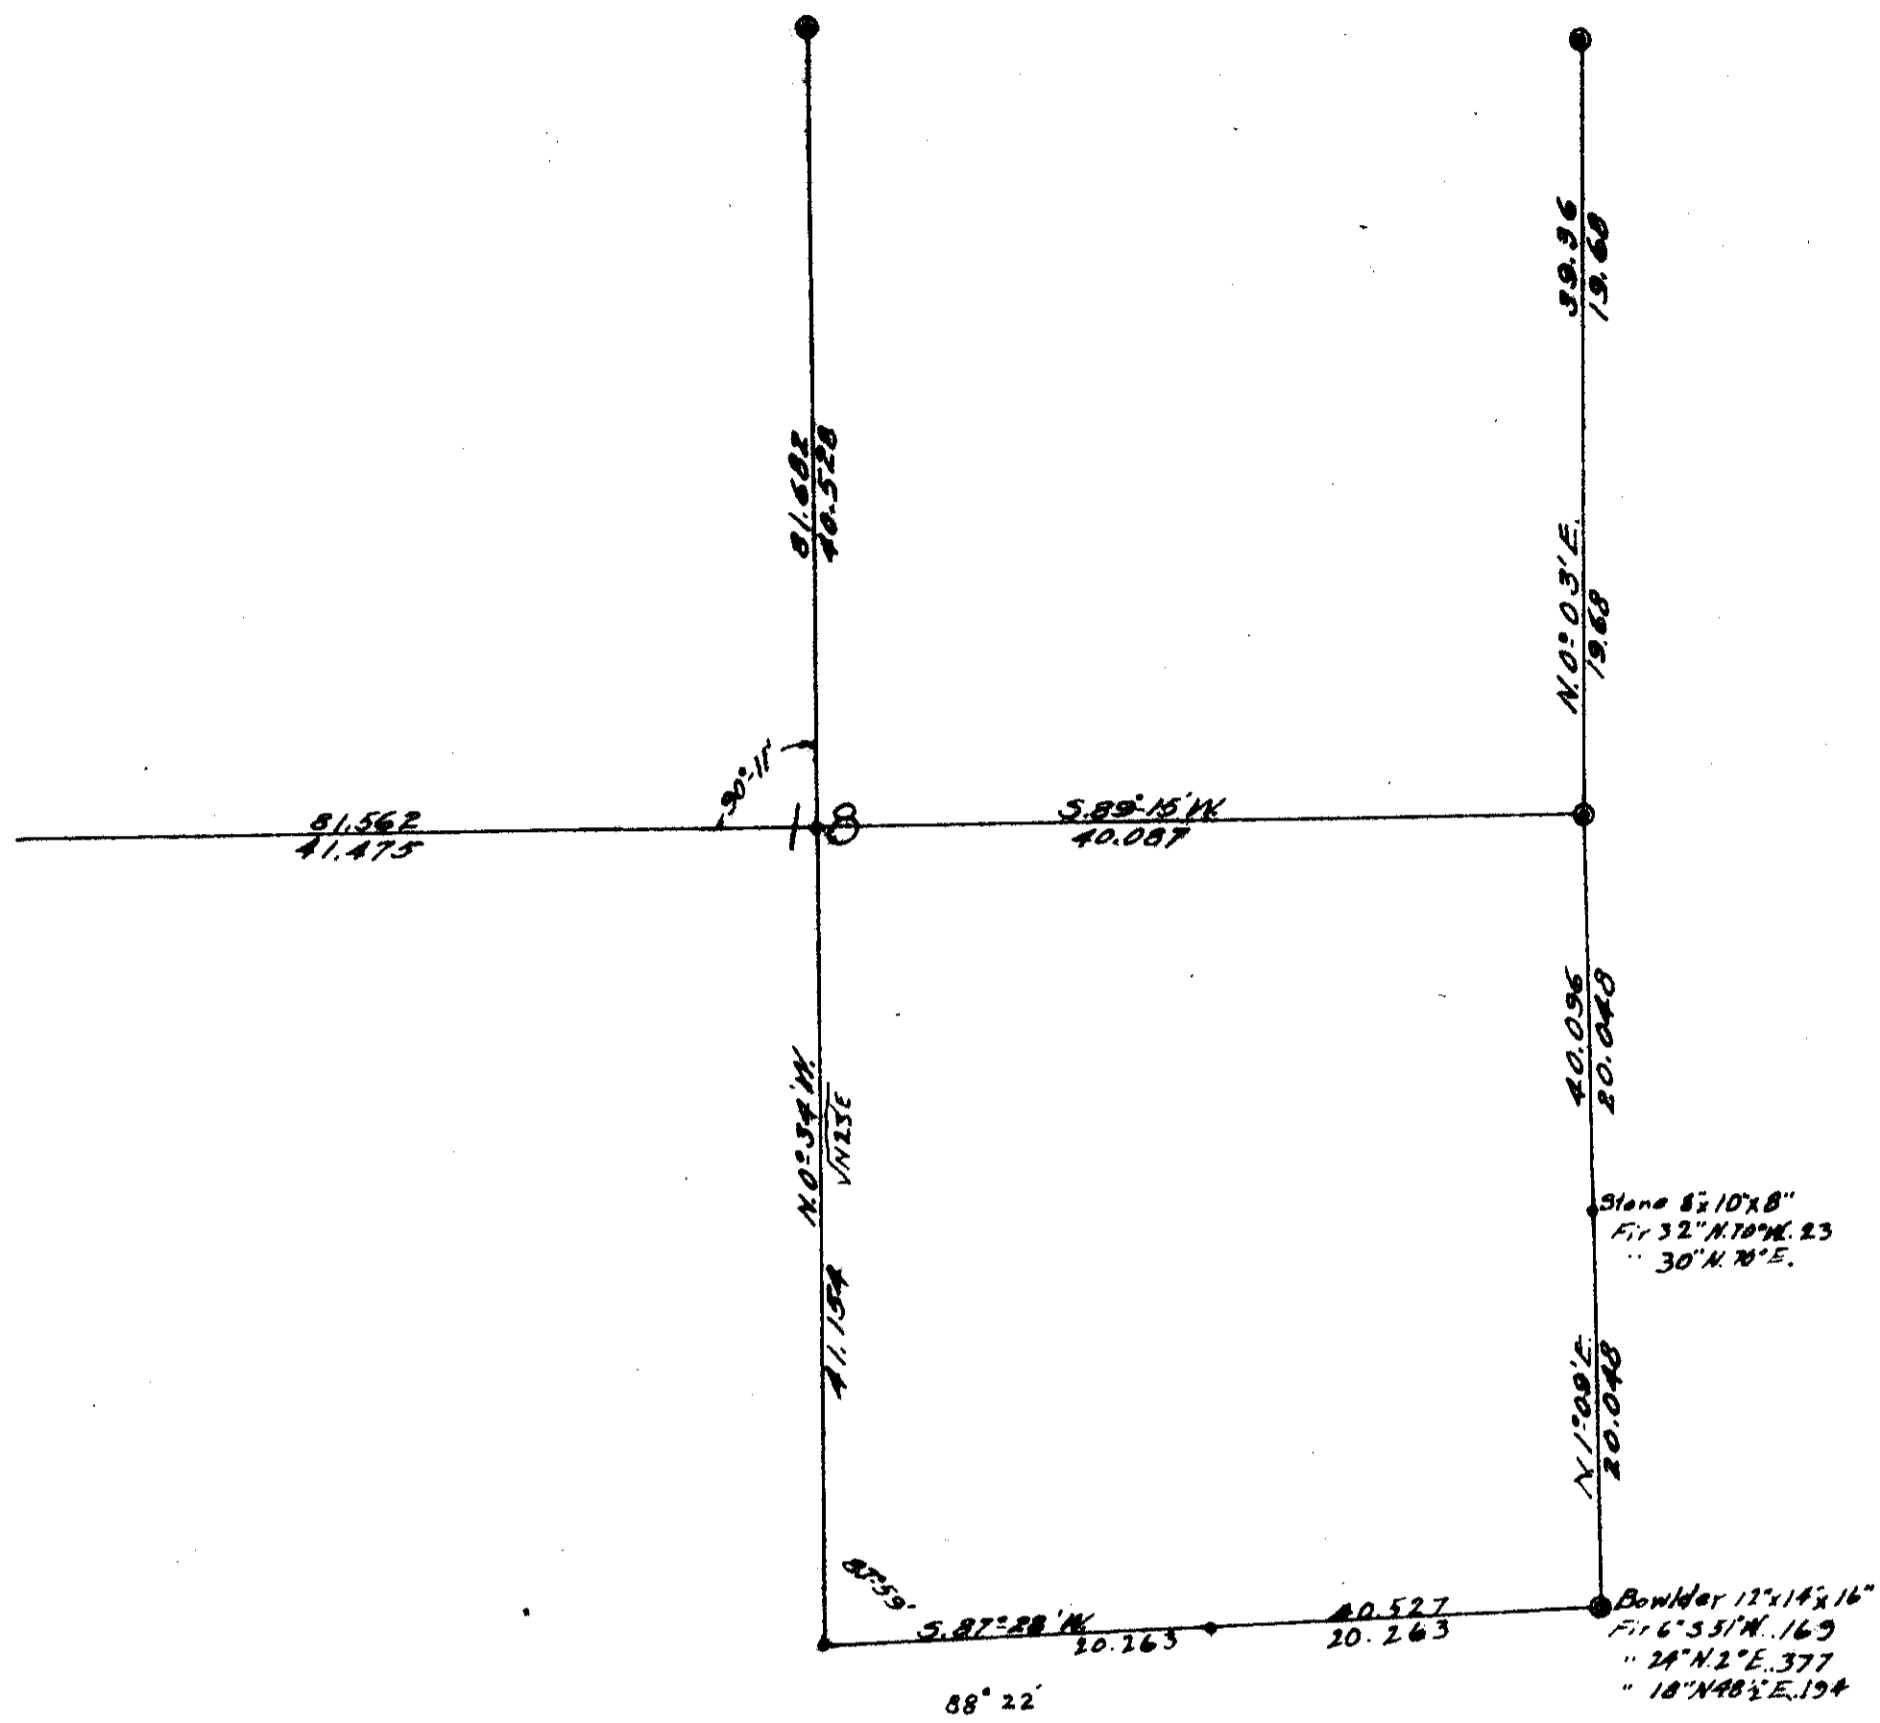

1485
 COUNTY SURVEY No. 340 - CONT
 Sec. 18, T. 12 S. R. 6 W.
 C. W. DAVIS, Admr. G. M. NEIKIRK ESTATE