


12-6  
20, 21, 16, 17

00026

C.S. 71  
Scale: 1" = 100 ft

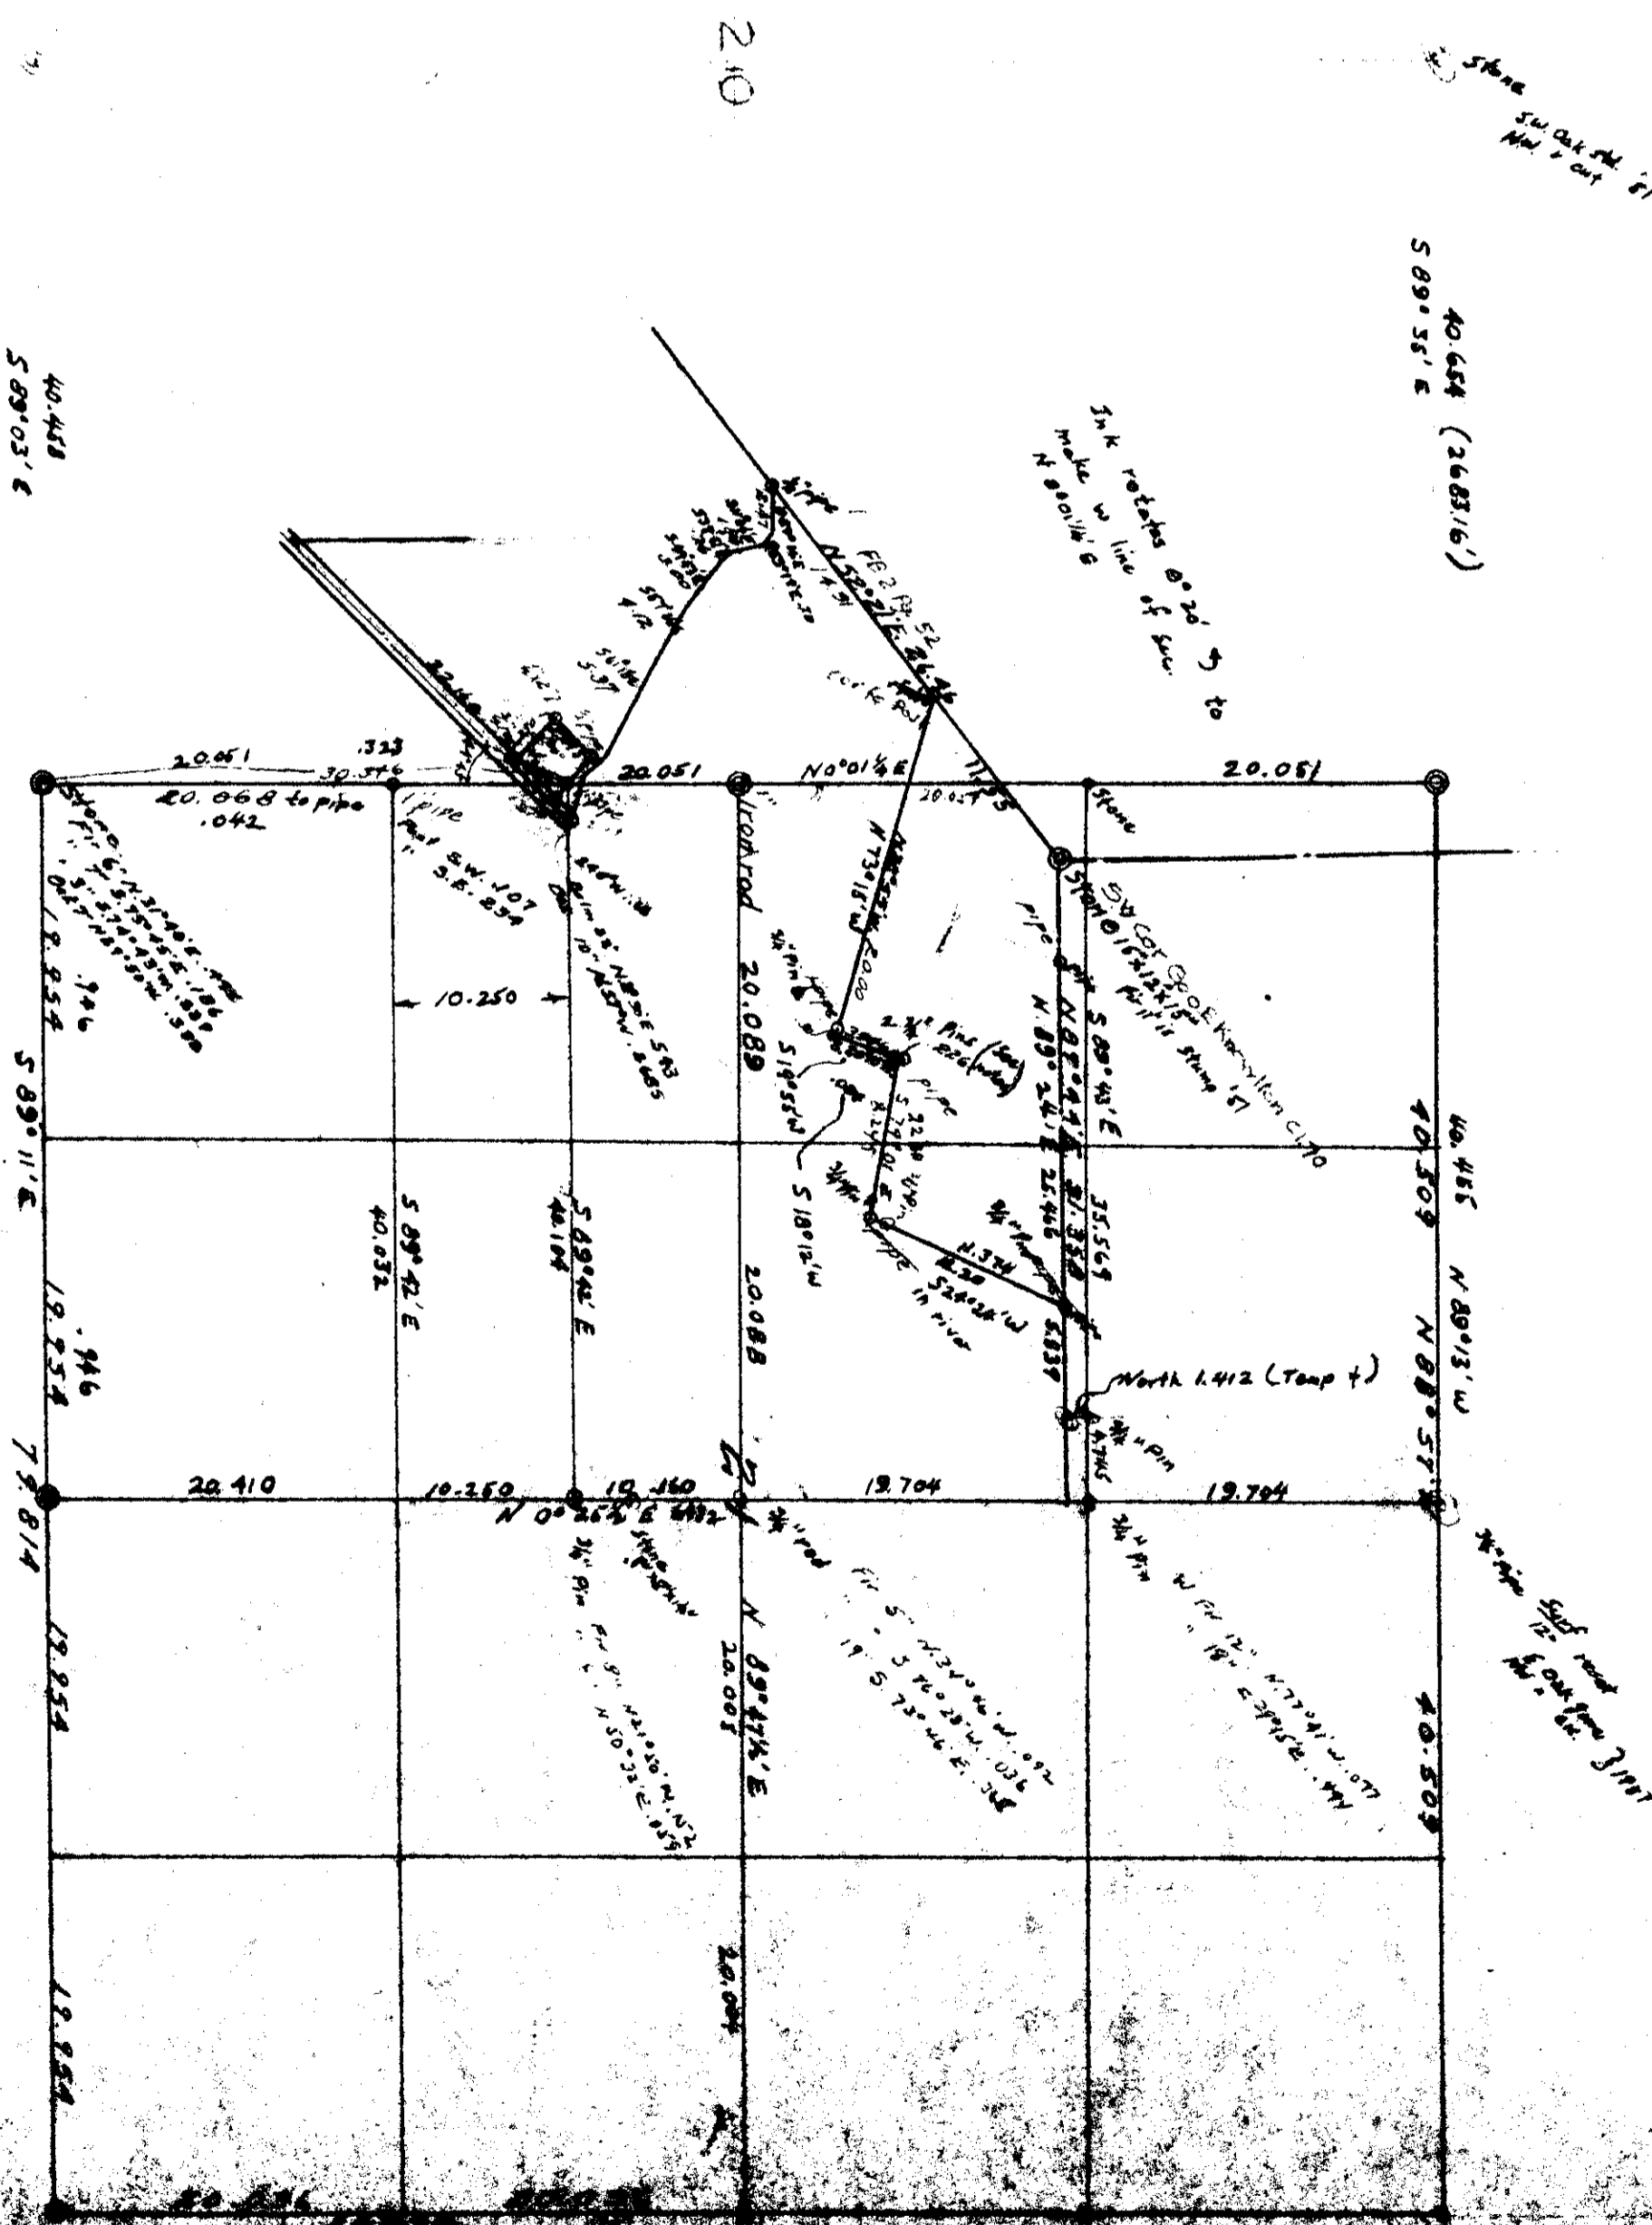

29

20

17

28

H 6