


12-7  
384

00002

103380

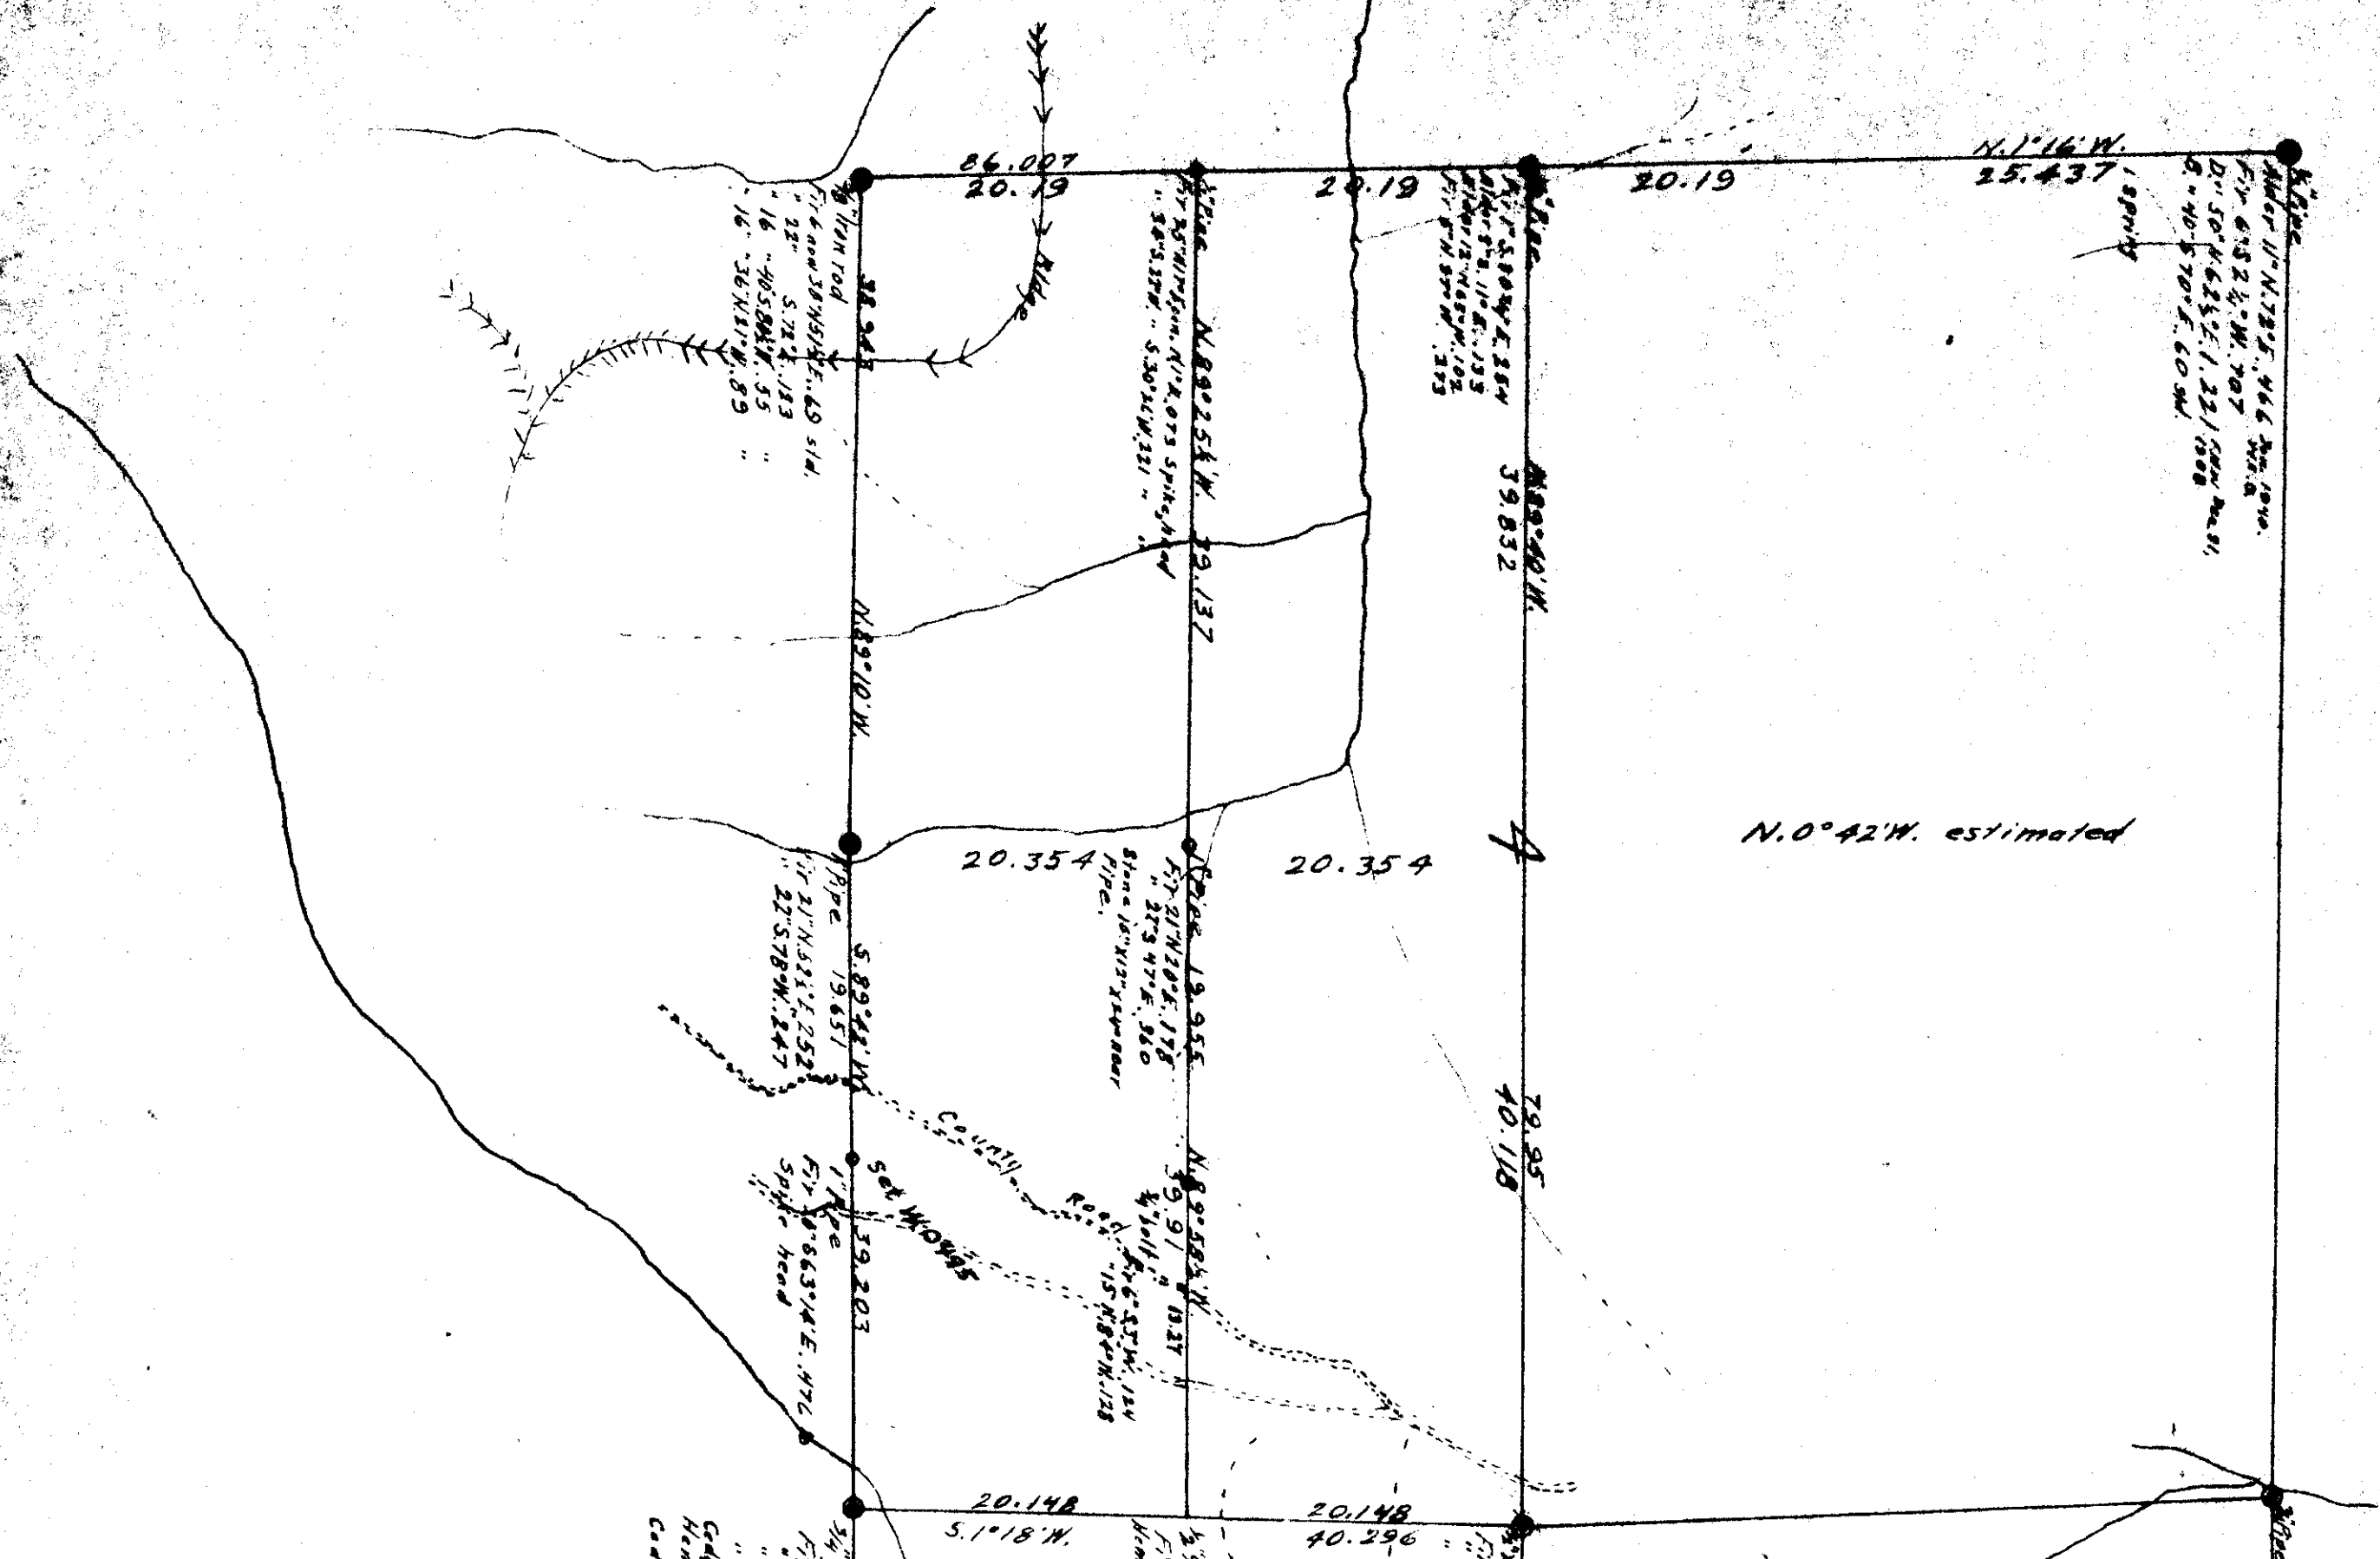

COUNTY SURVEY  
Scale 1" = 10 Chs.