


12-7 00004

C.S. 156

9 & 10

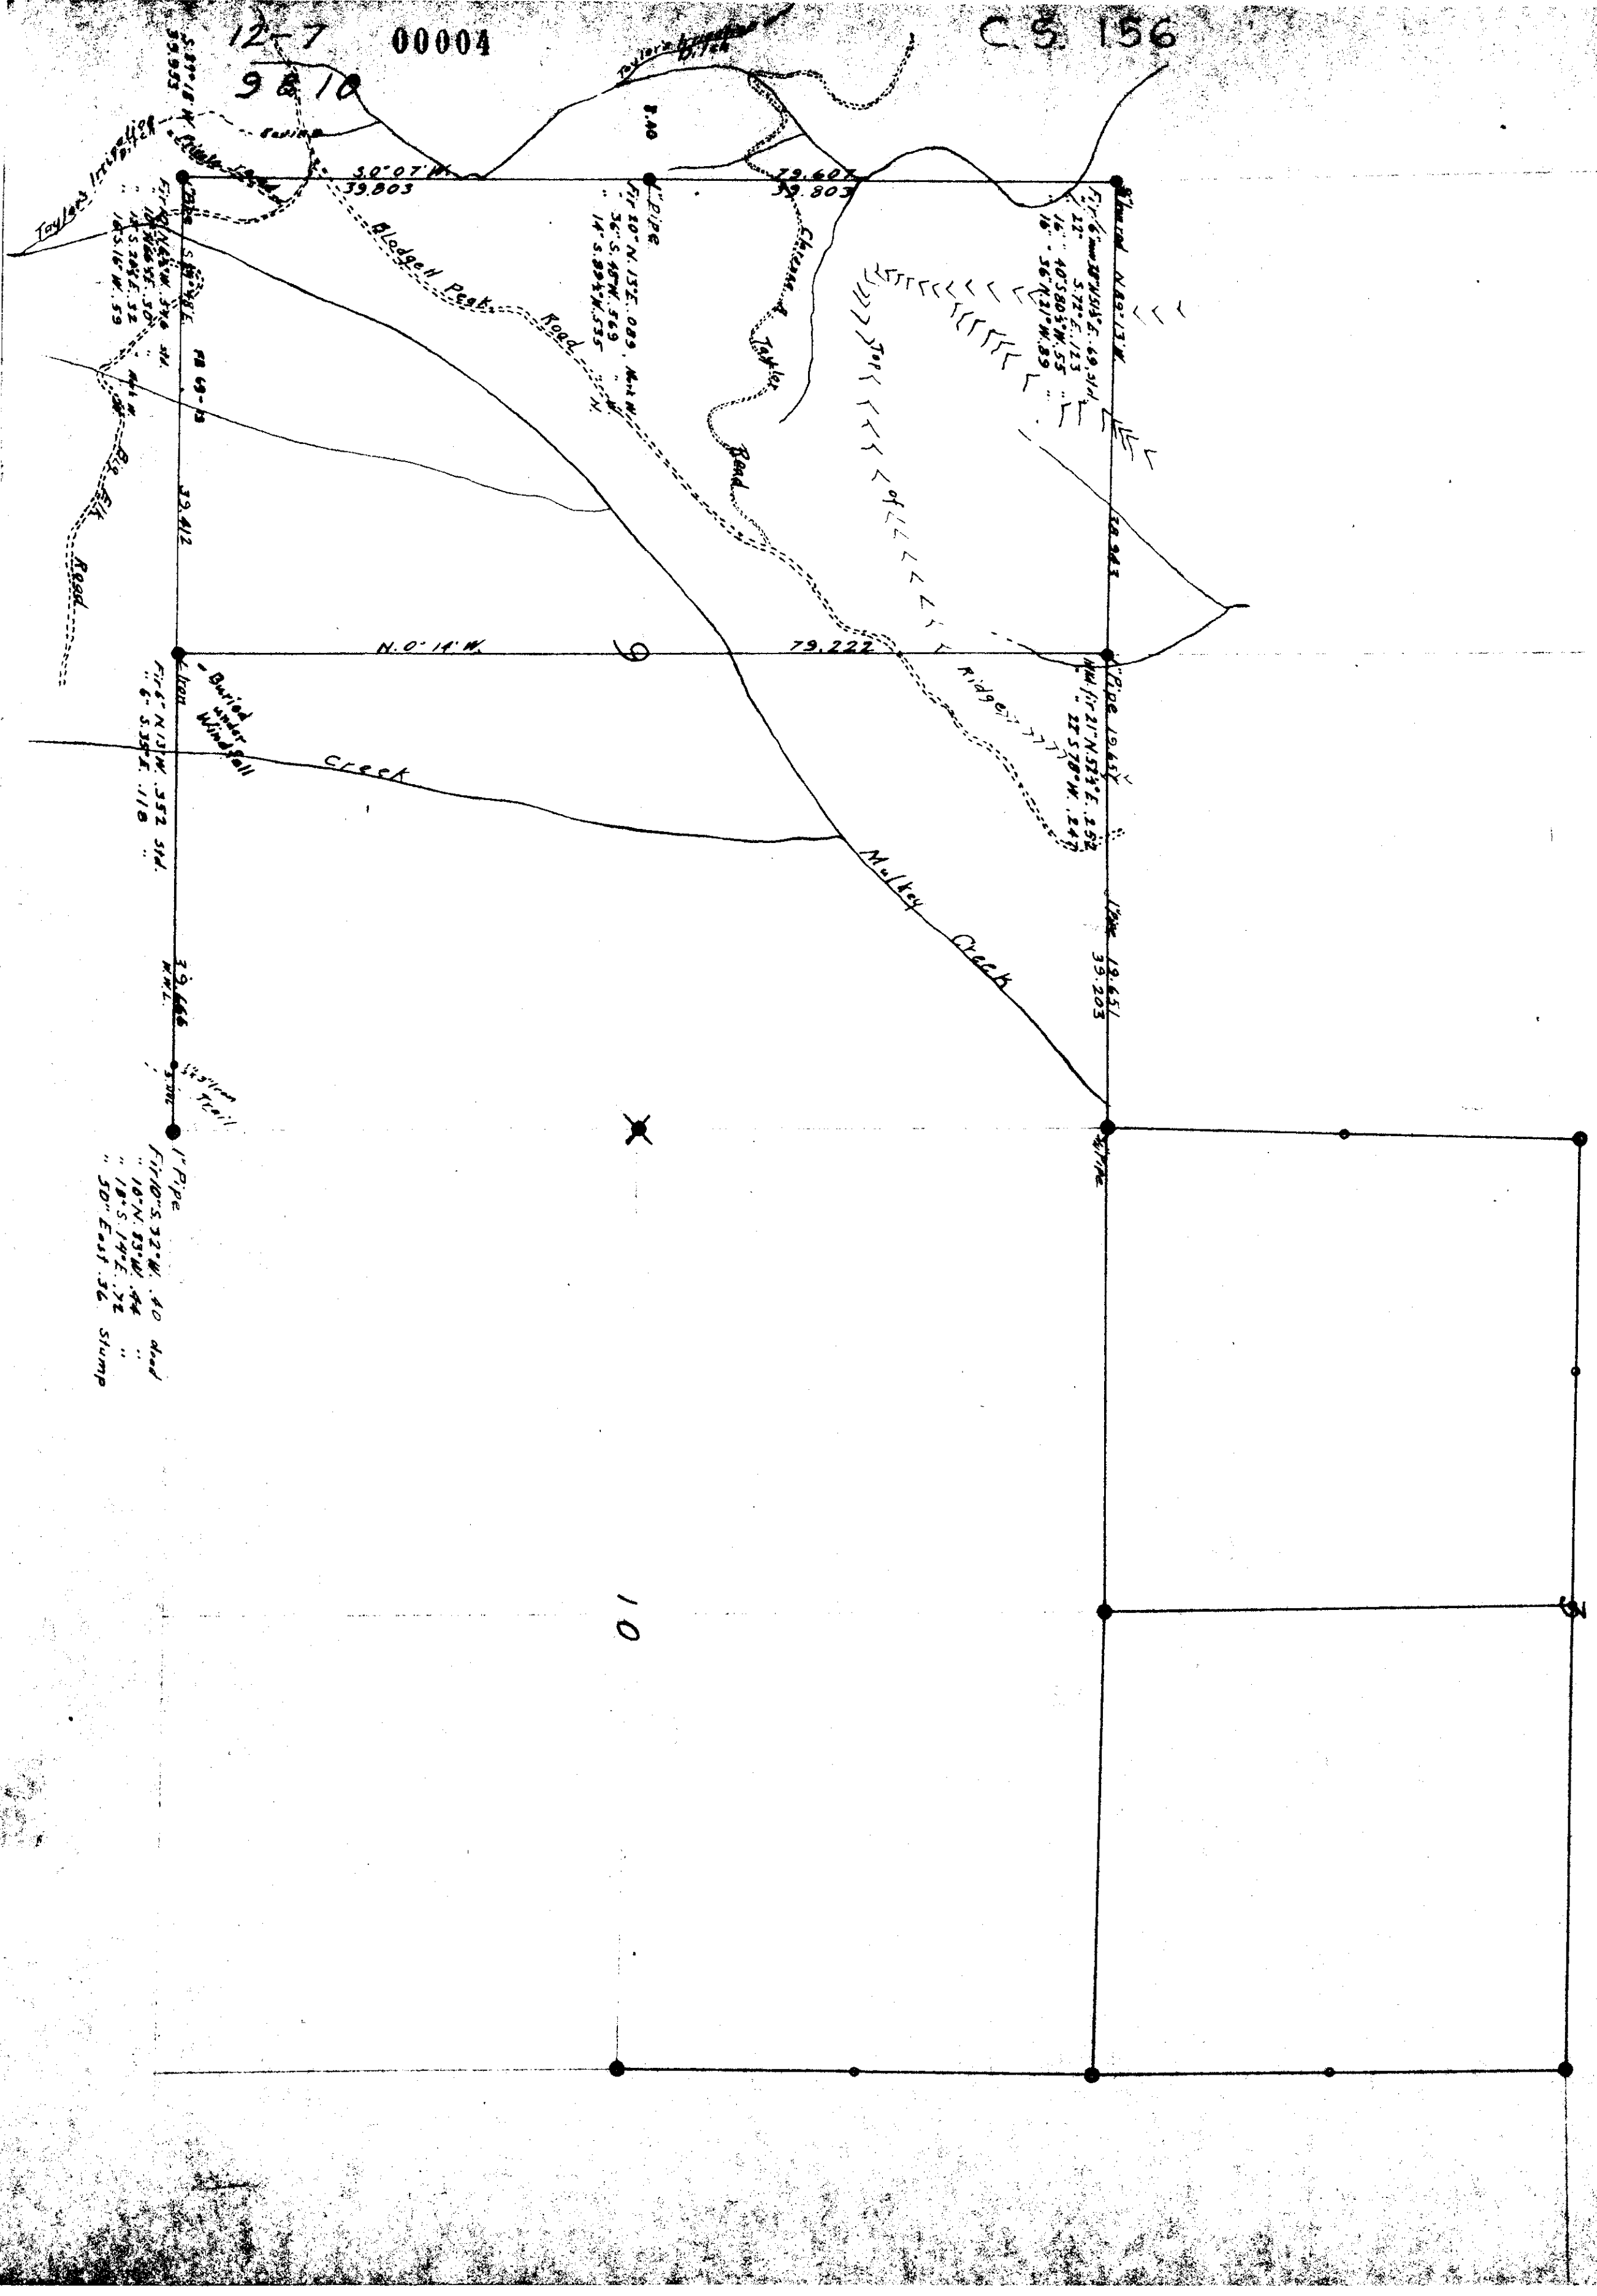

COUNTY SURVEY NO. 156
 Scale 1" = 100 ft.

10

X