

County Survey #251

Section 12

T. 12 S. R. 7 W. W. M.


Made for

M. C. Griswold

Scale 1" = 10 chs.

W. C. Galloway c.s.

July 3, 1916.

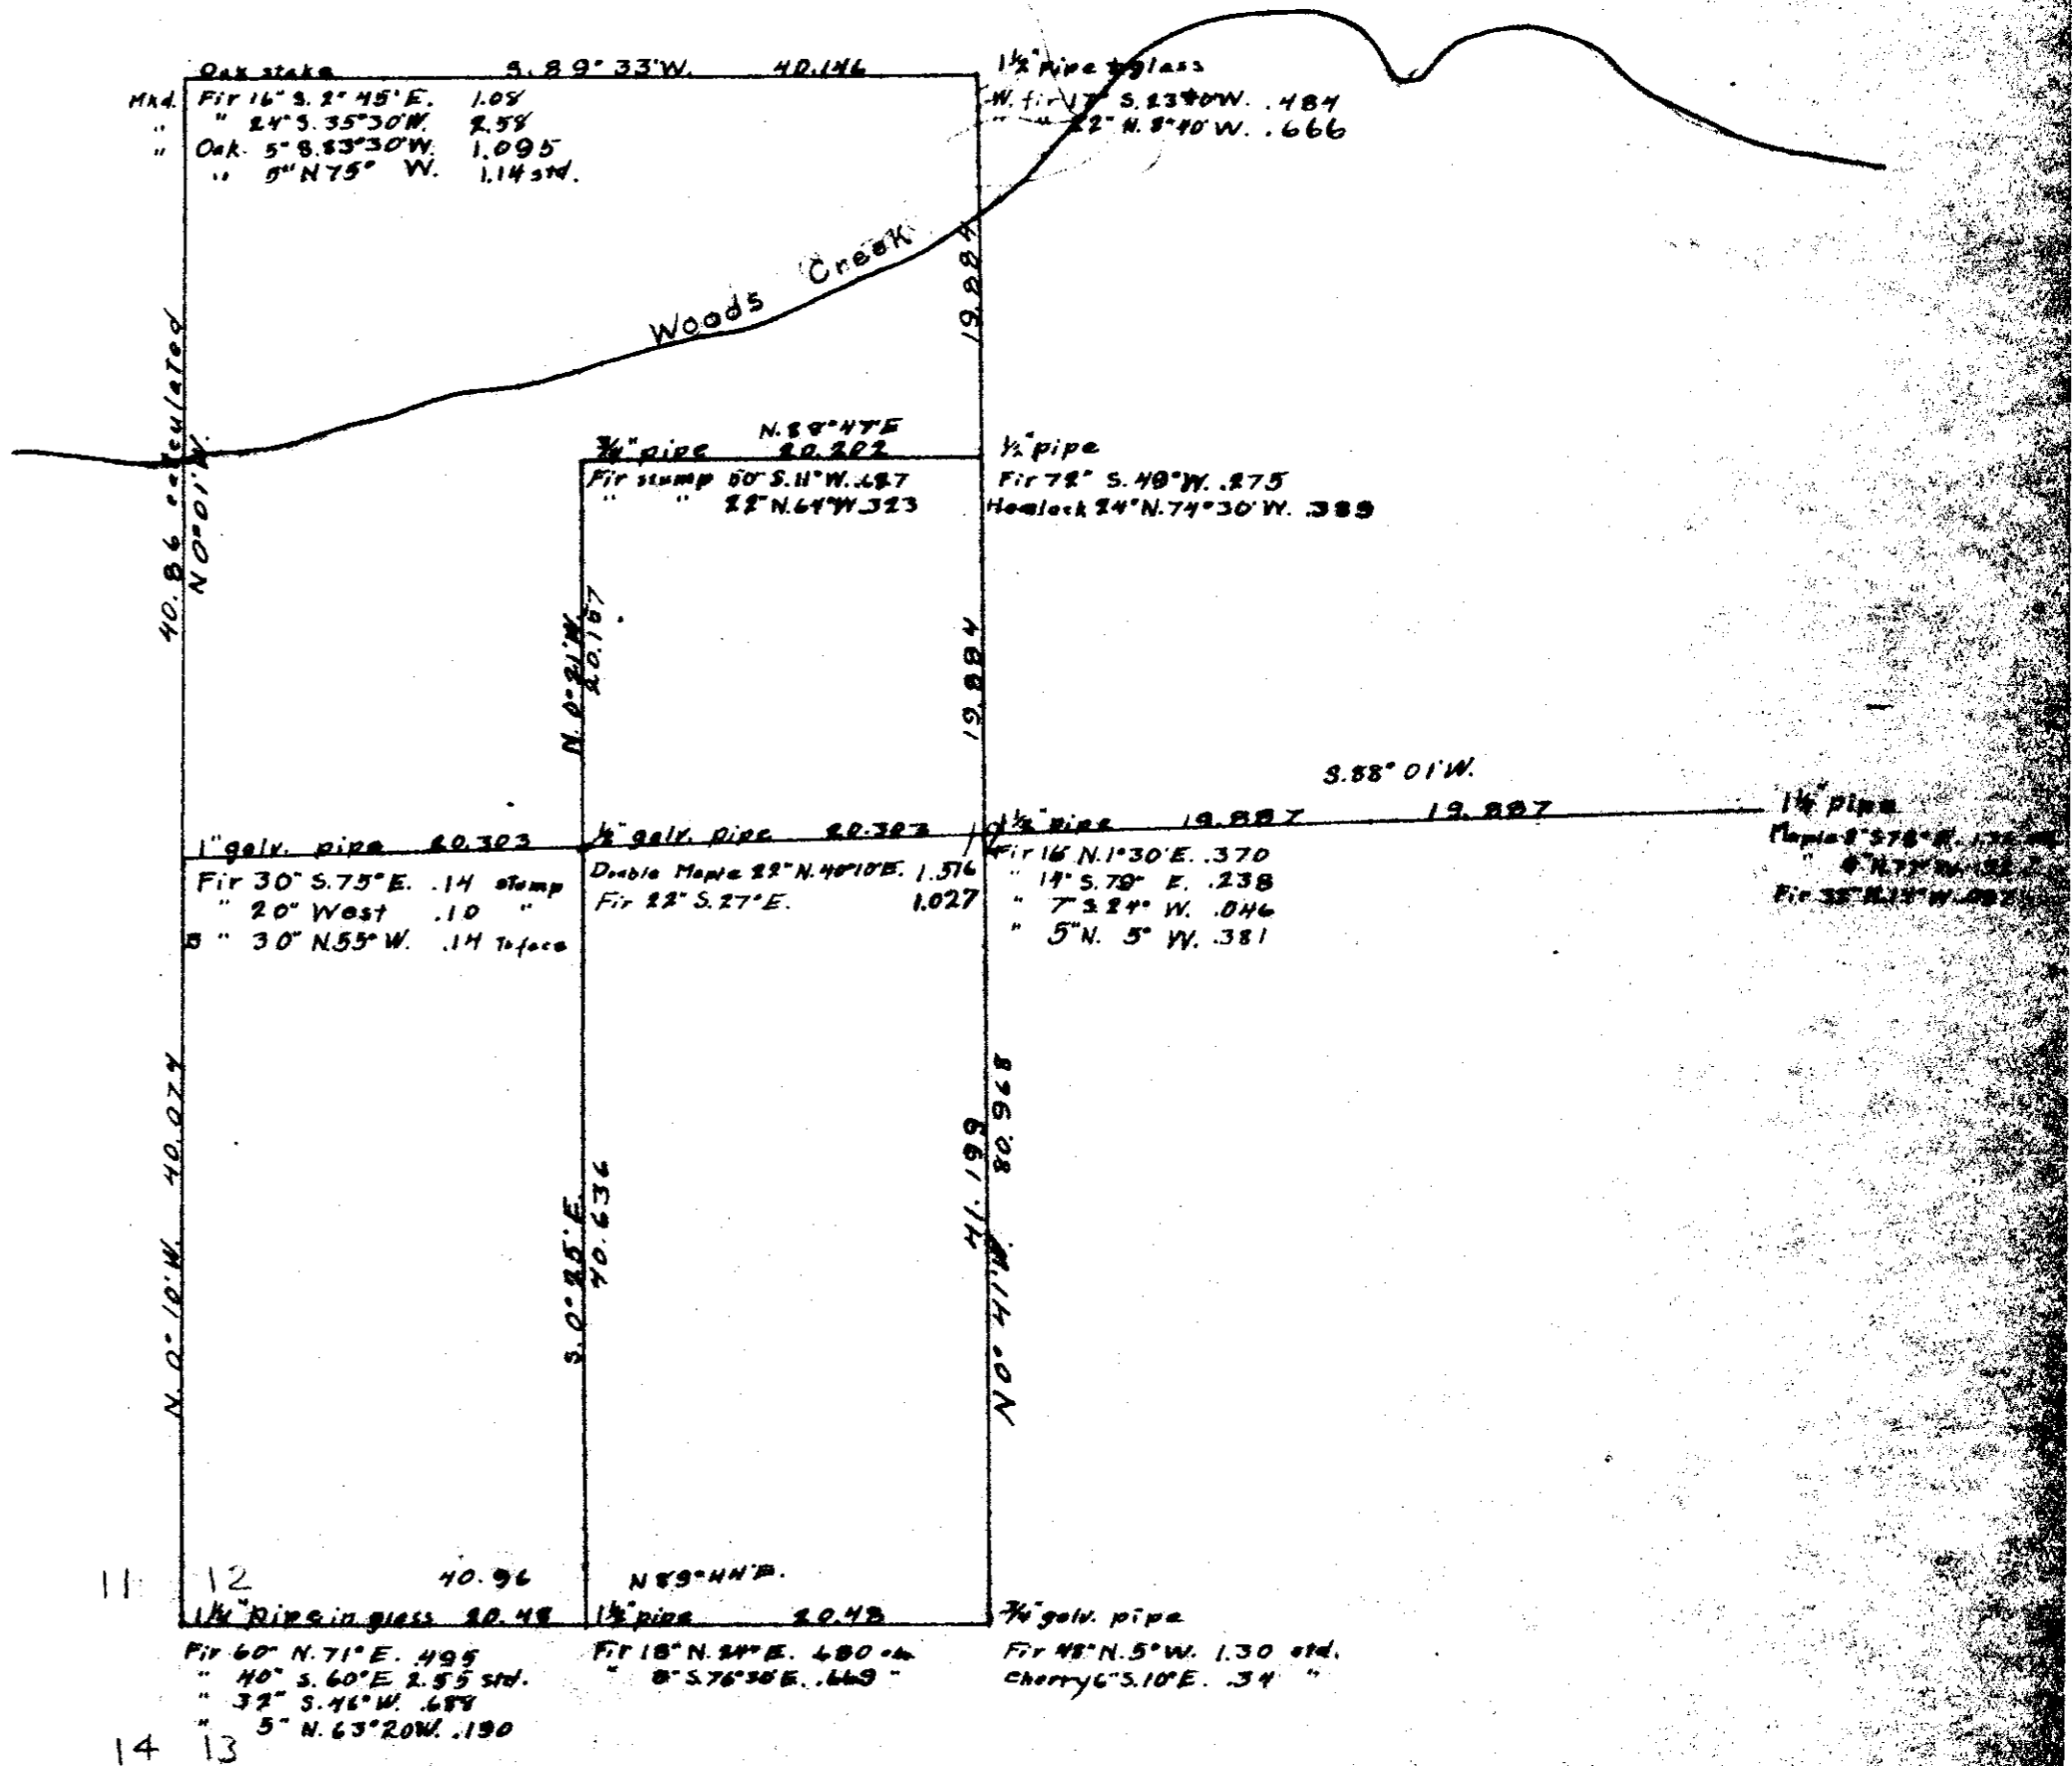

11.12
00005

12-7-00005

County Survey #251

Section 12

T. 12 S. R. 7 W. W. M.


Scale 1" = 10 chs.

W.C. Galloway c.s.

July 3, 1916.

Made for

M.C. Griswold

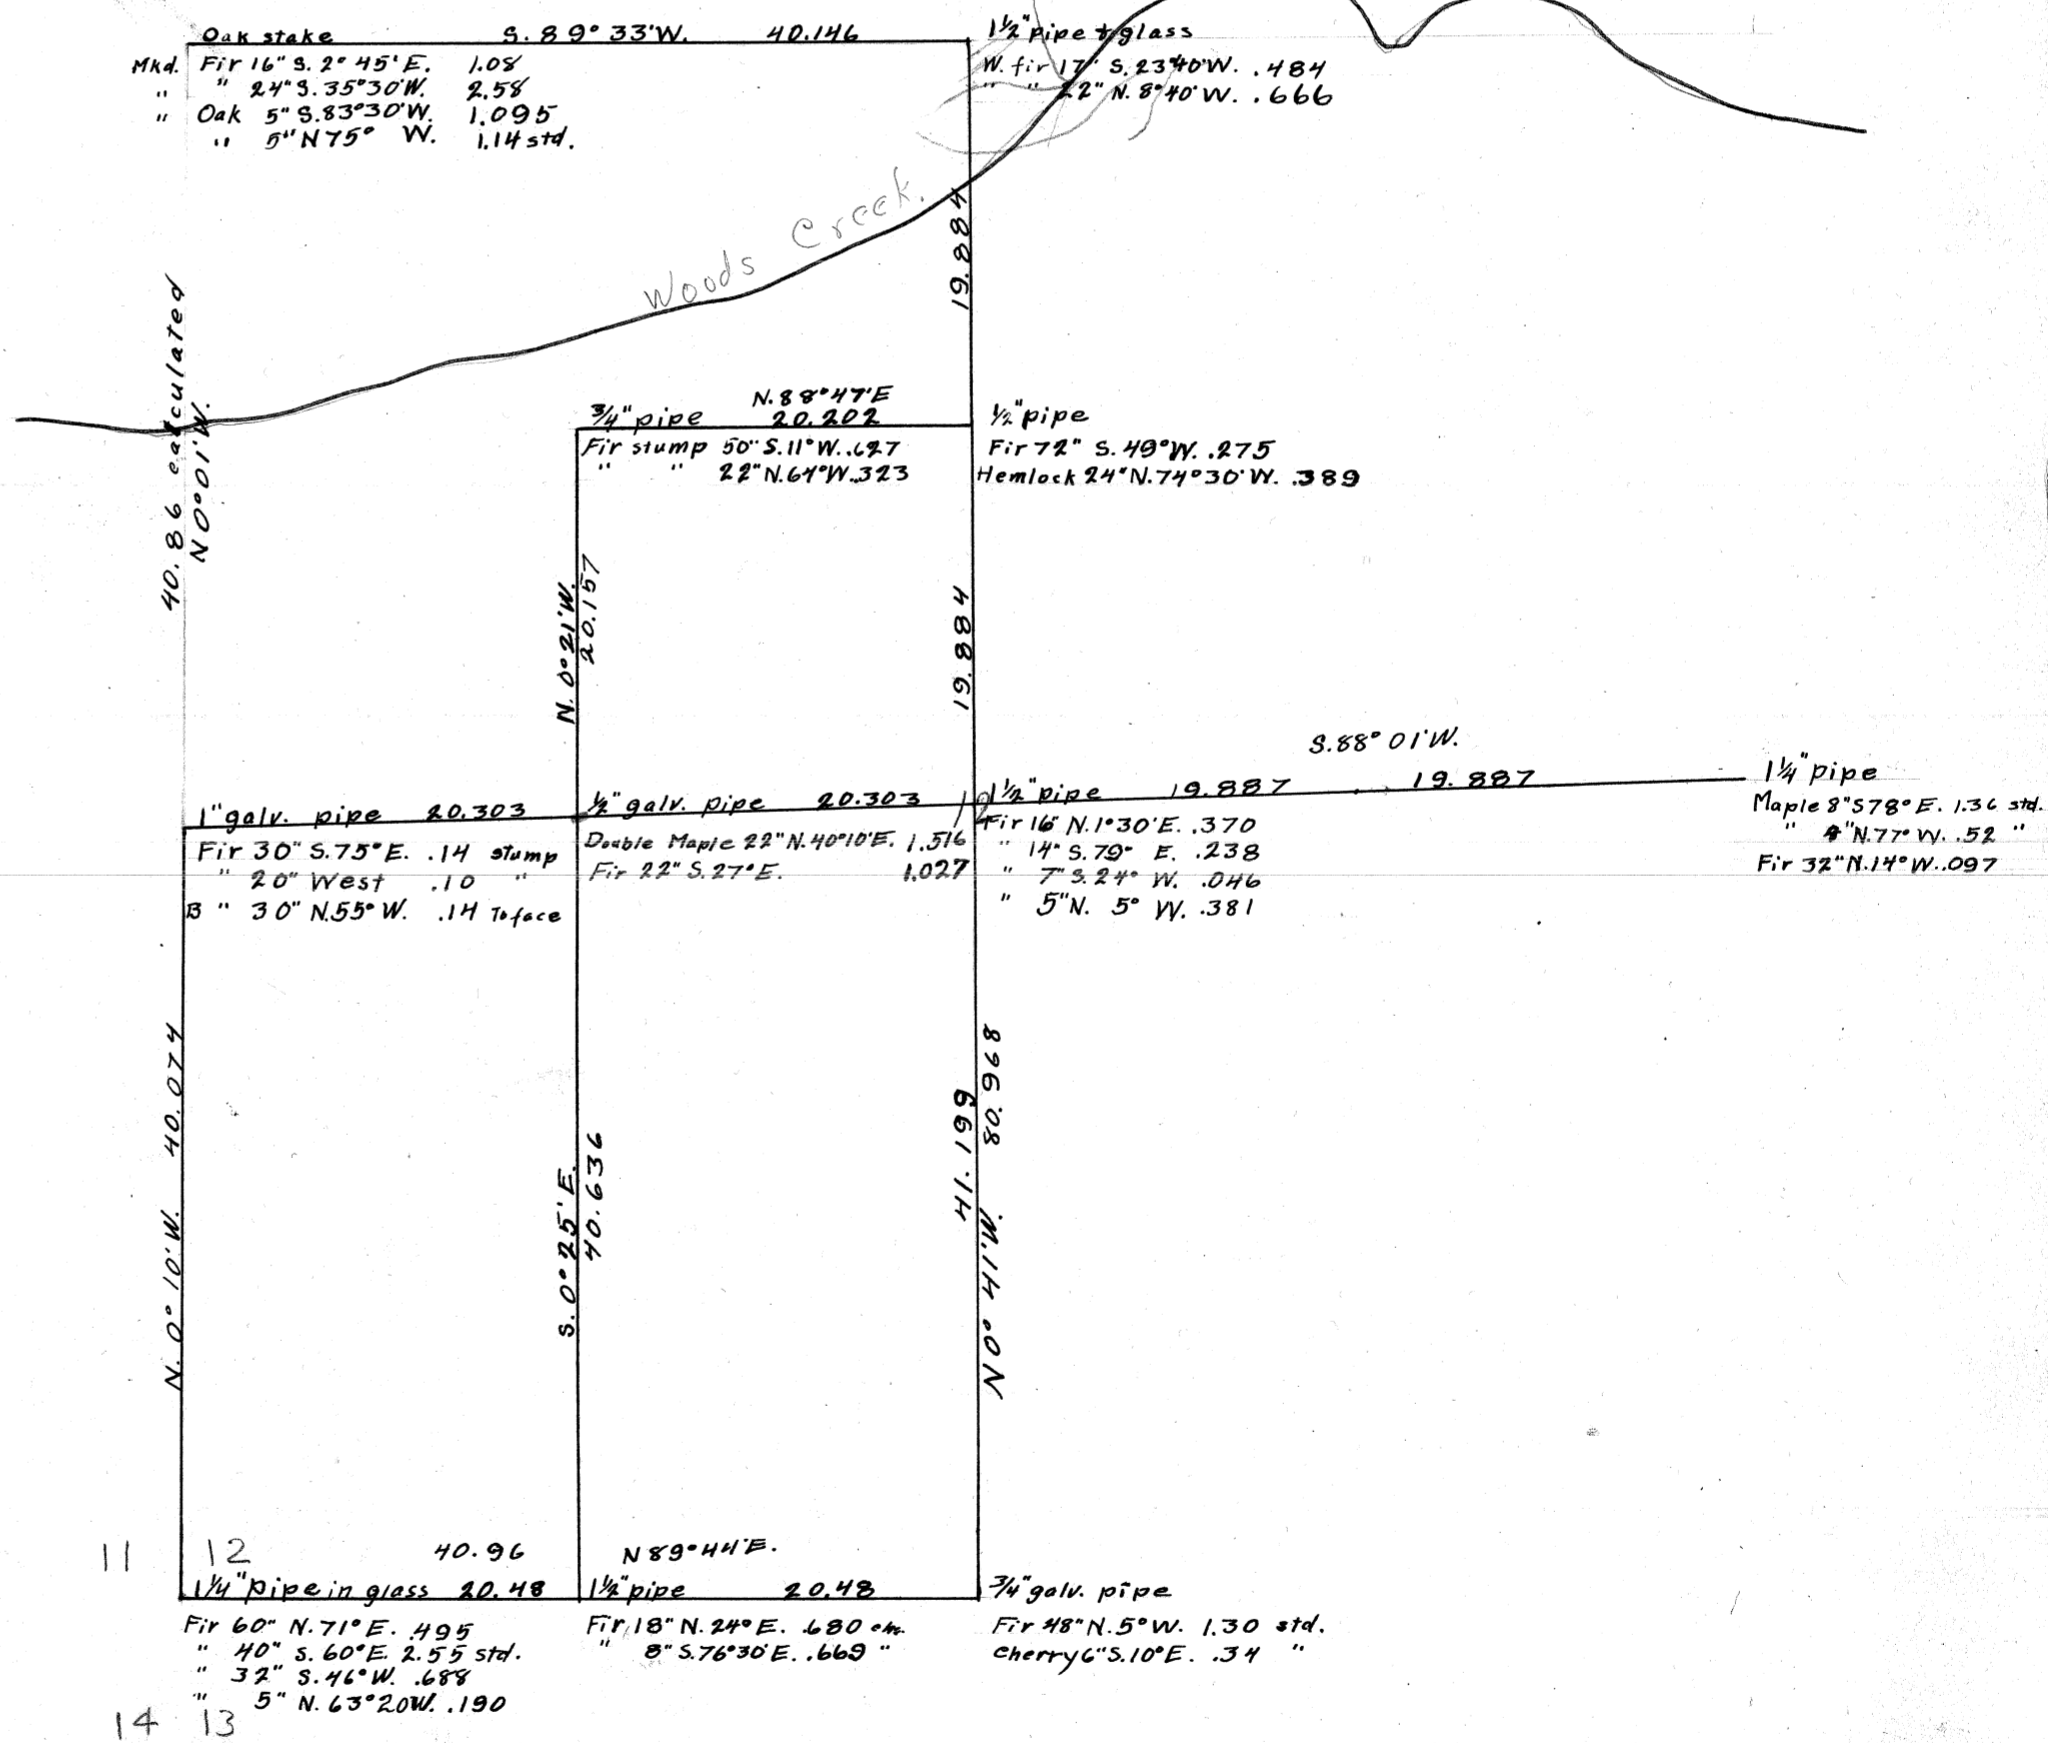

CS 251

12-7
11.12