


13-4  
30

C 5 218

00003

30

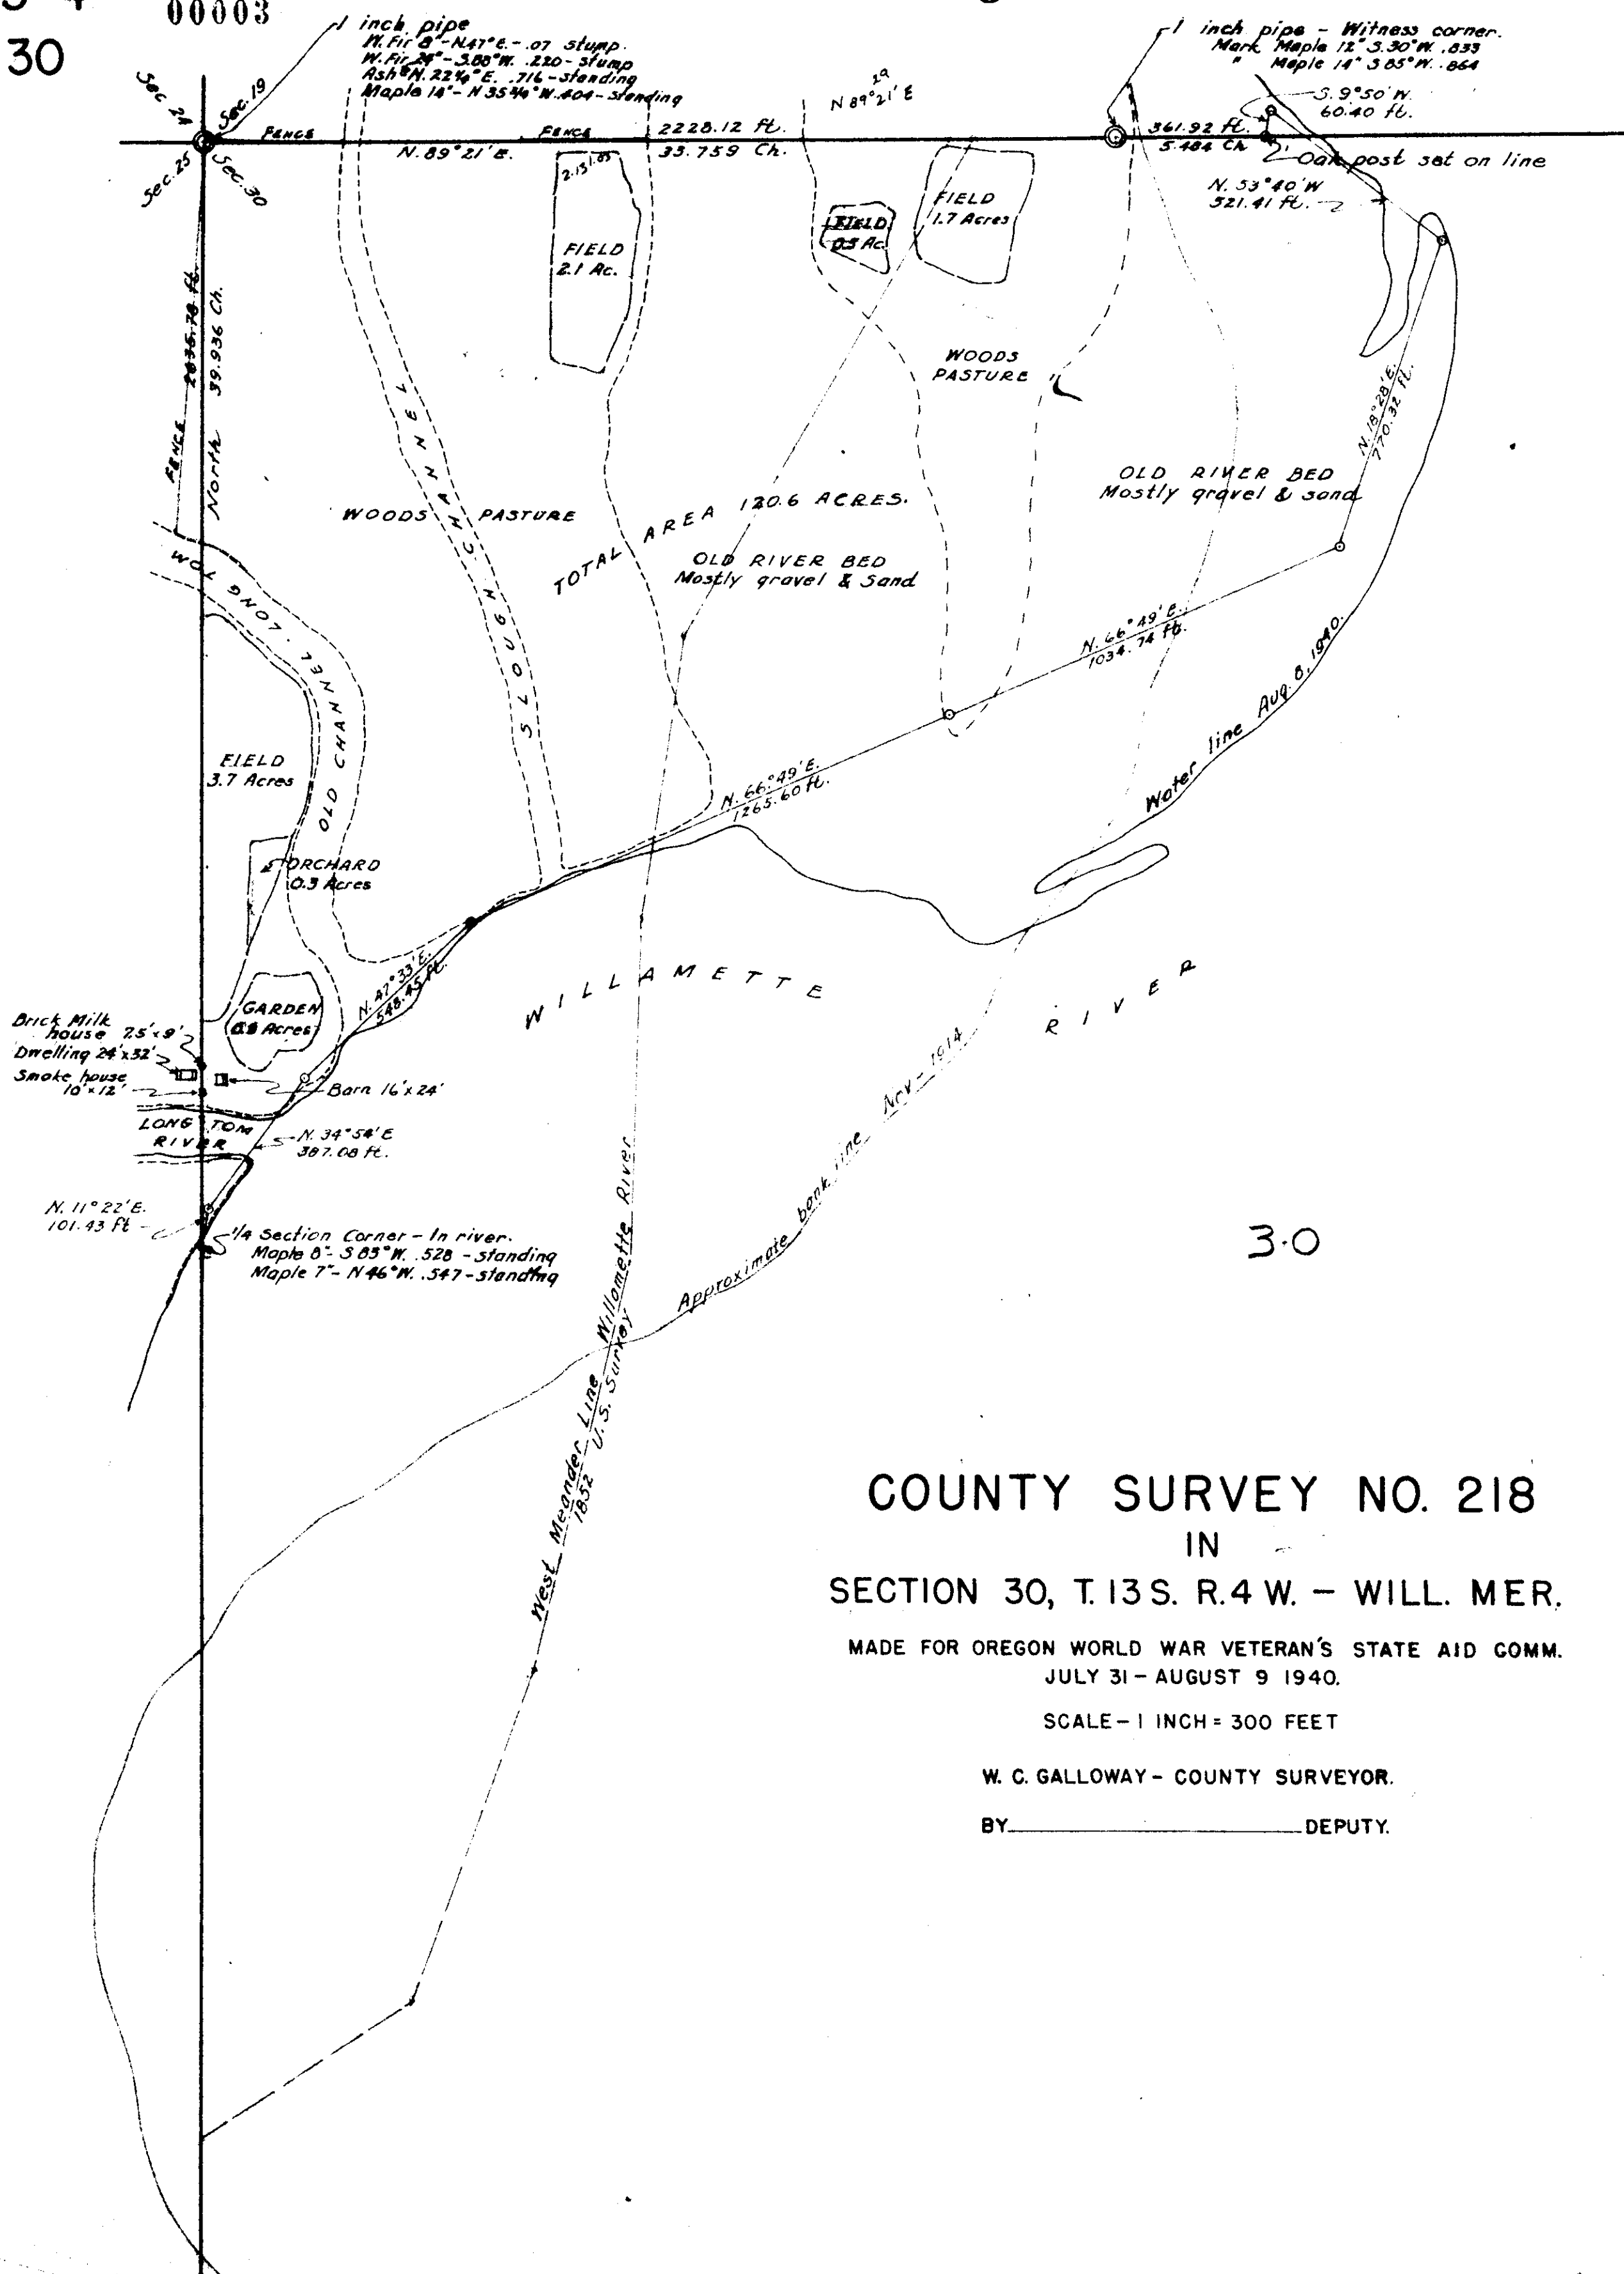

30

**COUNTY SURVEY NO. 218**  
**IN**  
**SECTION 30, T.13S. R.4 W. - WILL. MER.**  
 MADE FOR OREGON WORLD WAR VETERAN'S STATE AID COMM.  
 JULY 31 - AUGUST 9 1940.  
 SCALE - 1 INCH = 300 FEET  
 W. C. GALLOWAY - COUNTY SURVEYOR.  
 BY \_\_\_\_\_ DEPUTY.