


13-4 00004
30

CS 218

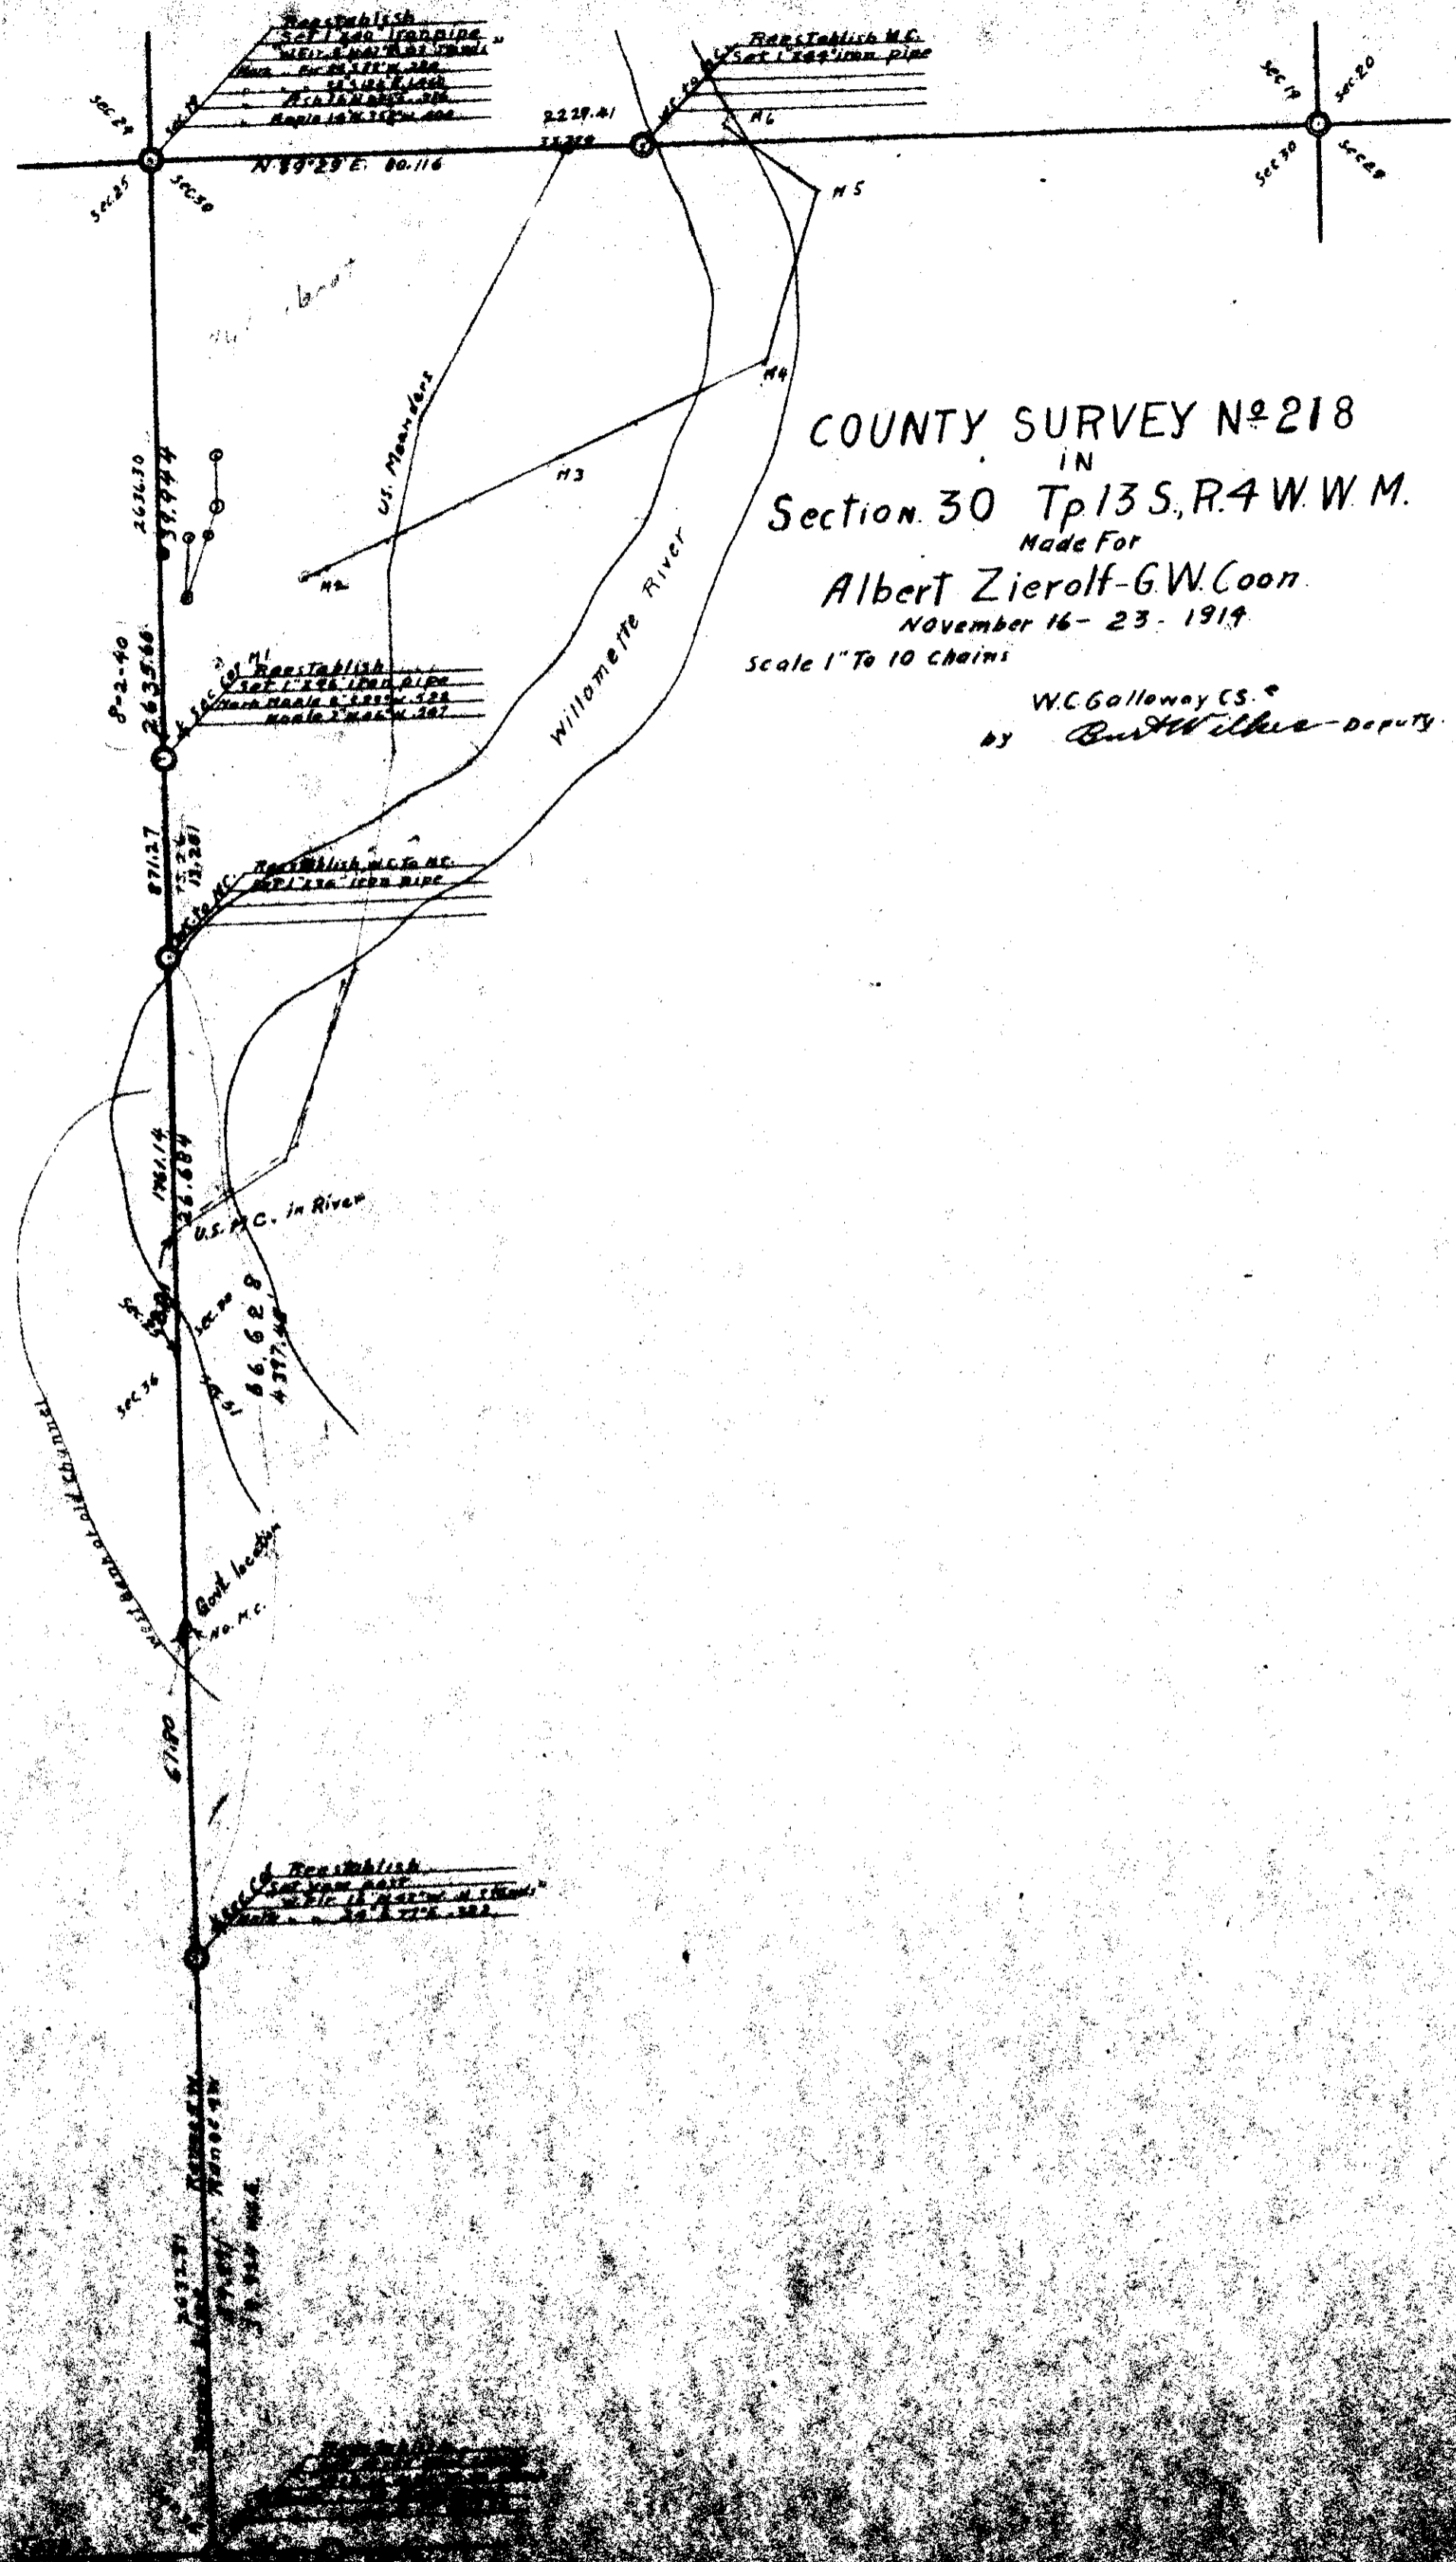

COUNTY SURVEY No 218
IN
Section 30 Tp 13 S, R. 4 W. W. M.
Made For
Albert Zierolf-G.W. Coon
November 16-23-1919
Scale 1" To 10 Chains

W.C. Galloway C.S.
by *Ben Wilber* - deputy

Book 17 - 73
19 - 13
71 - 15