

12-6 00001
2, 3, 10, & 11


C.S. 294

COUNTY SURVEY No 294

James Daggatt D.L.C. 44

Secs 2, 3, 12 & 13, T. 135. R. 6 W. W.M.

Scale 1"=100ft
Sec 34
Apr 11 1883

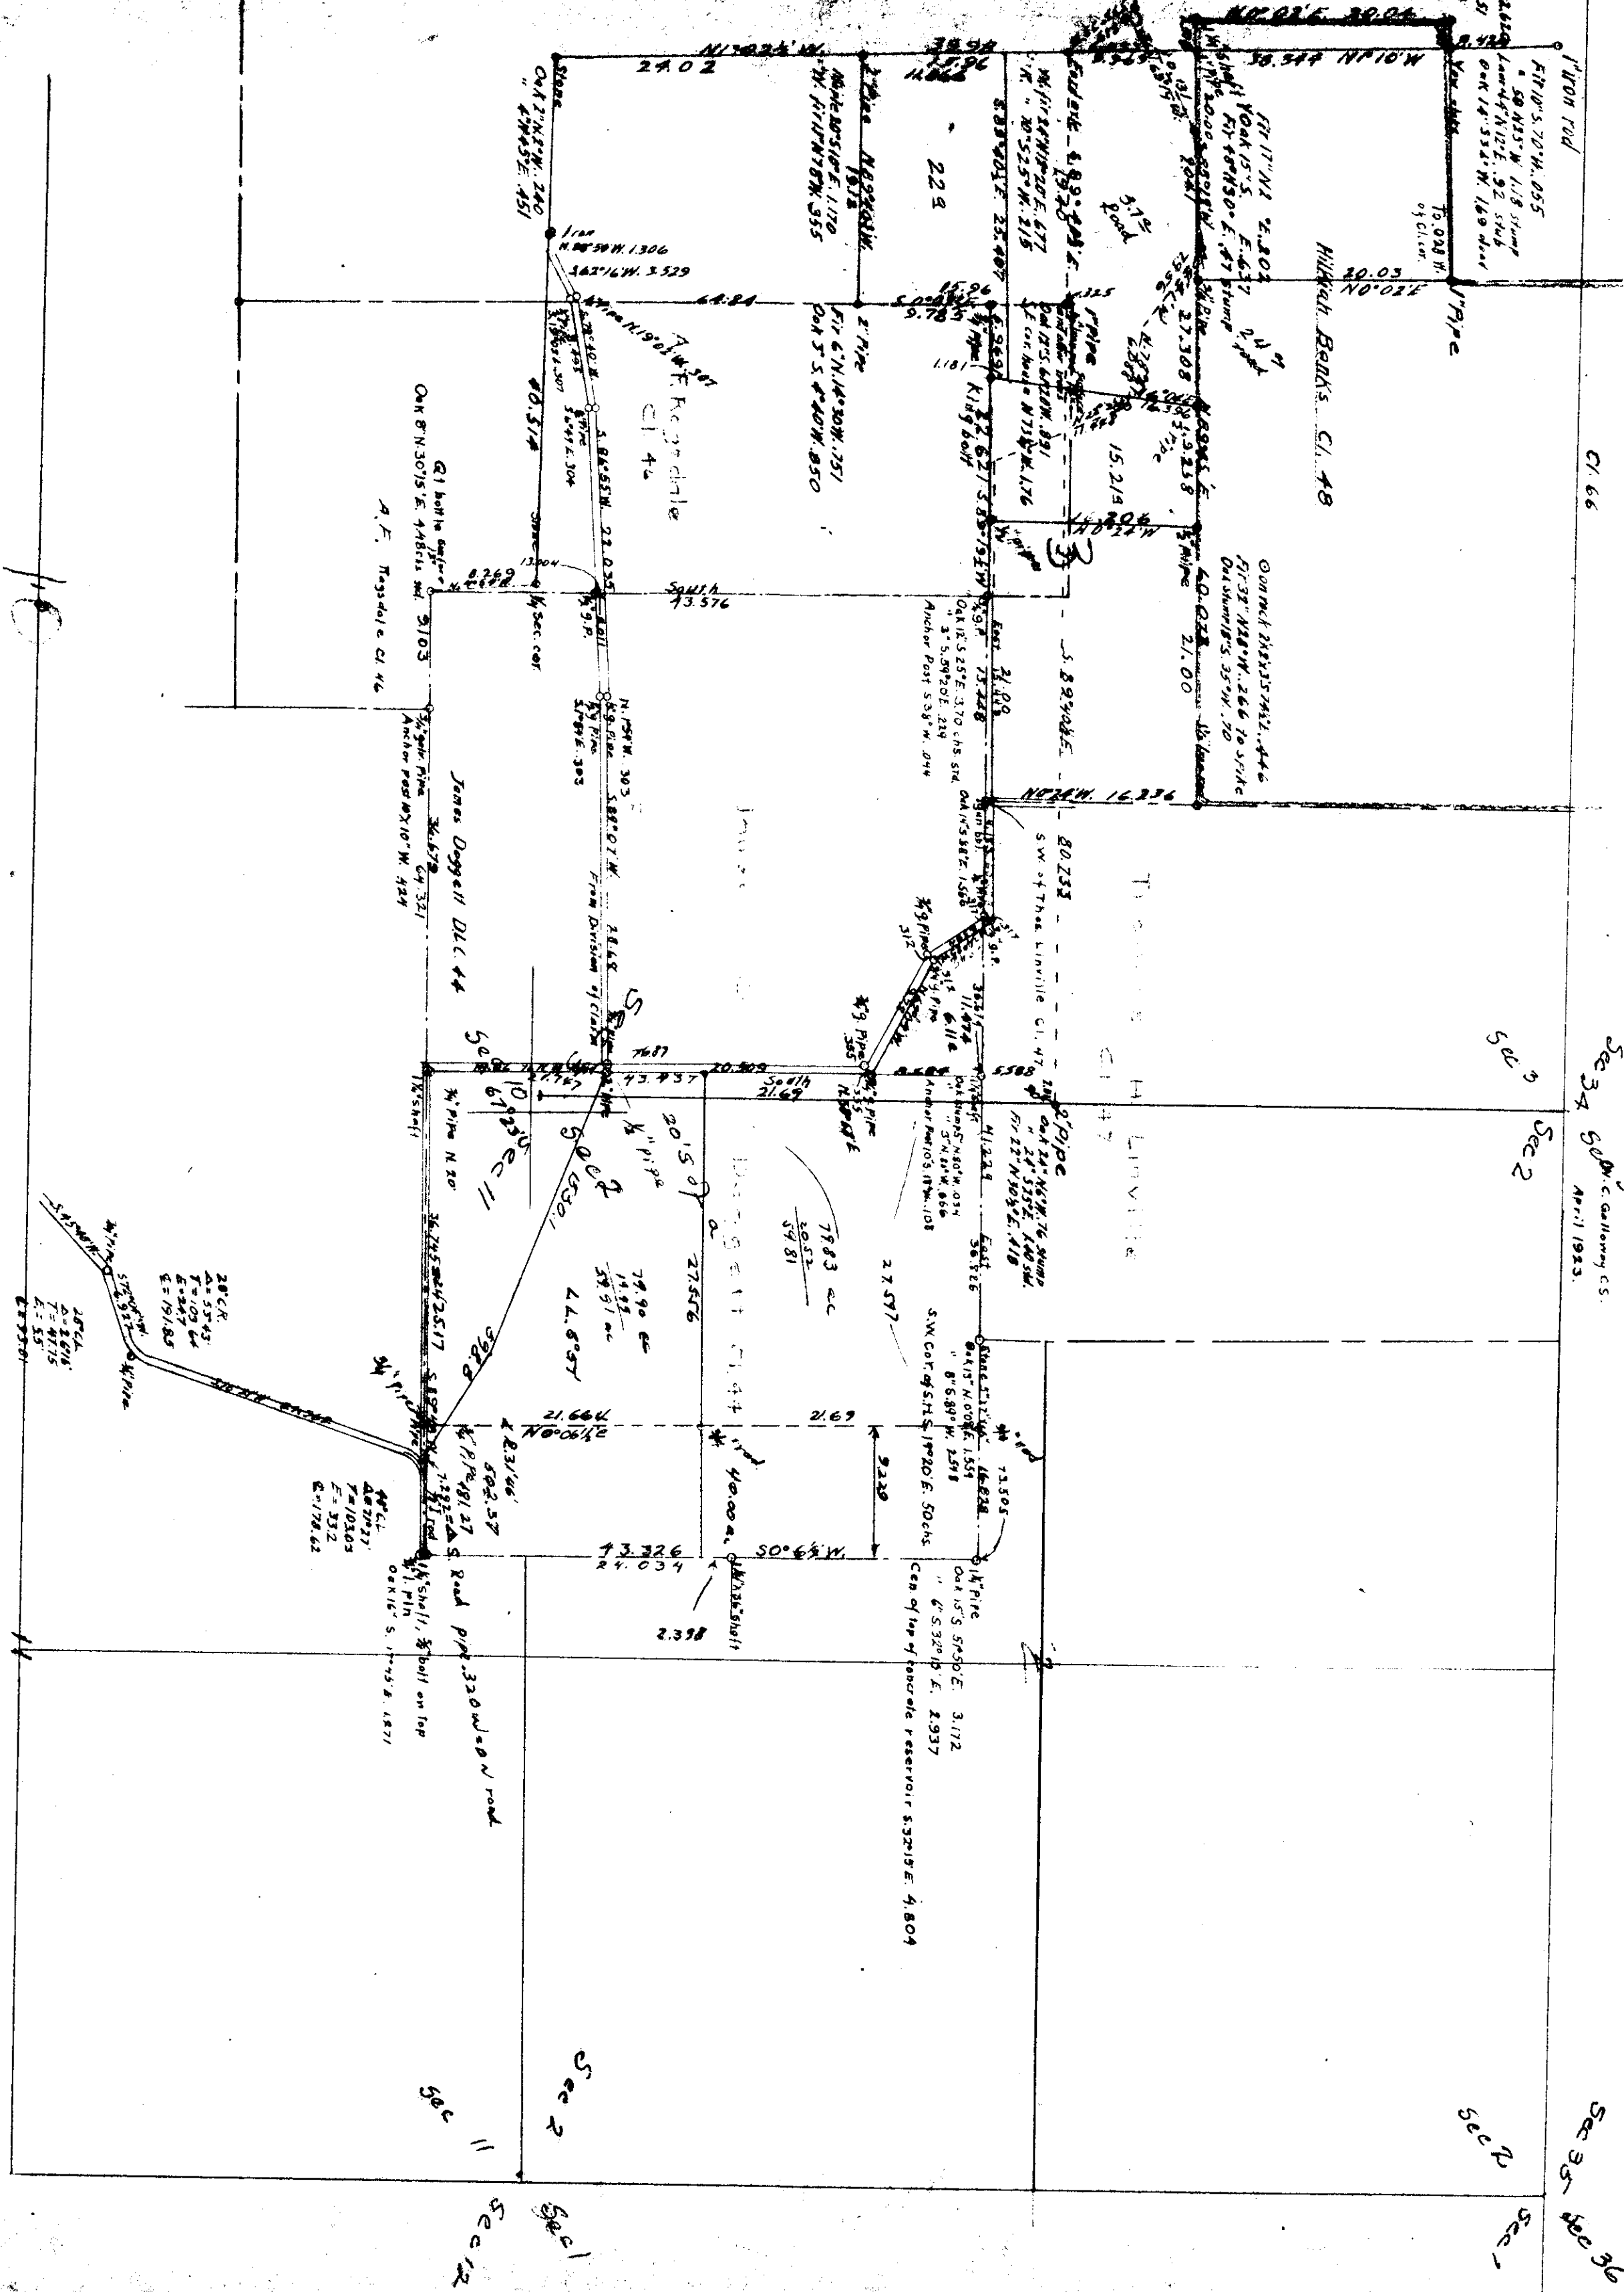

Sec 34

Sec 3

Sec 2

Sec 1

Sec 12

Sec 11

Sec 10

Sec 9

Sec 8

Sec 7

Sec 6

Sec 5

Sec 4

Sec 3

Sec 2

Sec 1