

13-6

00010


13-24

# C. S. 208

Sec's. 13 & 24, T. 13 S., R. 6 W., WILL. MER.

Scale 1 in. = 10 chs.

James Foster Cl. 38

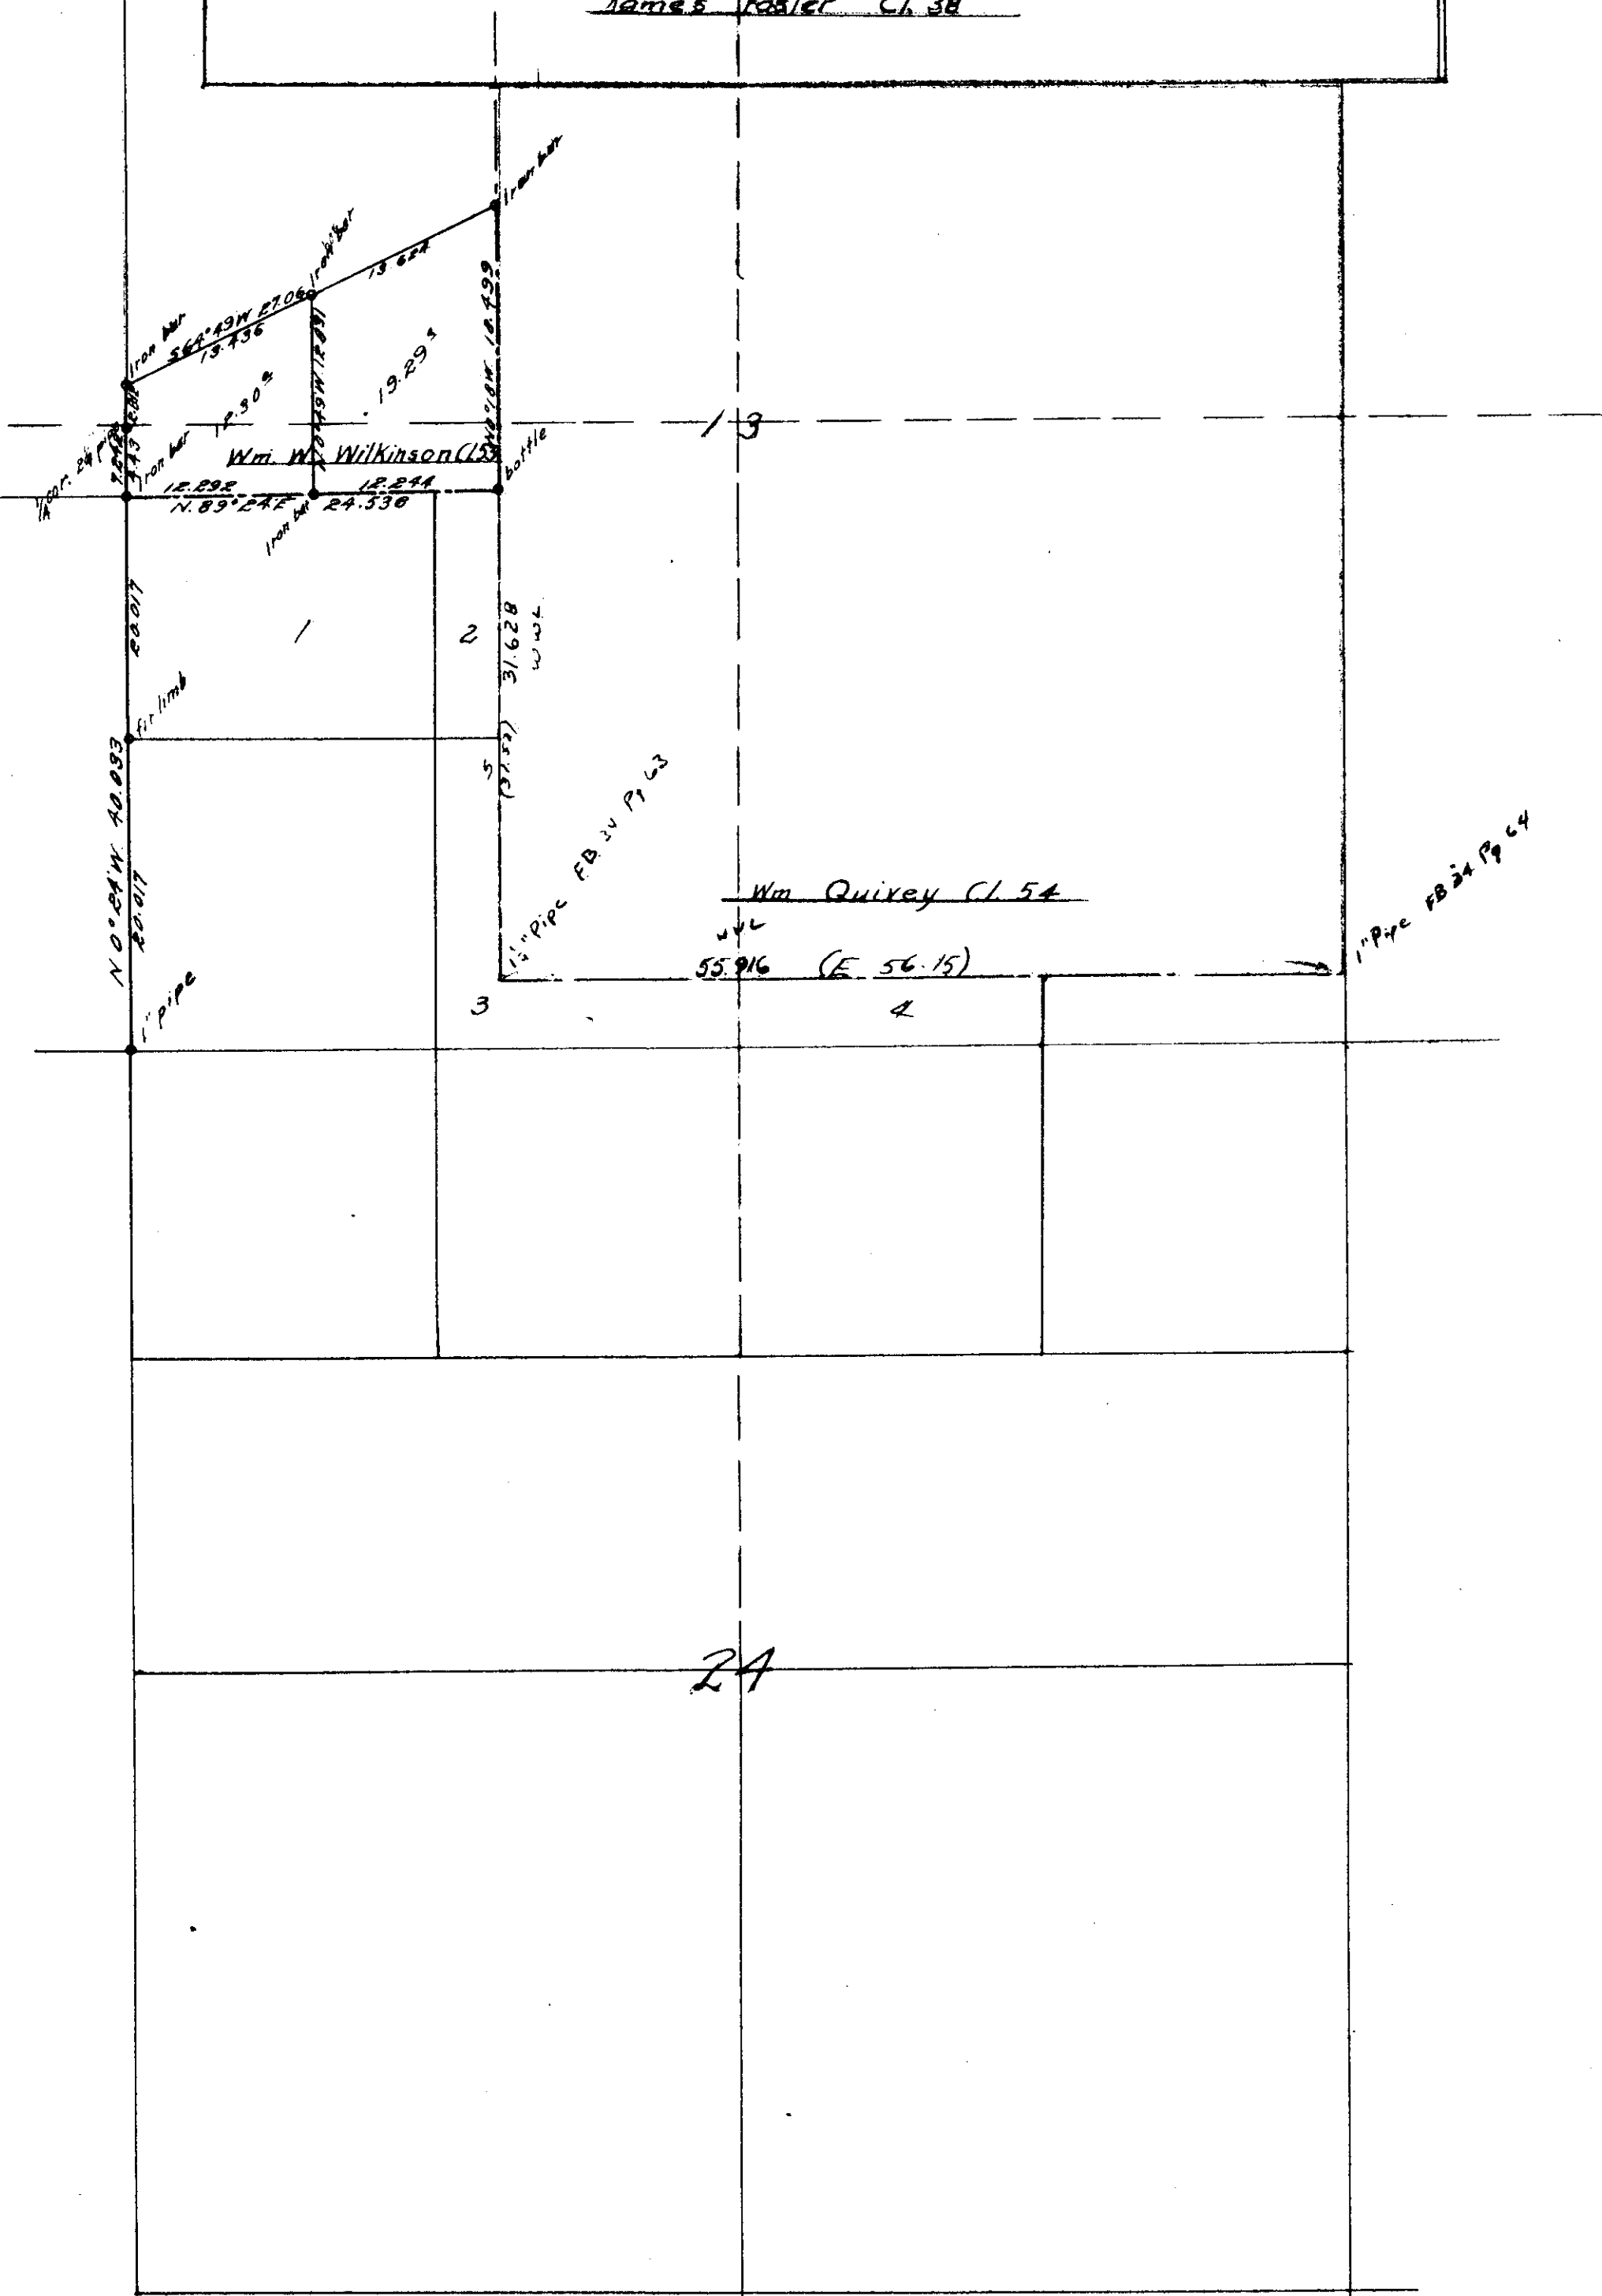

24