


13-7
20-29

00001 C.S. 108
Scale: 1"=300'

20/21

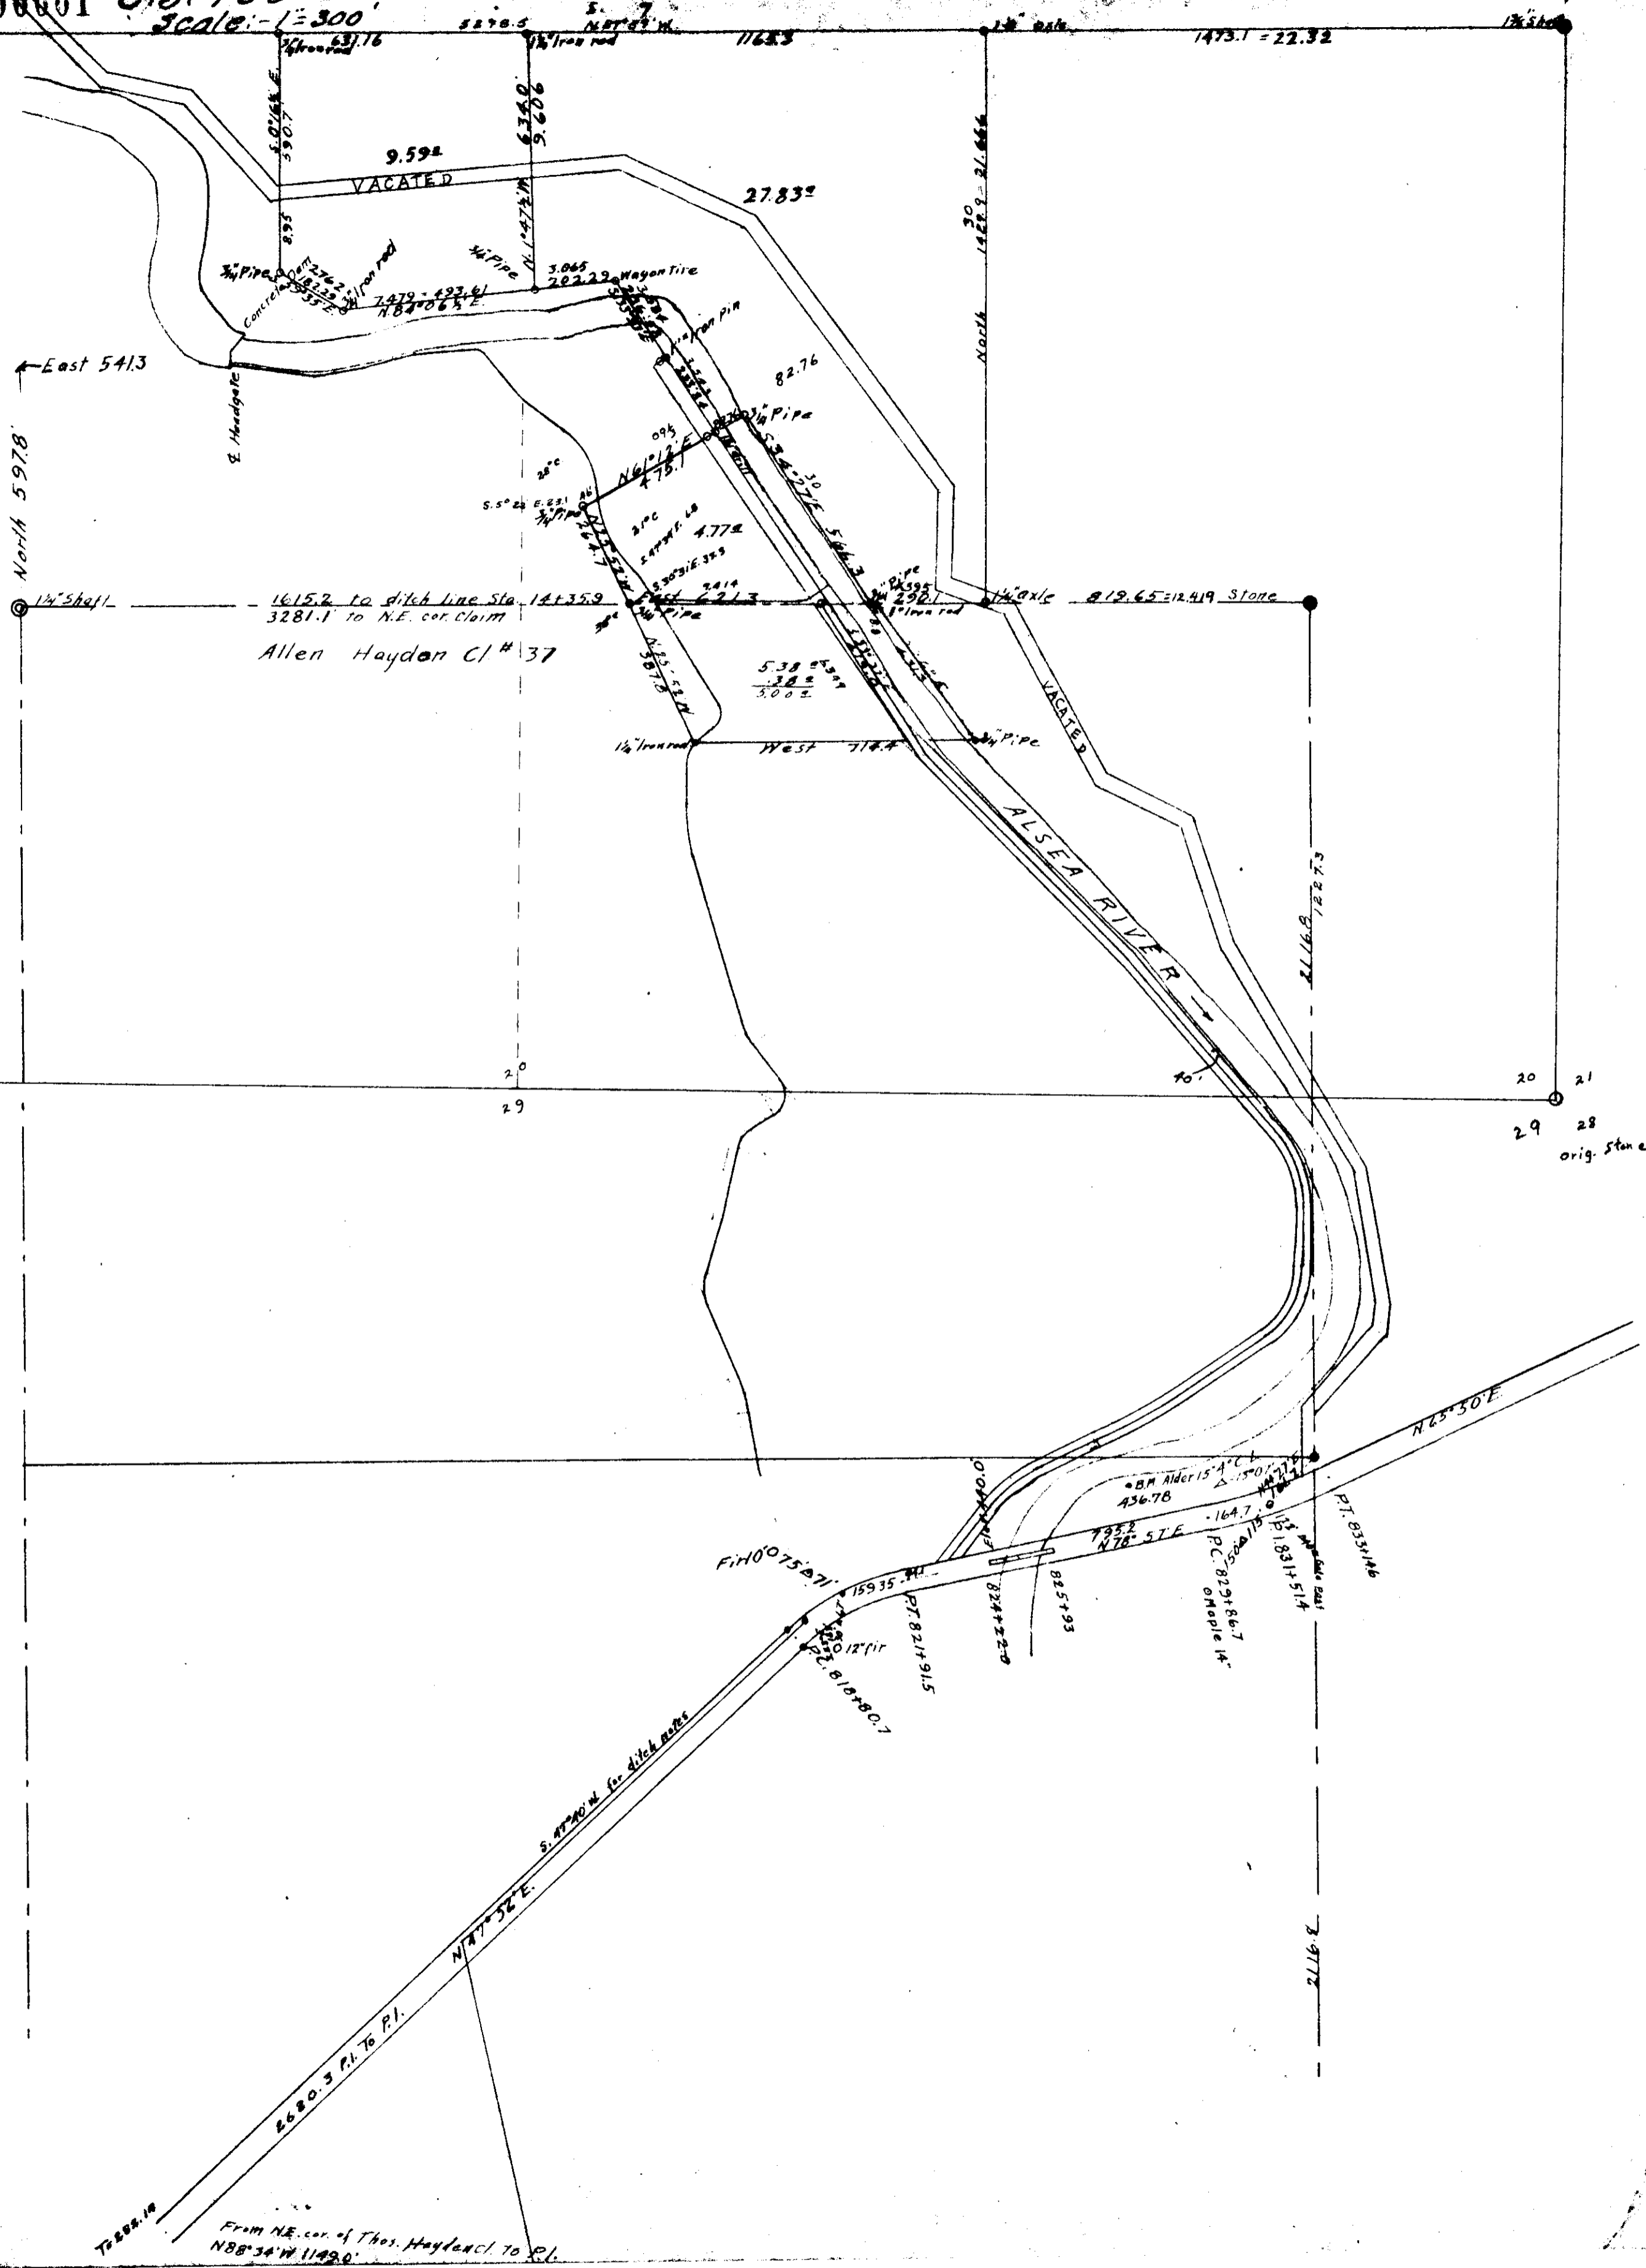

Allen Hayden Cl# 37

20 21
29 28
orig. stone

From NE. cor. of Thos. Haydenl to P.I.
N88°34'W 1142.0'