


14-4
31

00002

C.S. #222 Cont.
Sec. 31-T.14S.R.4 W.W.M.

Scale 1"=600'

W.C. Dalloway C.S.
May to June 1928

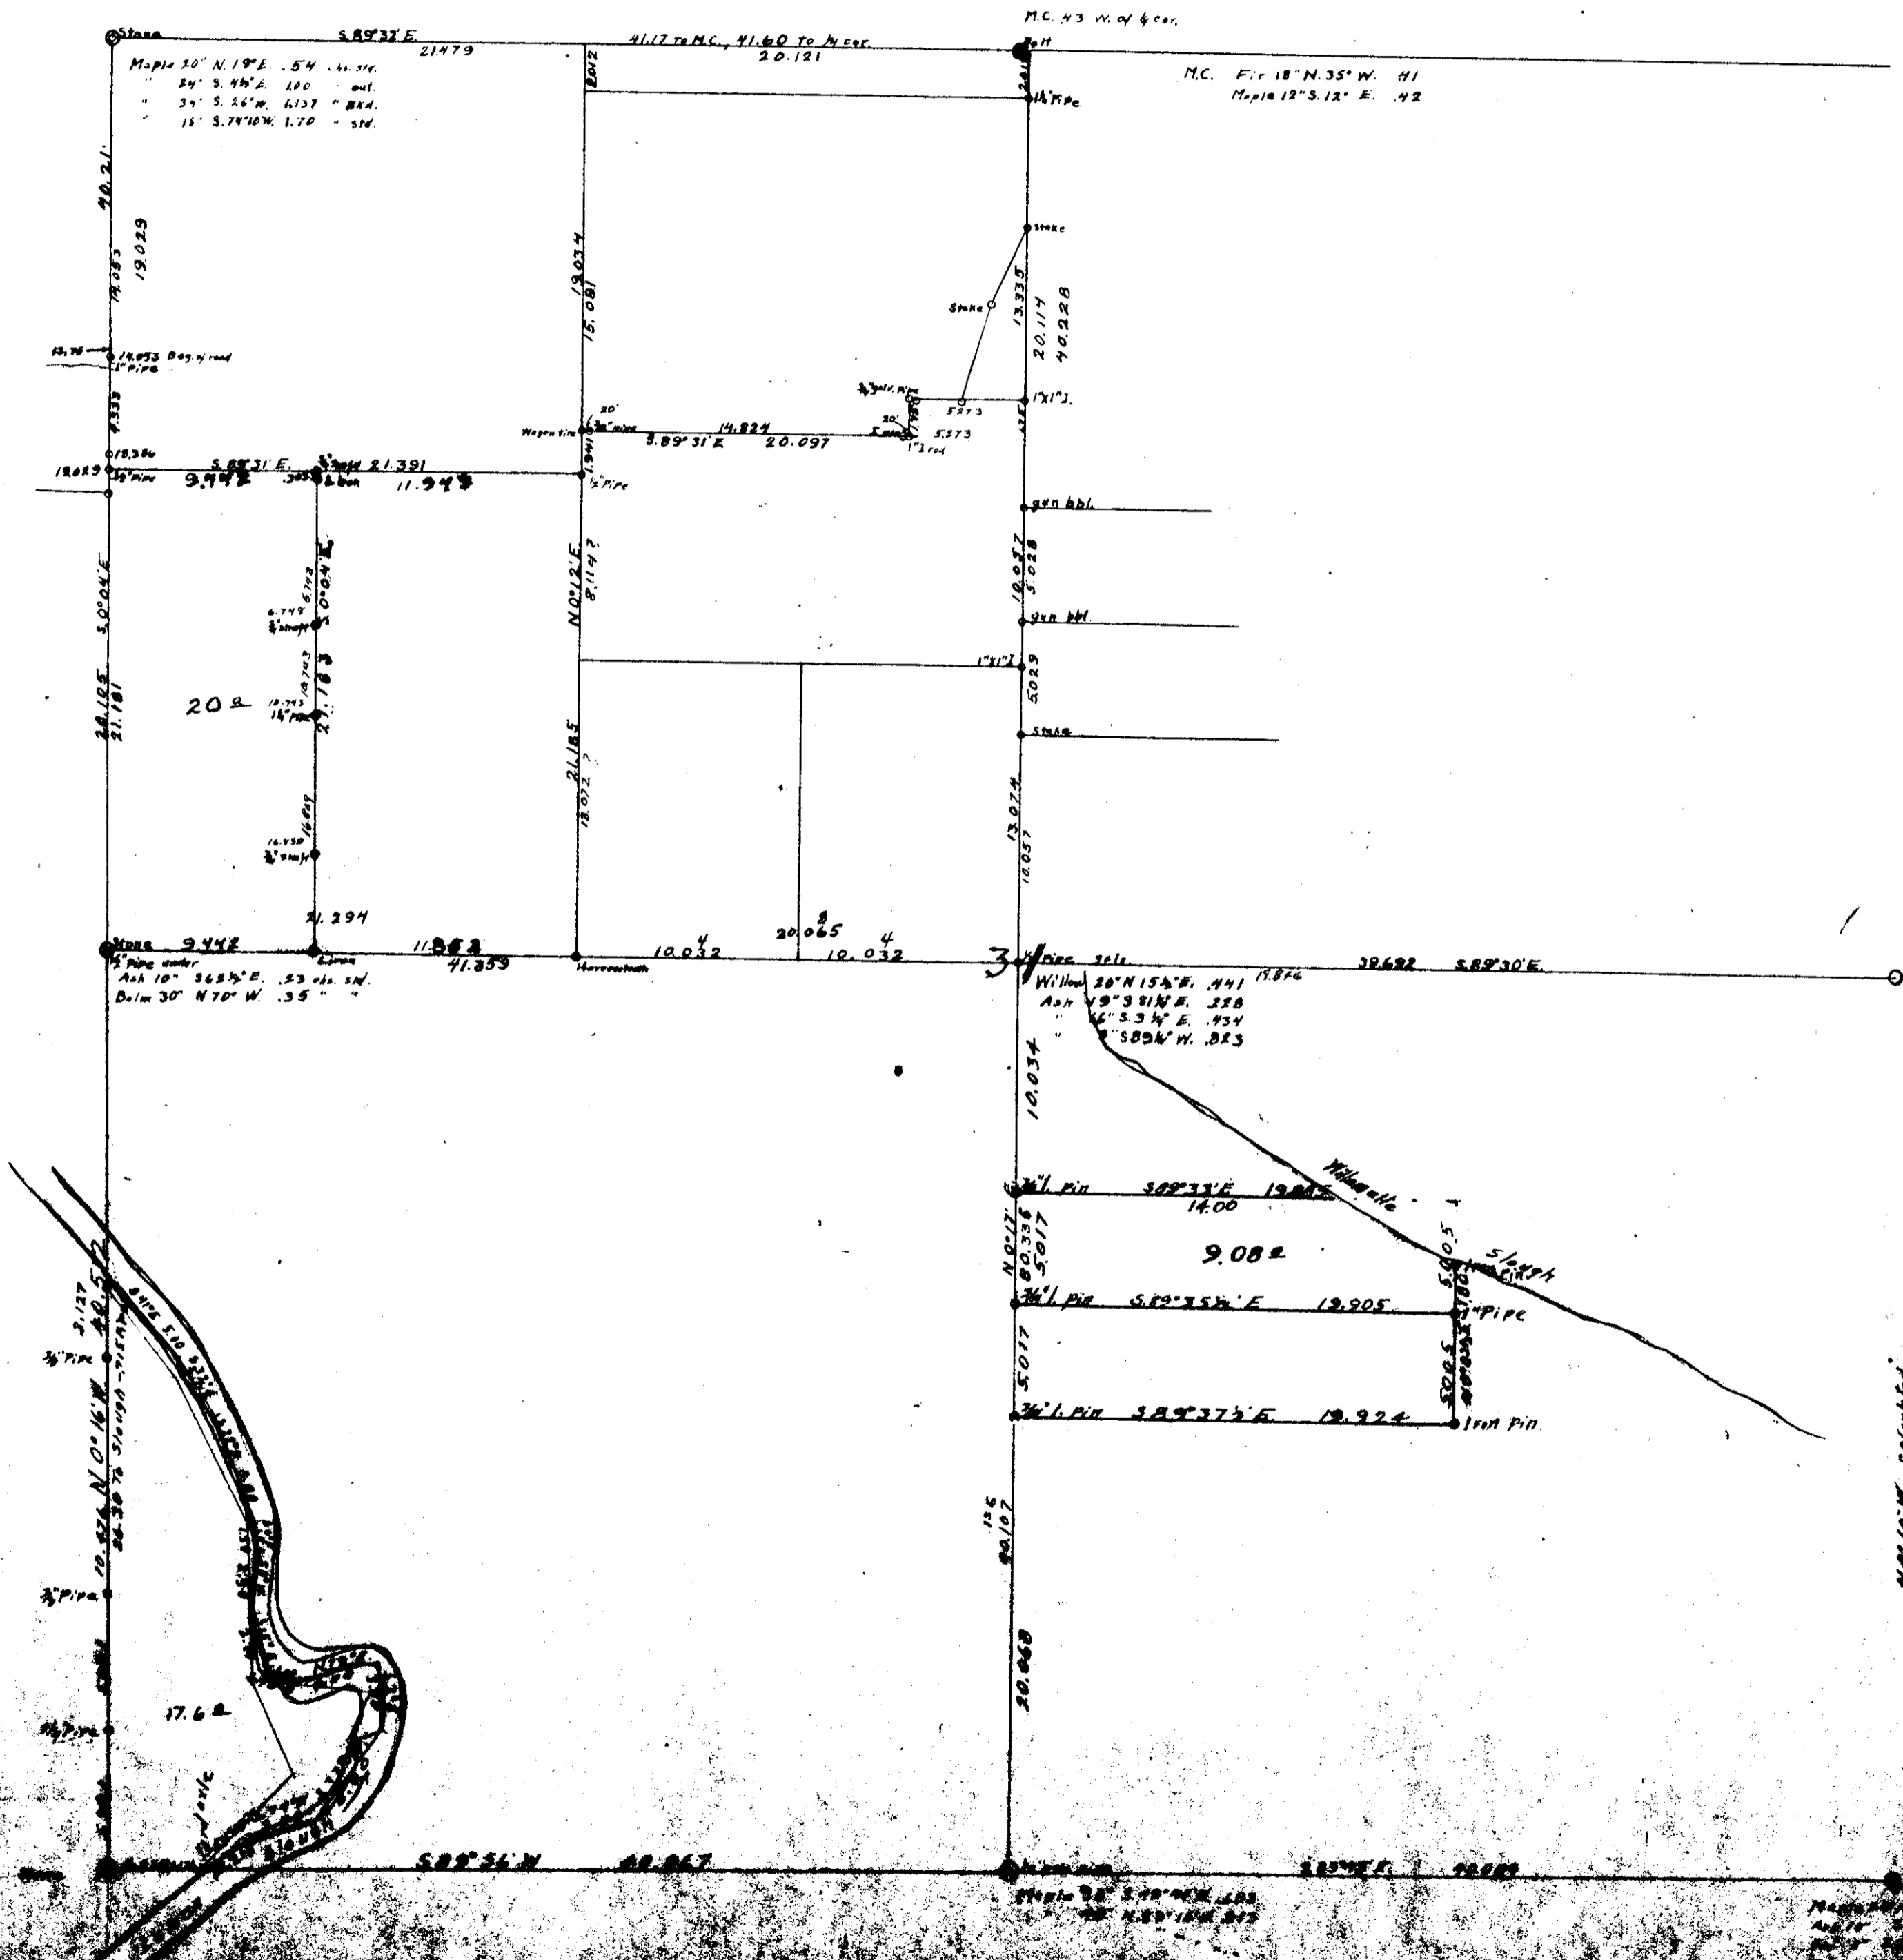

North arrow indicated