


14-5 00004

7

Coll  
Po

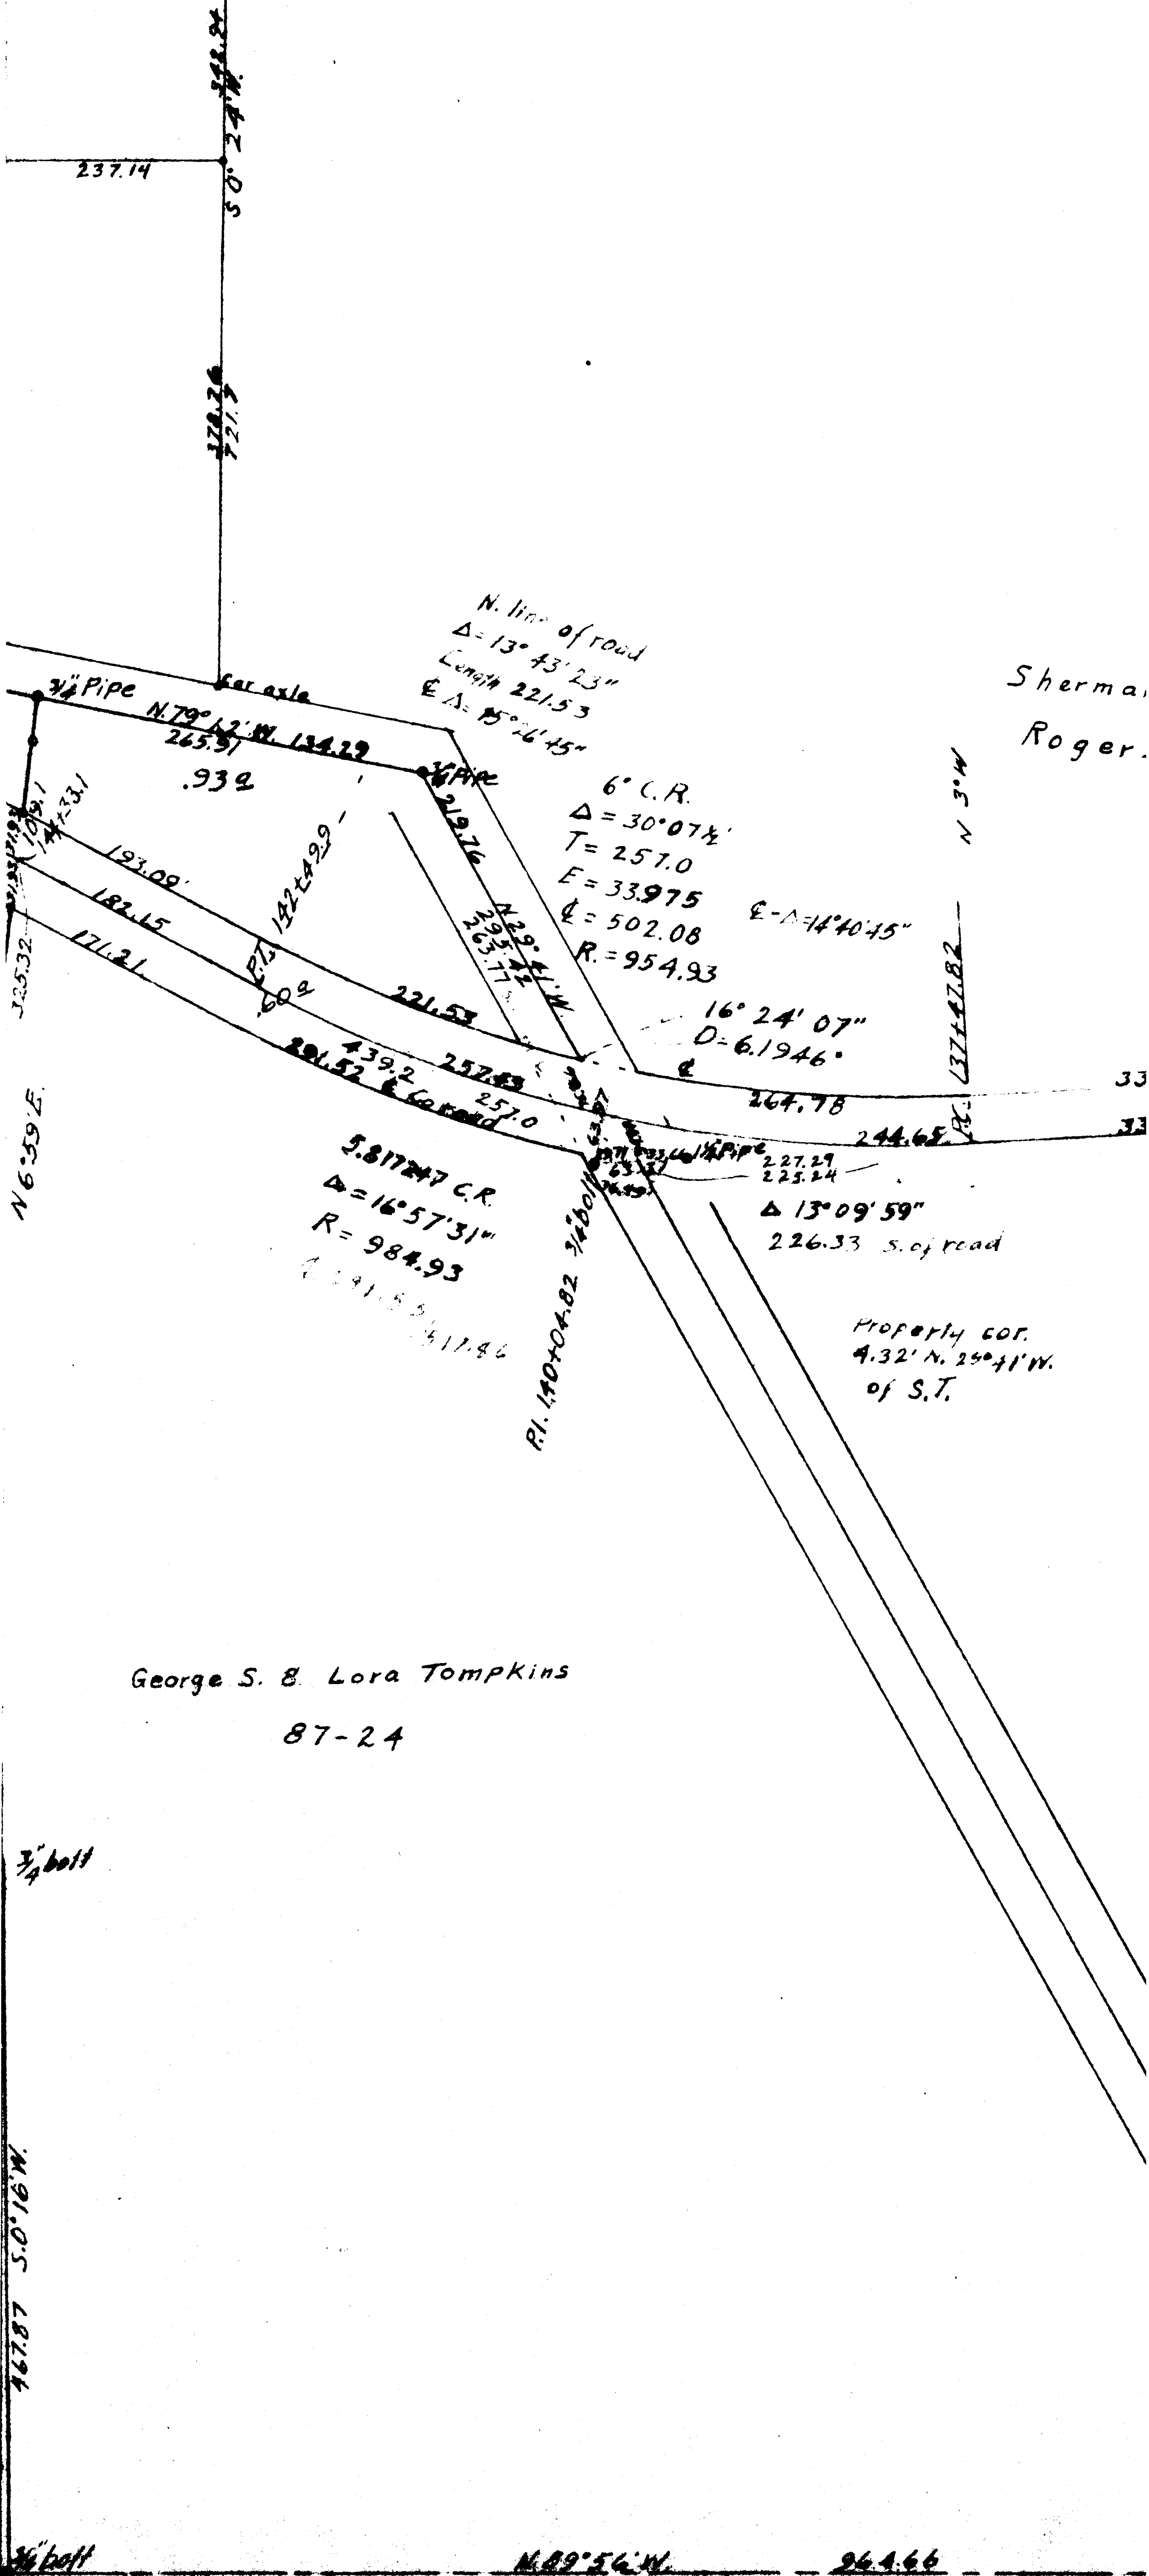

Sherman  
Roger.

George S. & Lora Tompkins

87-24

3/4 bolt

467.87 S. 0° 16' W.

3/4 bolt

N. 89° 56' W.

964.66