


100007
8, 9, 16, 17

63.202
40.705

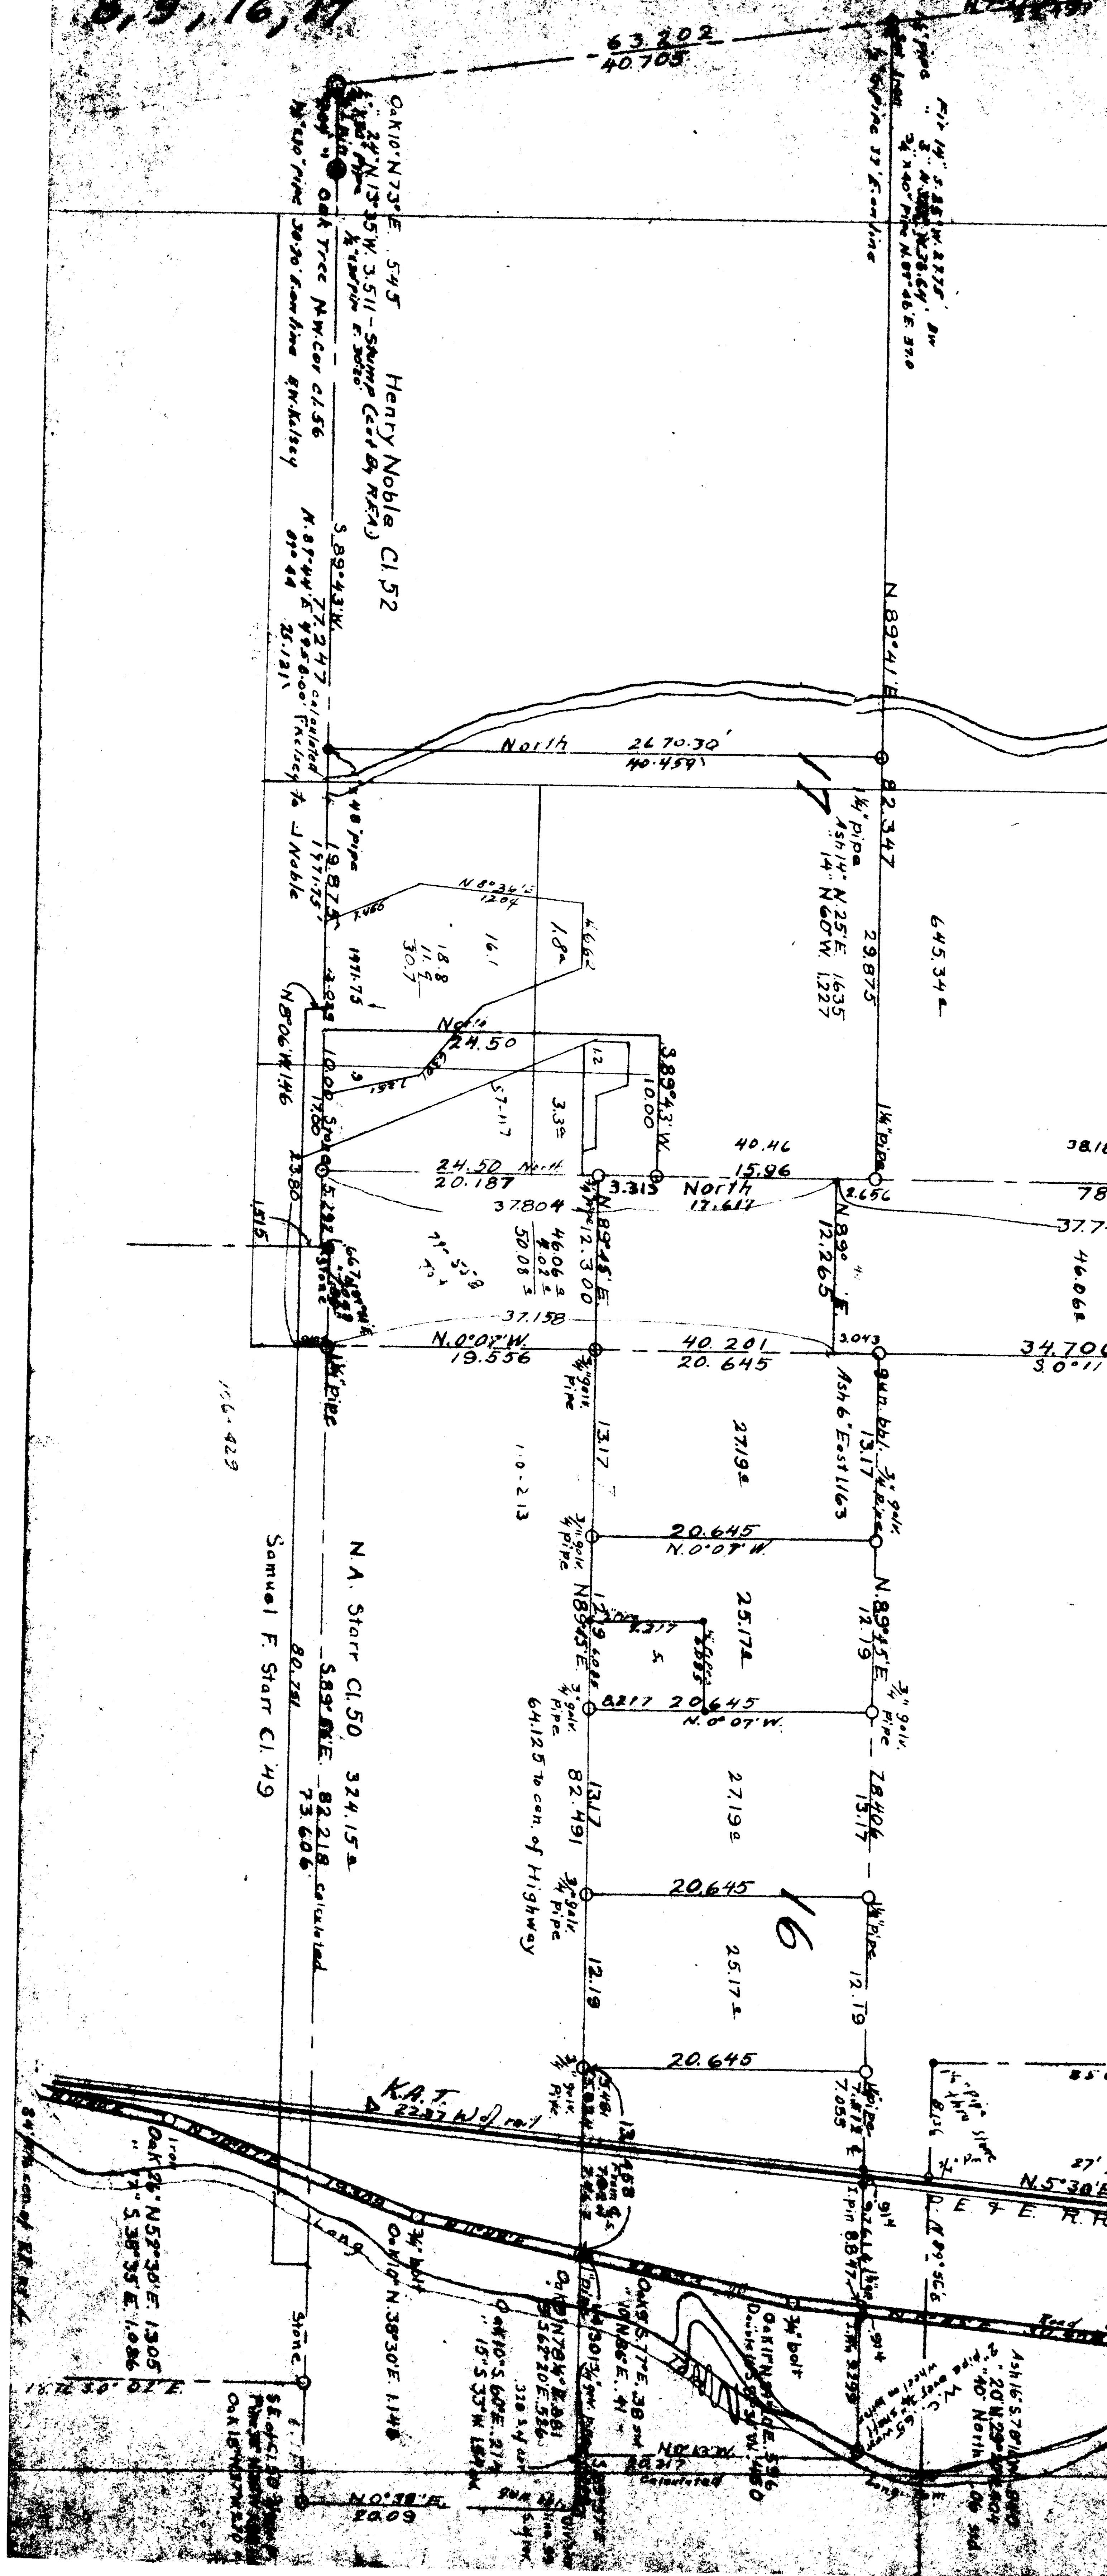

Oak 10' N 73° E 54.5
24' N 13° 35' W 3.511 - stump
Oak 10' N 73° E 54.5
Henry Noble Cl 52
Oak 10' N 73° E 54.5
Oak 10' N 73° E 54.5
Oak 10' N 73° E 54.5

N.A. Starr Cl 50 324.15
Samuel F. Starr Cl 49
Oak 10' N 73° E 54.5
Oak 10' N 73° E 54.5
Oak 10' N 73° E 54.5

OAK 10' N 73° E 54.5
OAK 10' N 73° E 54.5
