


MONROE
14-5 00024
33

SCALE 1"=3 CHAINS

C. S. 160

7.072 E. RR
7.25 div. in walk
6.34 fence S.
5.59 bet. water meters
4.8175 div. in walk E. of Ch. road
3.53 Stake N.W. Church lot
3.25 to W of road

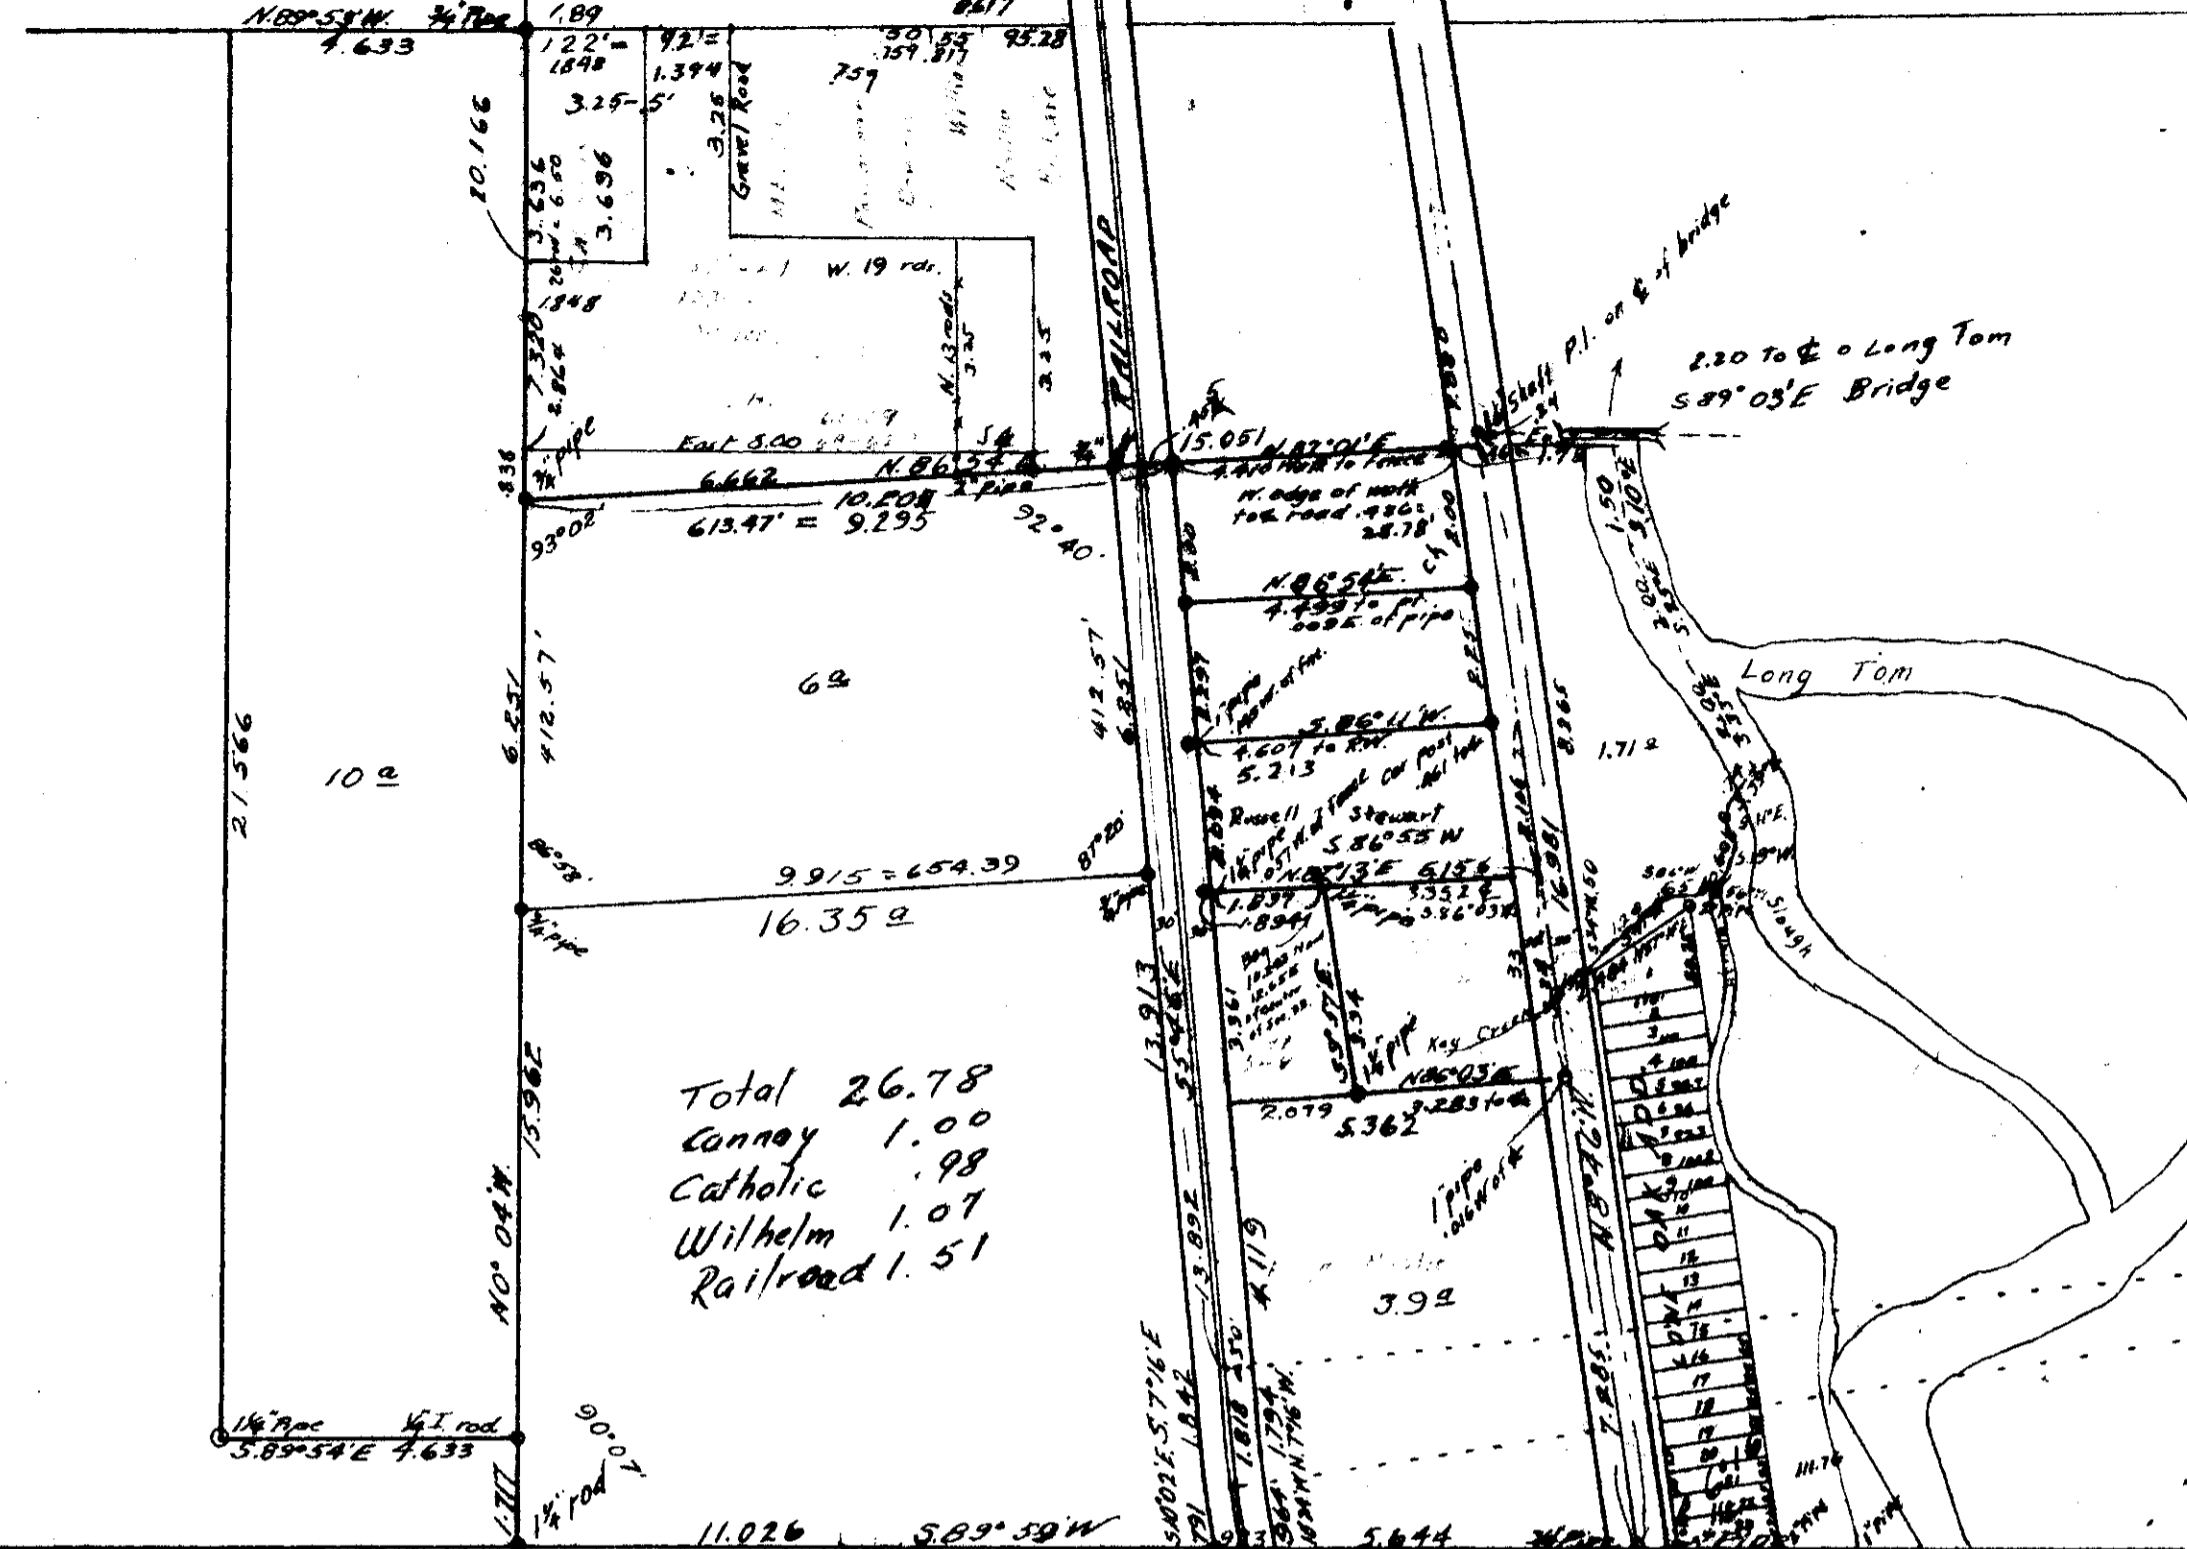

Center of sec. 33

Pipe
Pipe
Pipe

TERRITORIAL ROAD

4-45°17' & 39°17'
5° C.L.
L=705.7
T=530.2-8.155
R=106.28