


14-0 00001  
12/11/12

# COUNTY SURVEY

SCALE 1" = 40 FEET

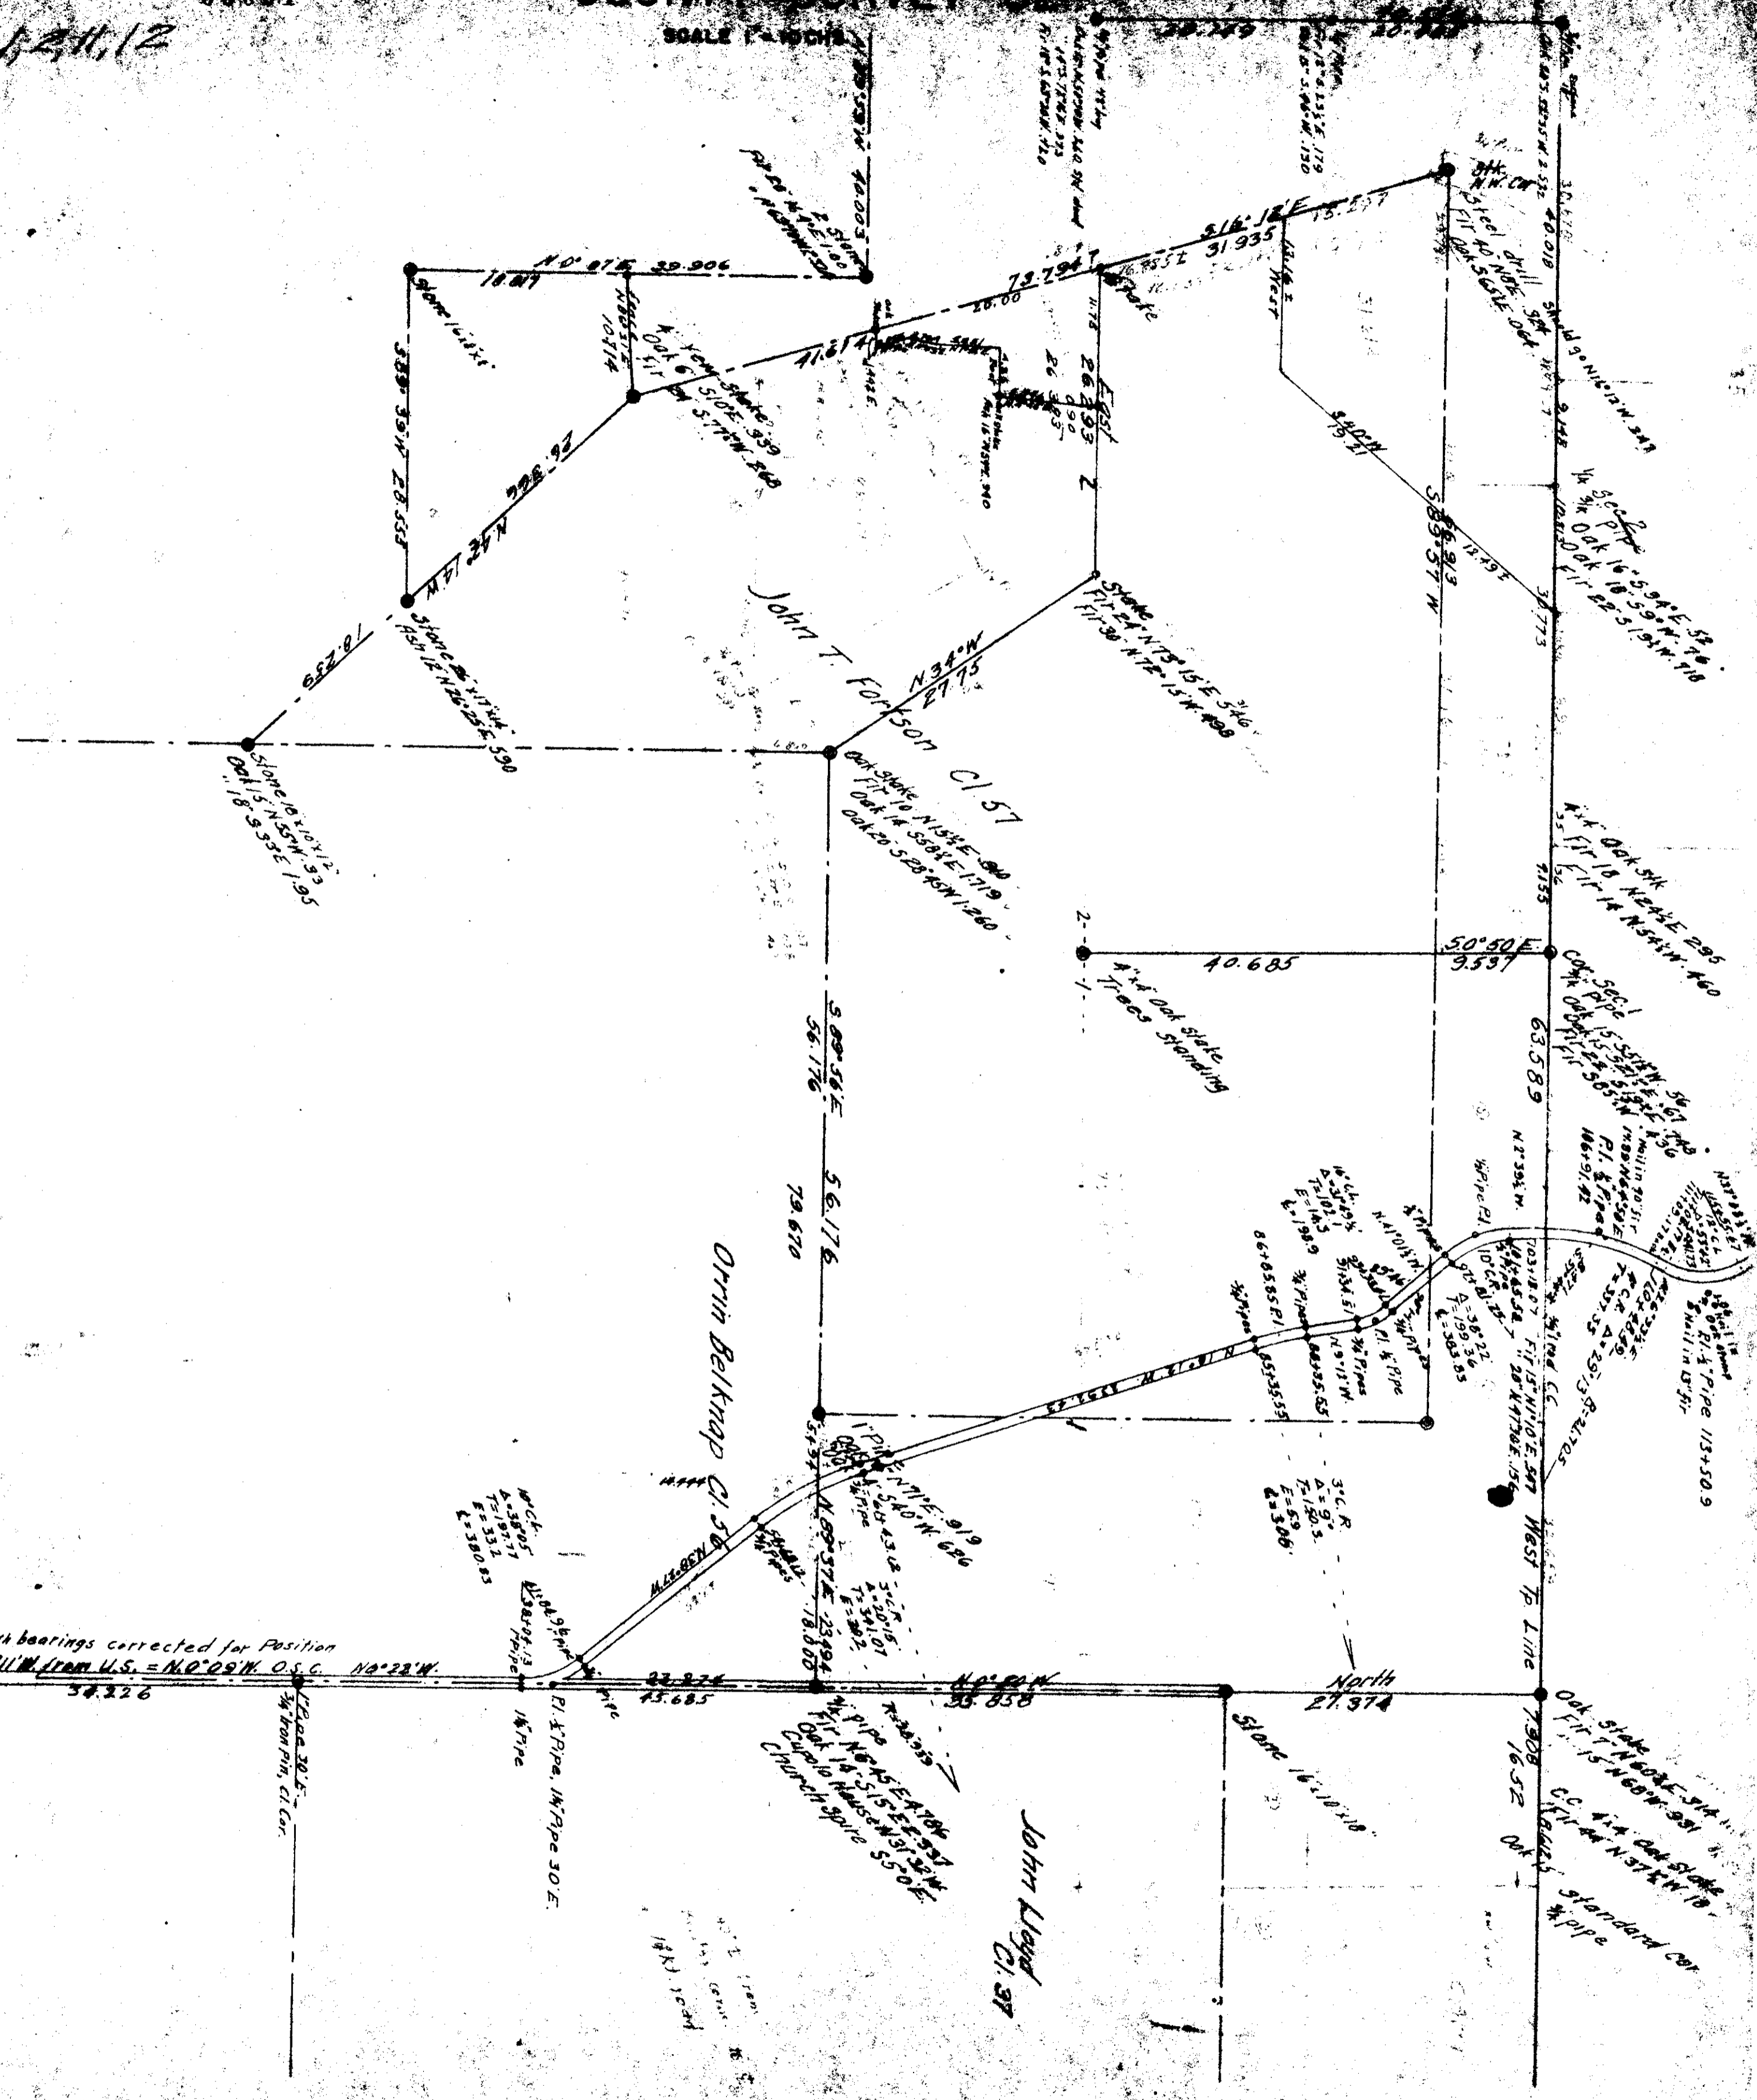

Both bearings corrected for Position  
N 0° 11' W from U.S. = N 0° 09' W O.S.C. N 0° 22' W

North  
27.974

John Lloyd  
C1.97

Orrin Belknap  
C1.58

John T. Fordson  
C1.57