


COUNTY SURVEY

00002

SCALE 1"=10CHS

14-0
1, 2, 15, 12

K.A. 1

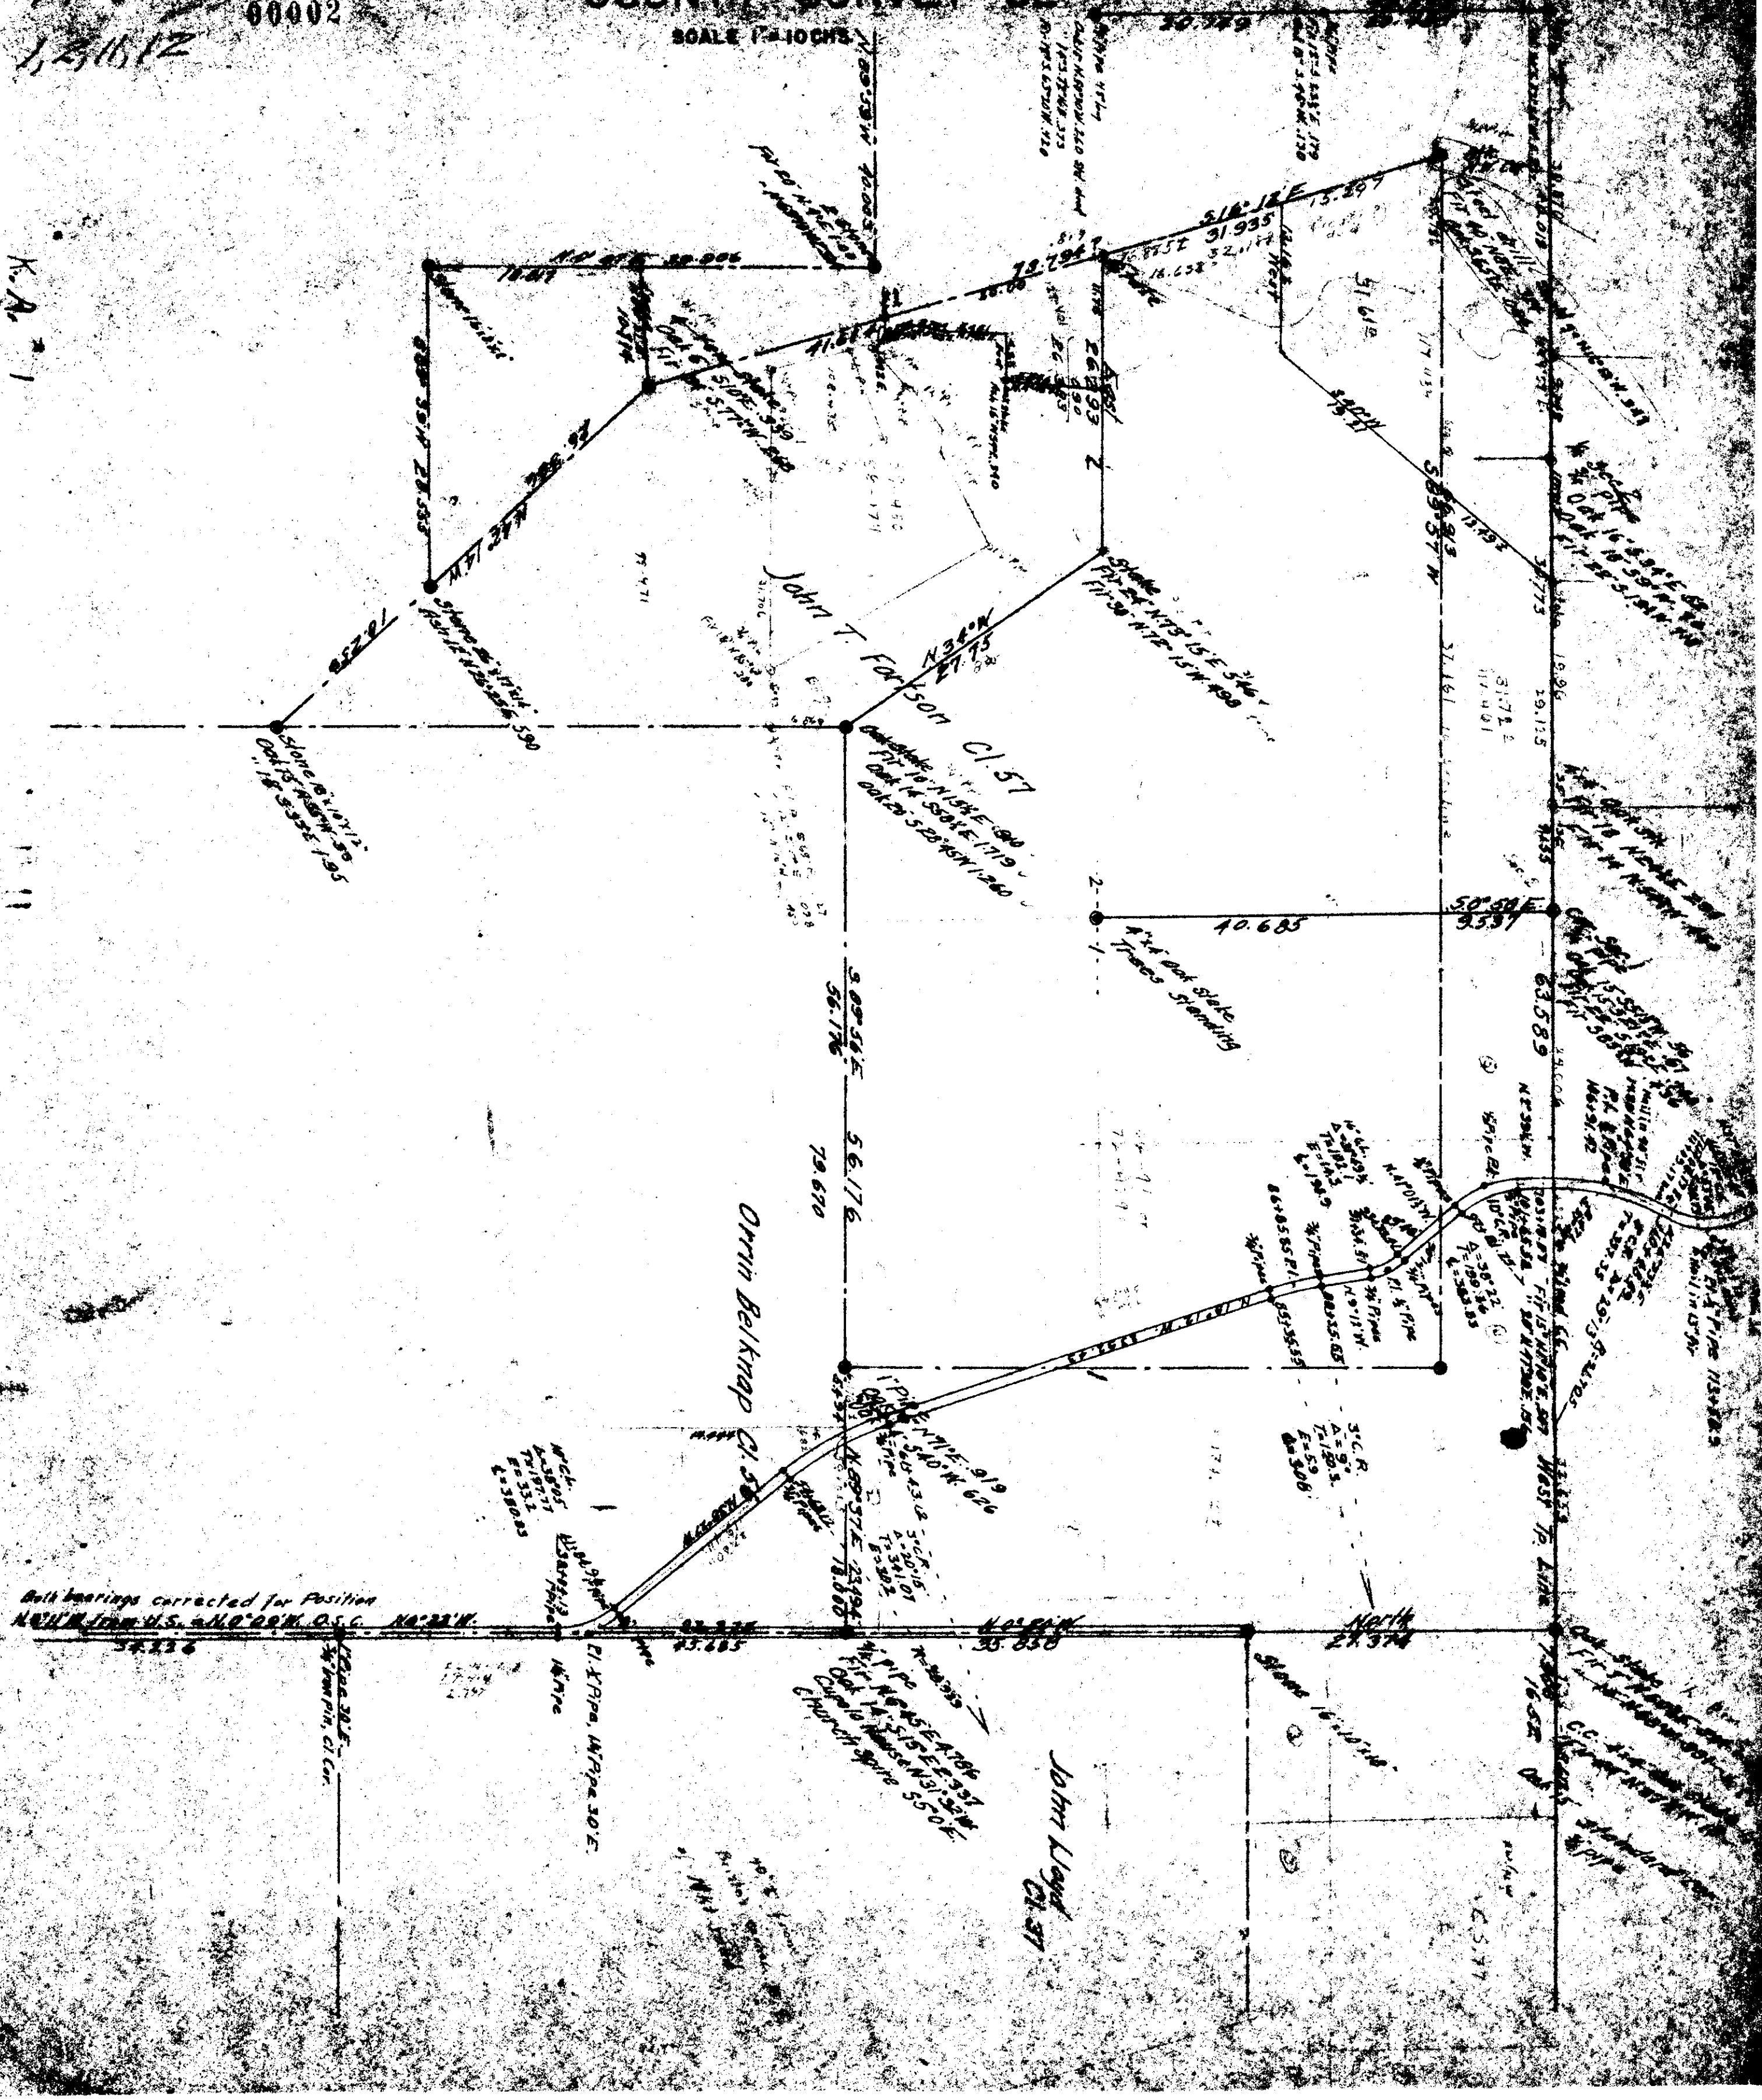

All bearings corrected for Position
N 36° 00' E, S 16° 12' E, etc.