


COUNTY SURVEY # 82

SCALE 1" = 10 CHS.

14-6
1, 2, 11, 12

00003

K. A. # 2

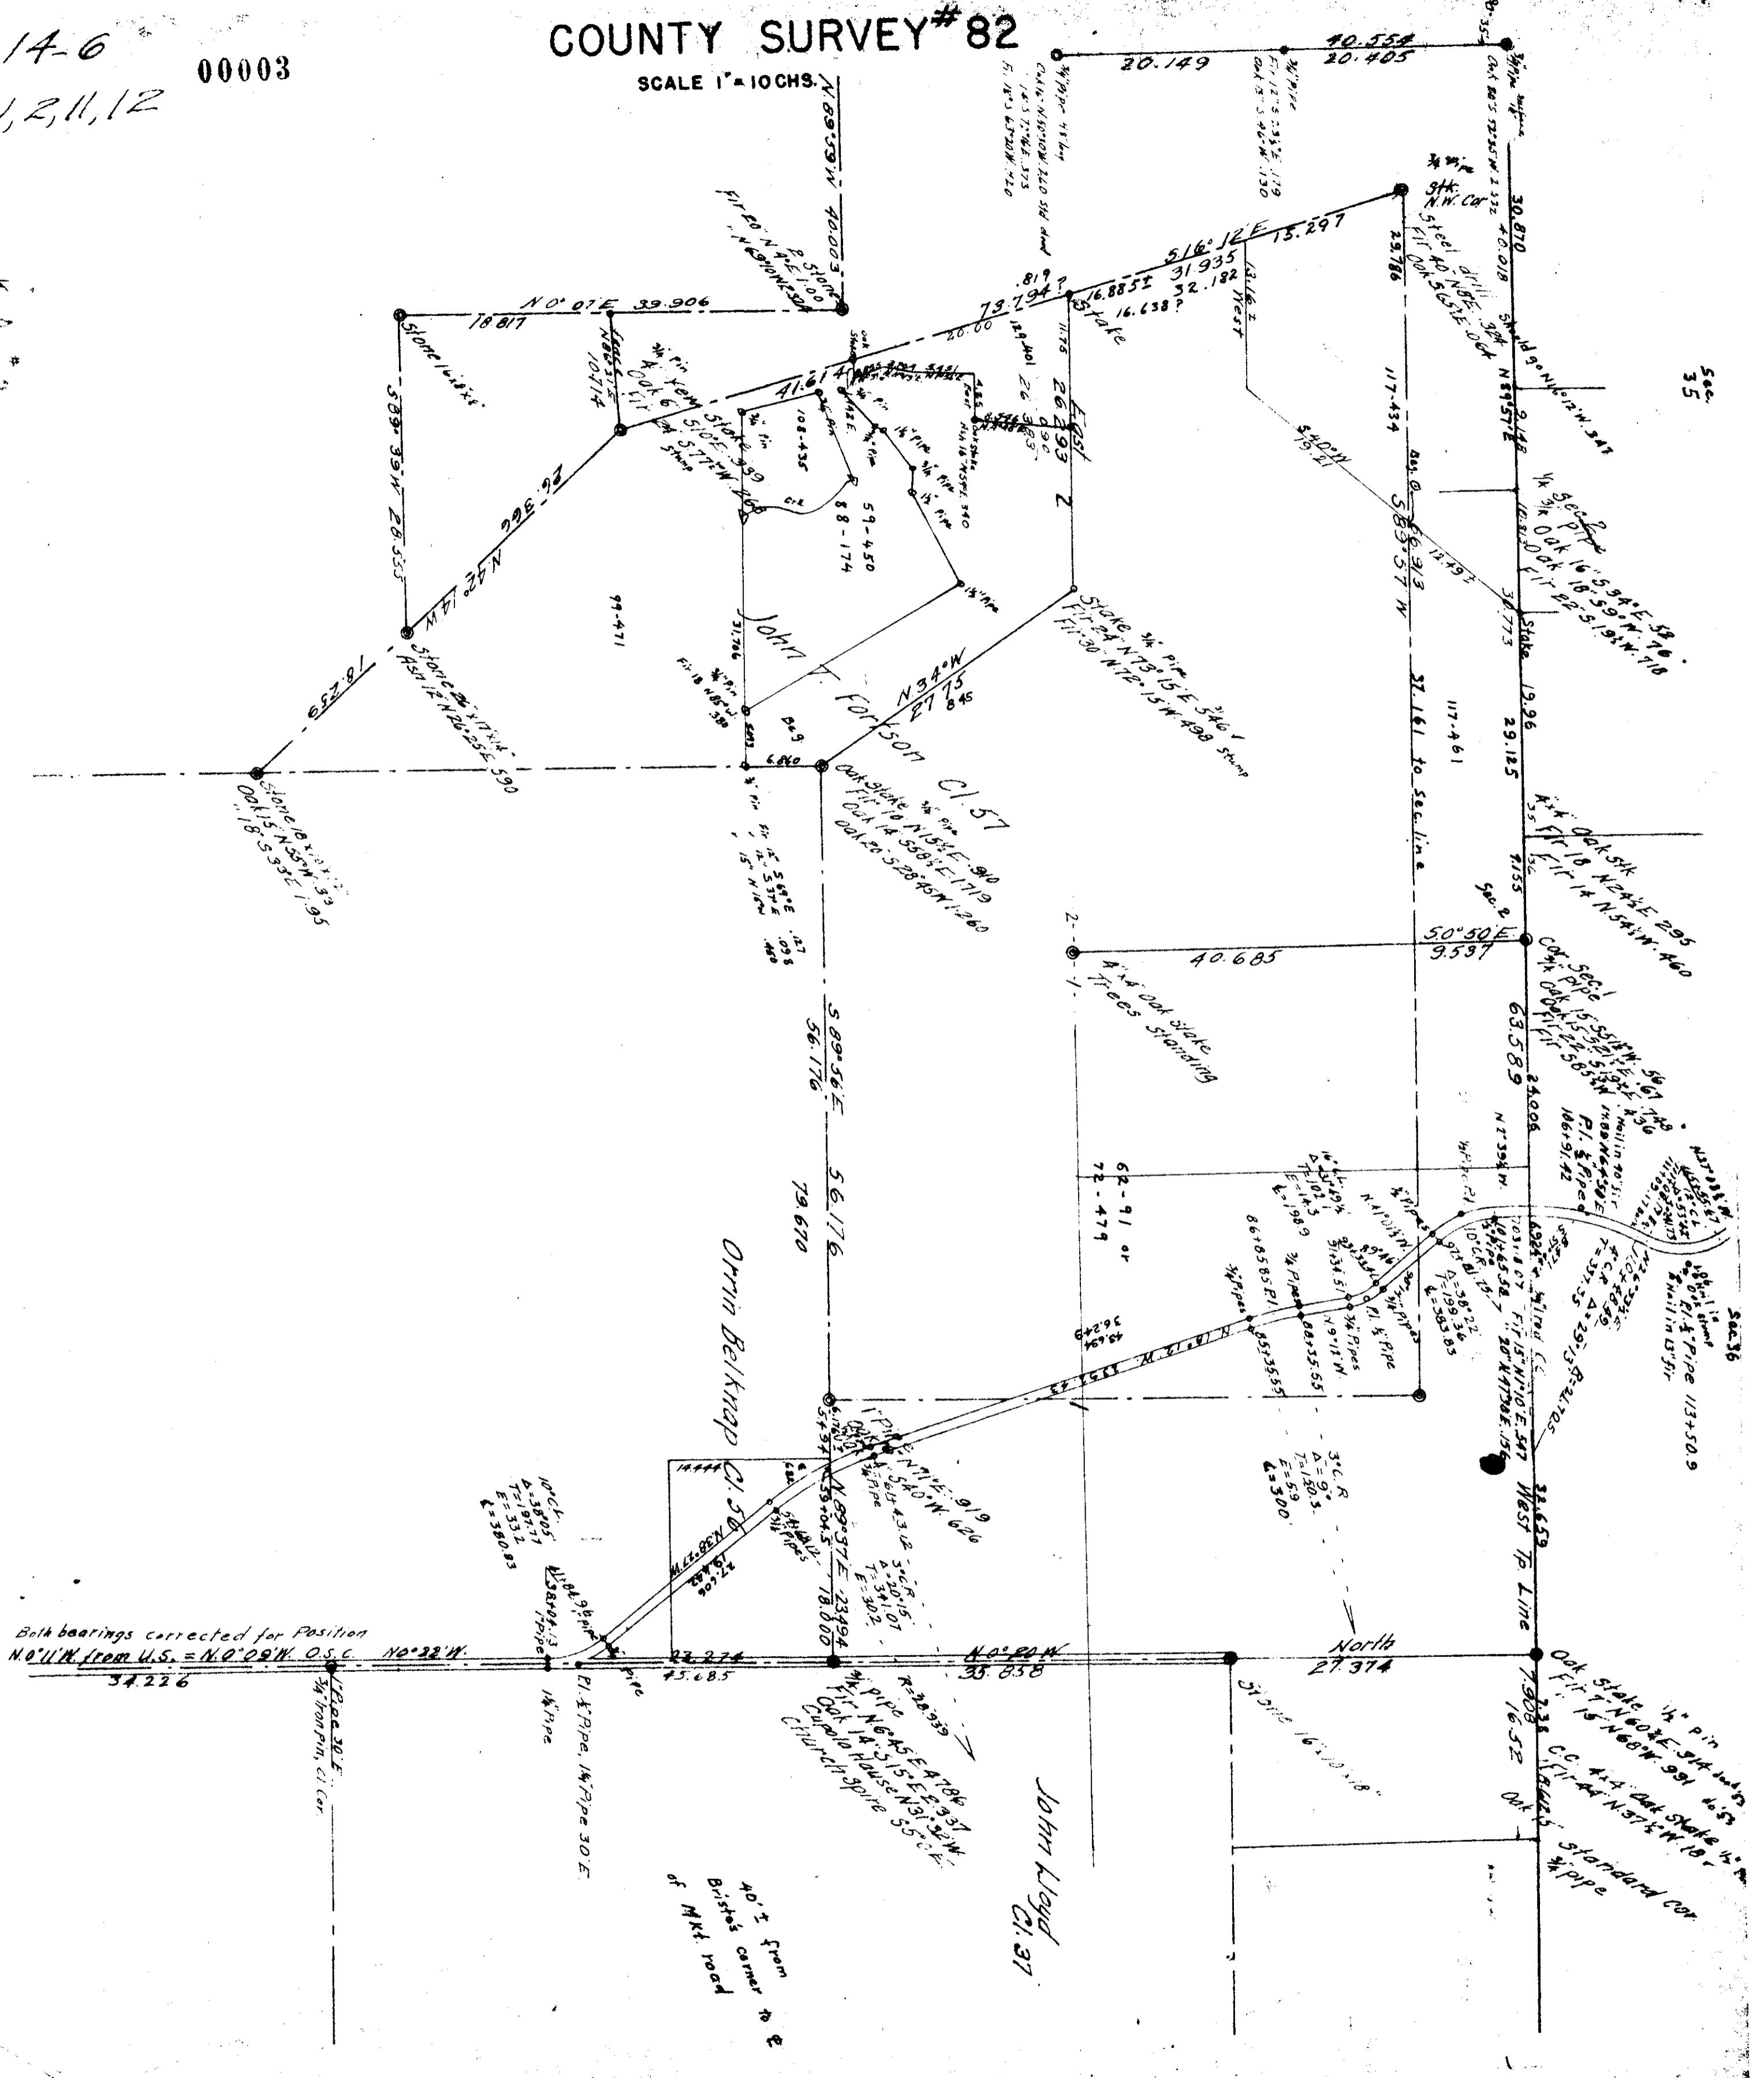

Both bearings corrected for Position
 N 0° 11' W from U.S. = N 0° 00' W O.S.C. N 0° 32' W.

40 ± from
 British corner to E
 of Mt. road

John Lloyd
 Cl. 37

Sec.
 35

Sec.
 36

standard cor.
 3/4 pipe