


19-6 00010  
33, 34

C.S. 307

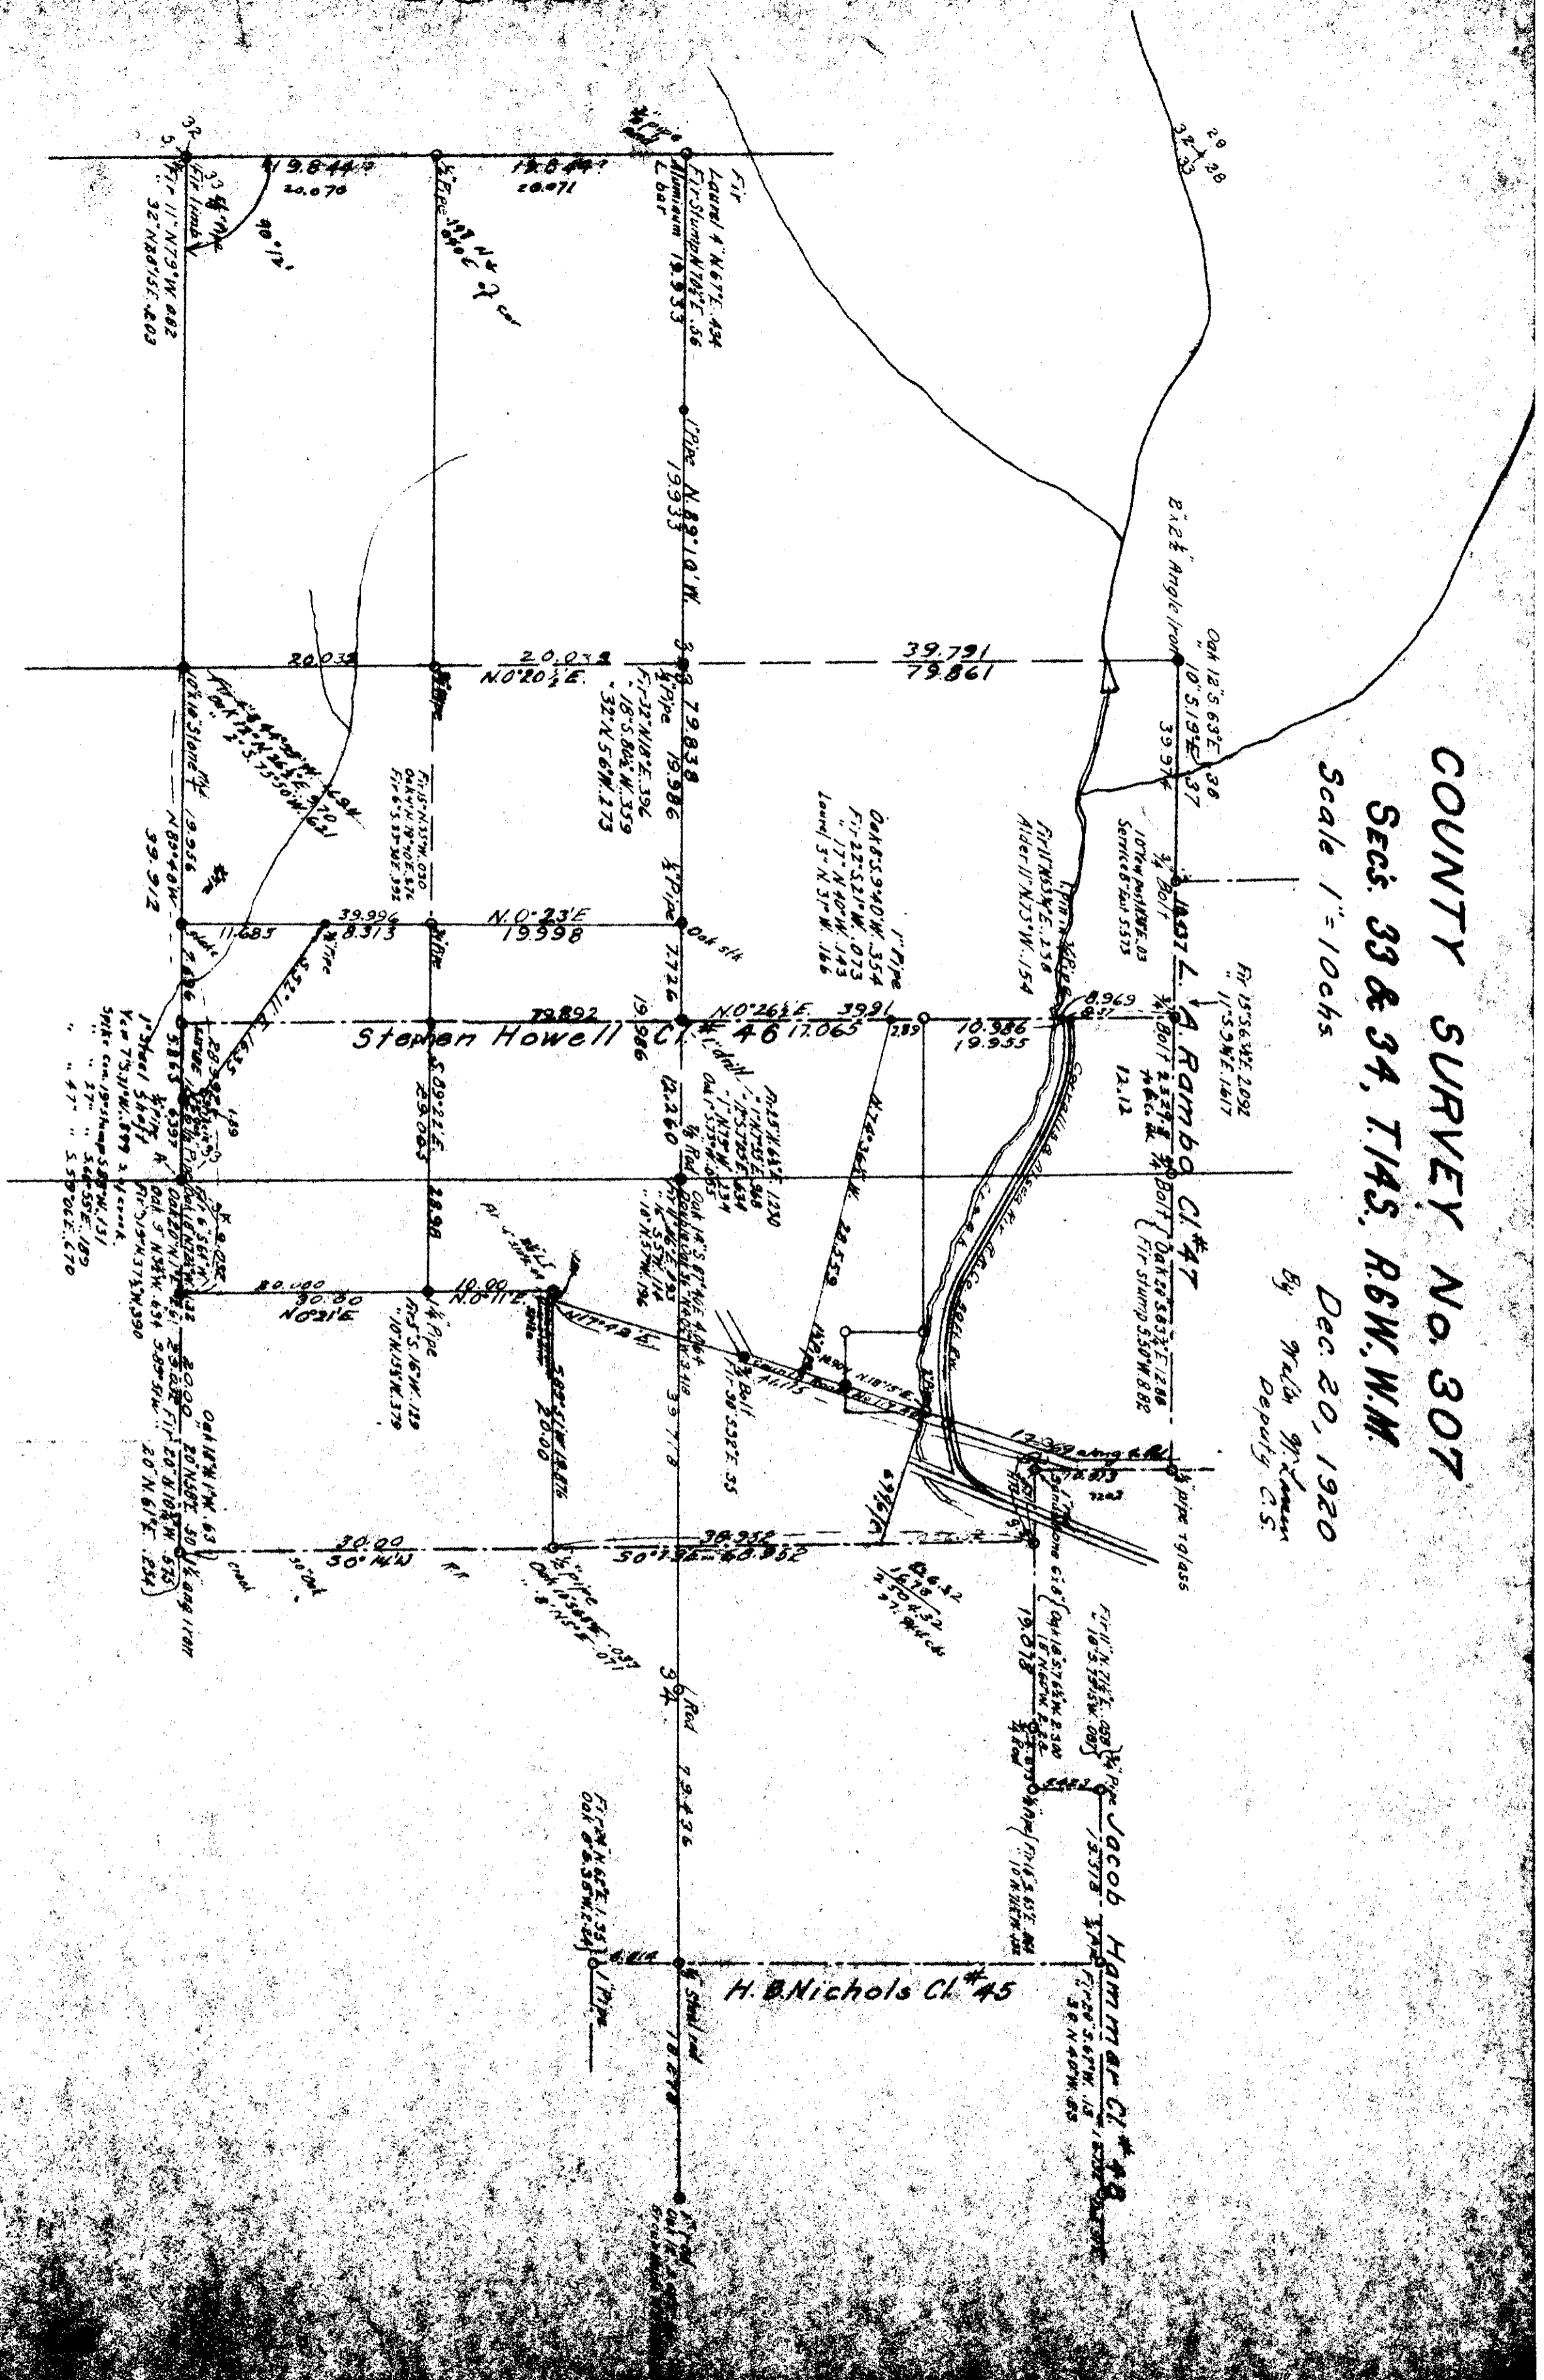

**COUNTY SURVEY NO. 307**  
**SECS. 33 & 34, T.14S, R.6W, W.M.**  
 Scale 1"=100hs

Dec 20, 1920  
 By *W. L. Jones*  
 Deputy C.S.