


14-6-#00022
 9-10-16 C.S. 336
 SCALE 1"=400'

CORVALLIS LOGGING CO. R.R.
 DAWSON SHEET

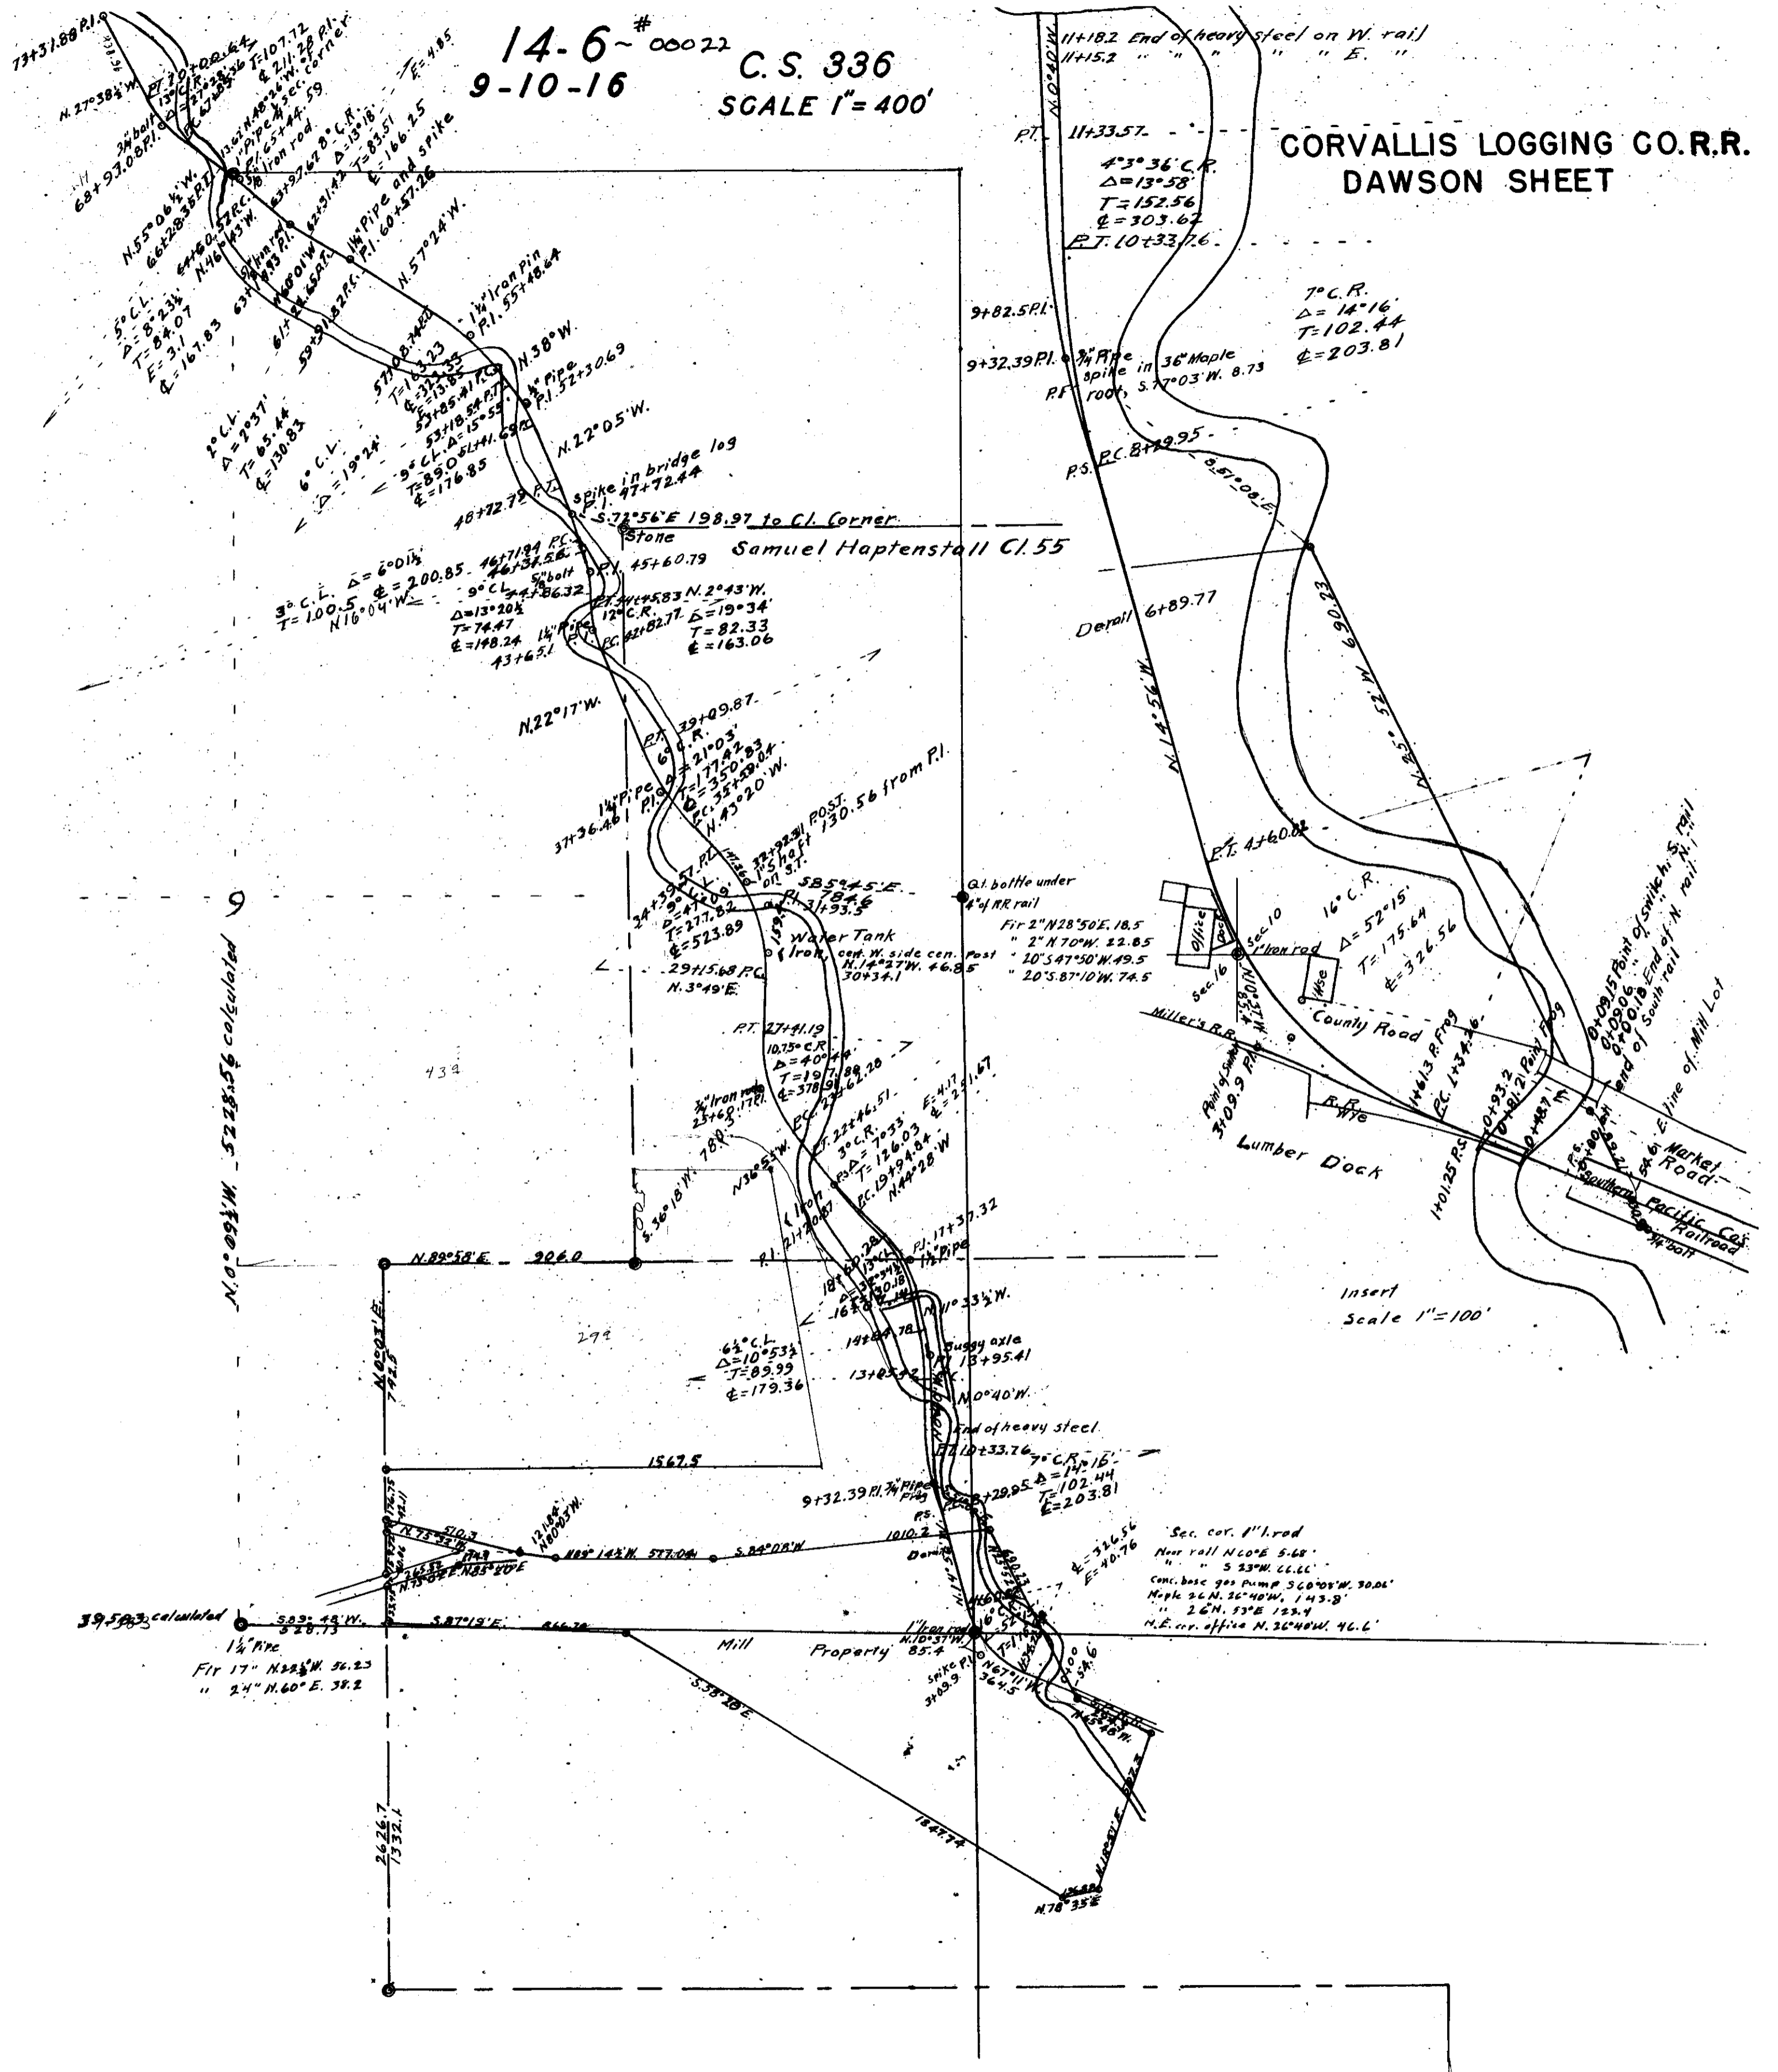

N. 0° 09 1/2 W. - 5228.56 calculated

39,583 calculated
 1 1/2 R.R.
 Fir 17" N 22 1/2 W. 56.25
 " 24" N 60 E. 38.2

Insert
 Scale 1"=100'

Sec. cor. 1" rod
 Near rail N 60 E 5.68'
 " " 5 33 W. 66.66'
 Conc. base gas pump 50' 00" W. 30.00'
 Maple 26" N. 26 40 W. 143.8'
 " 26" N. 53 E. 123.4'
 H.E. corr. office N. 26 40 W. 46.6'