


14-B
1,2 00001

C 5 127

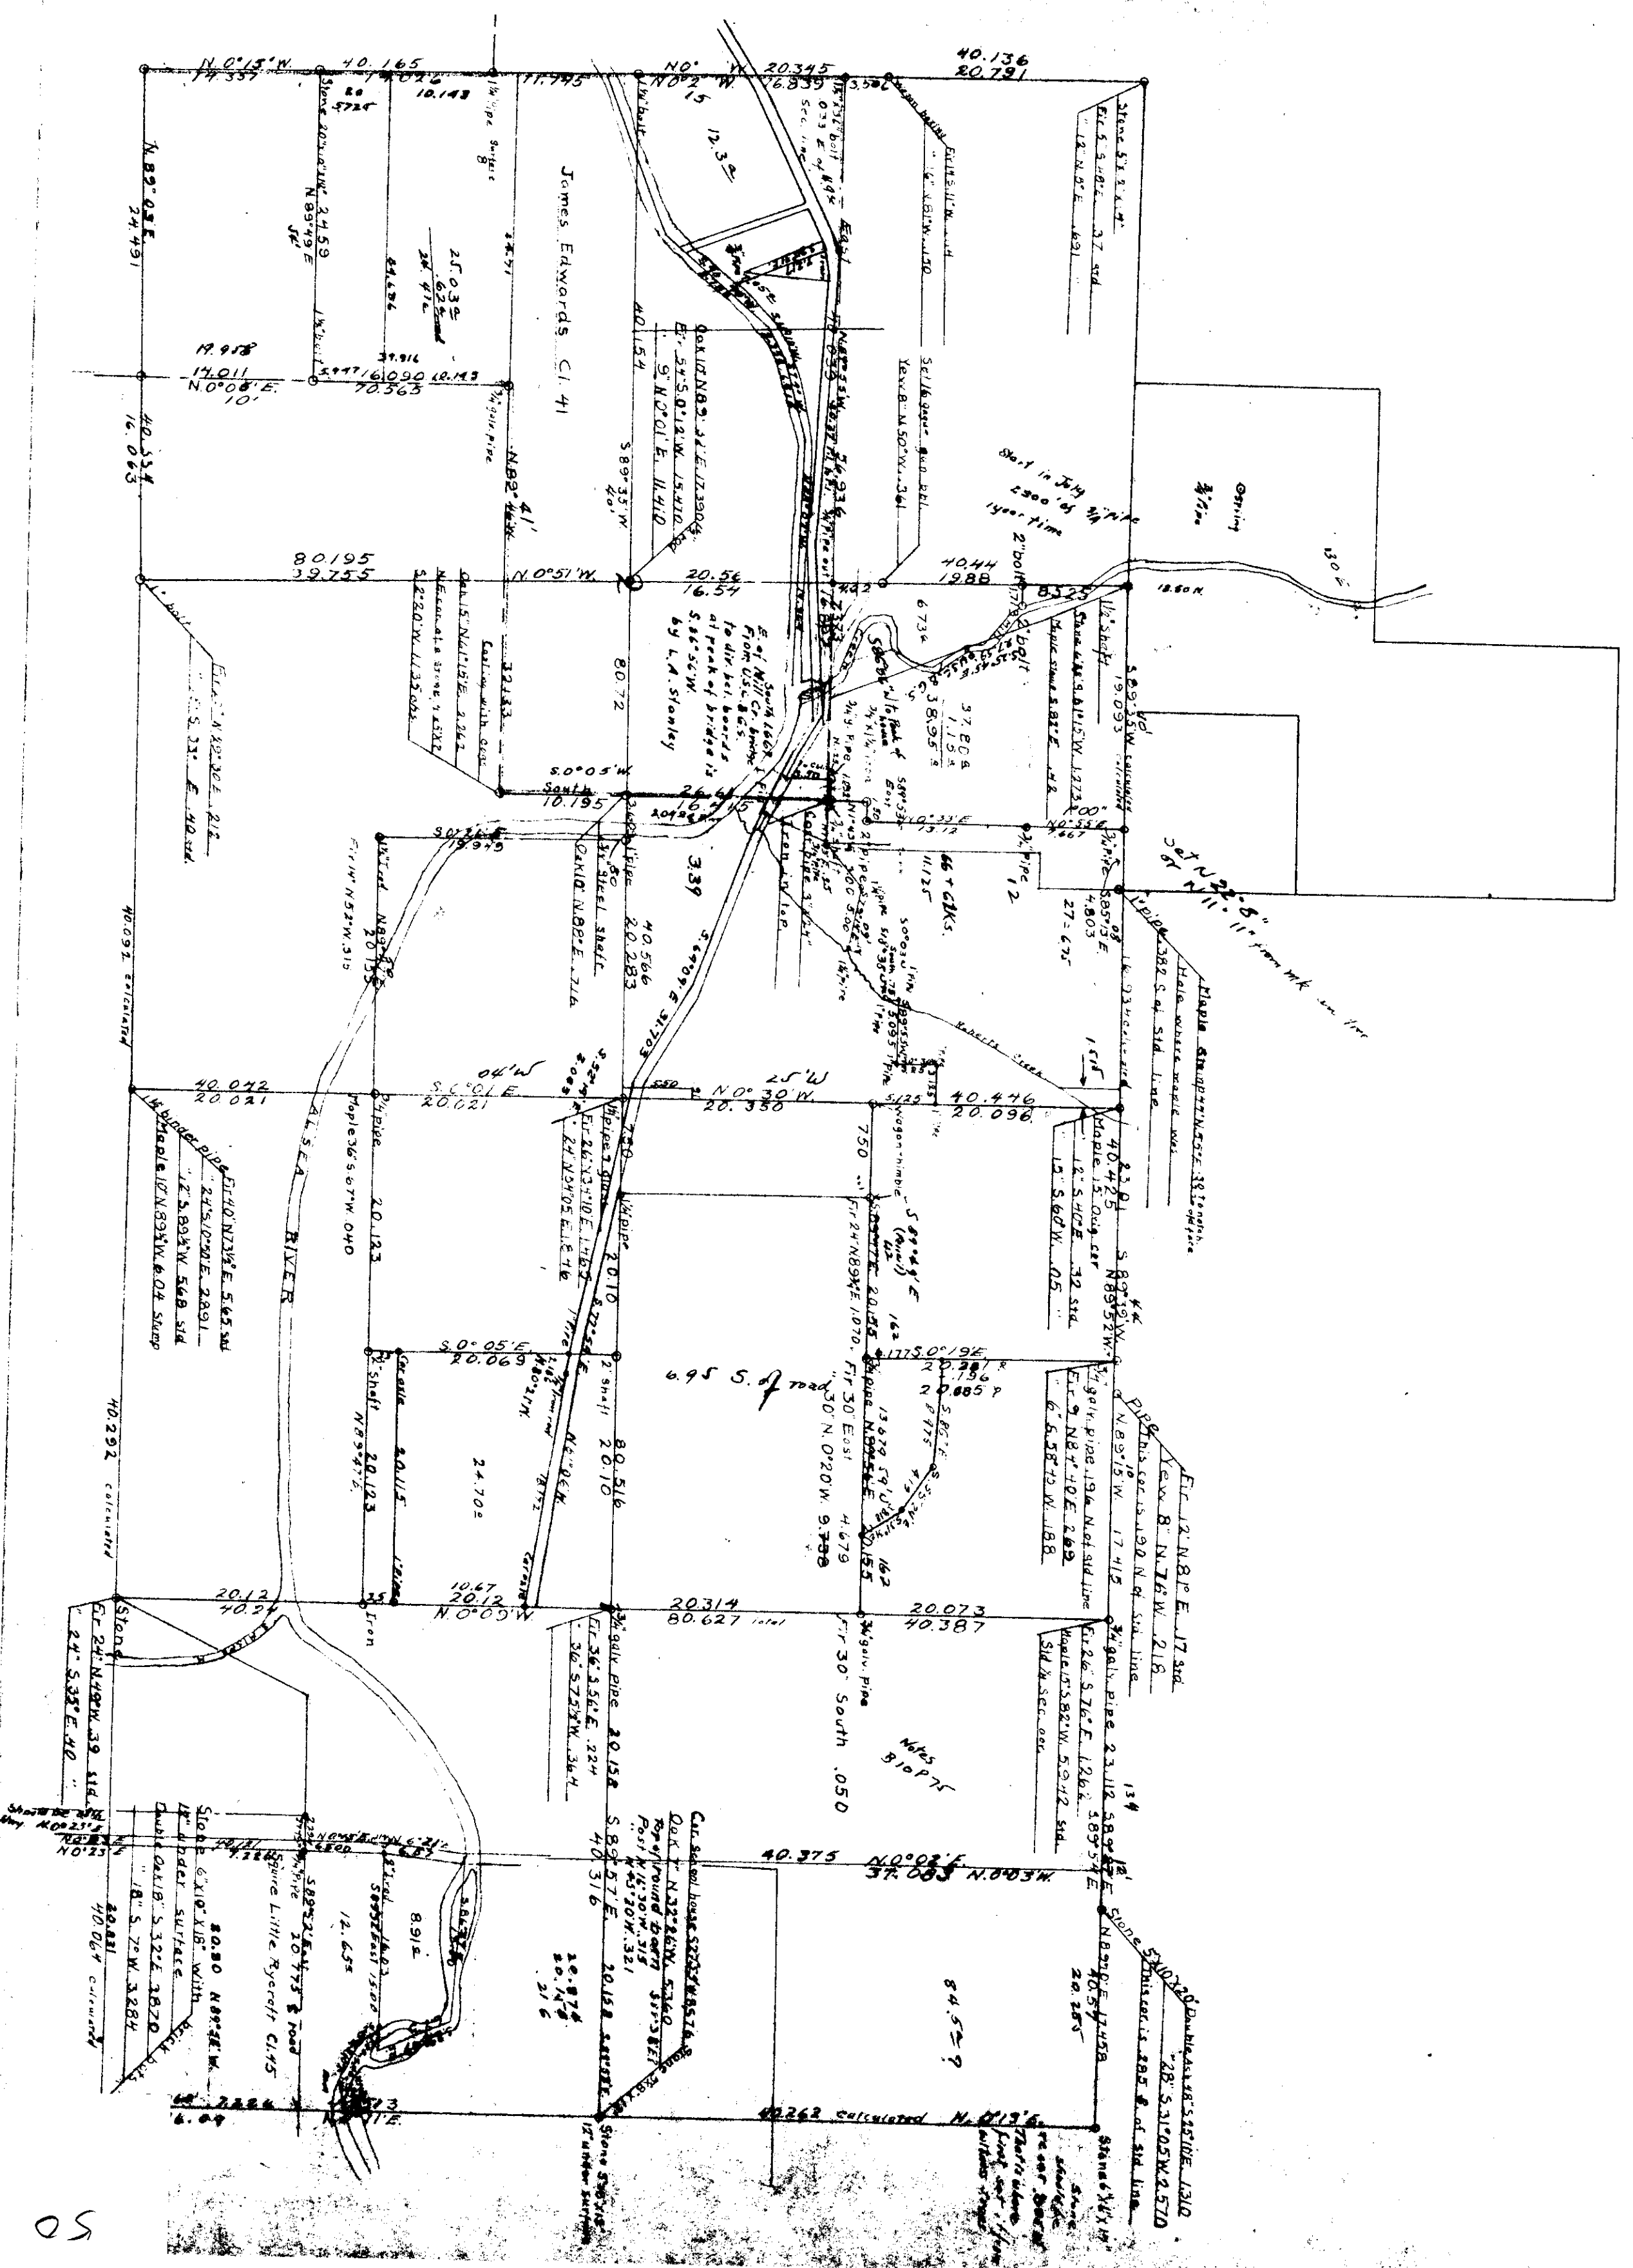

COUNTY SURVEY #127
Secs. 14 2 T14S R8W W.M.
Scale 1" = 100 ft.
W.C. GUNAWAY, C.S.
April 13, 1920.

50