


14-8 00004

11814

C.S. 107

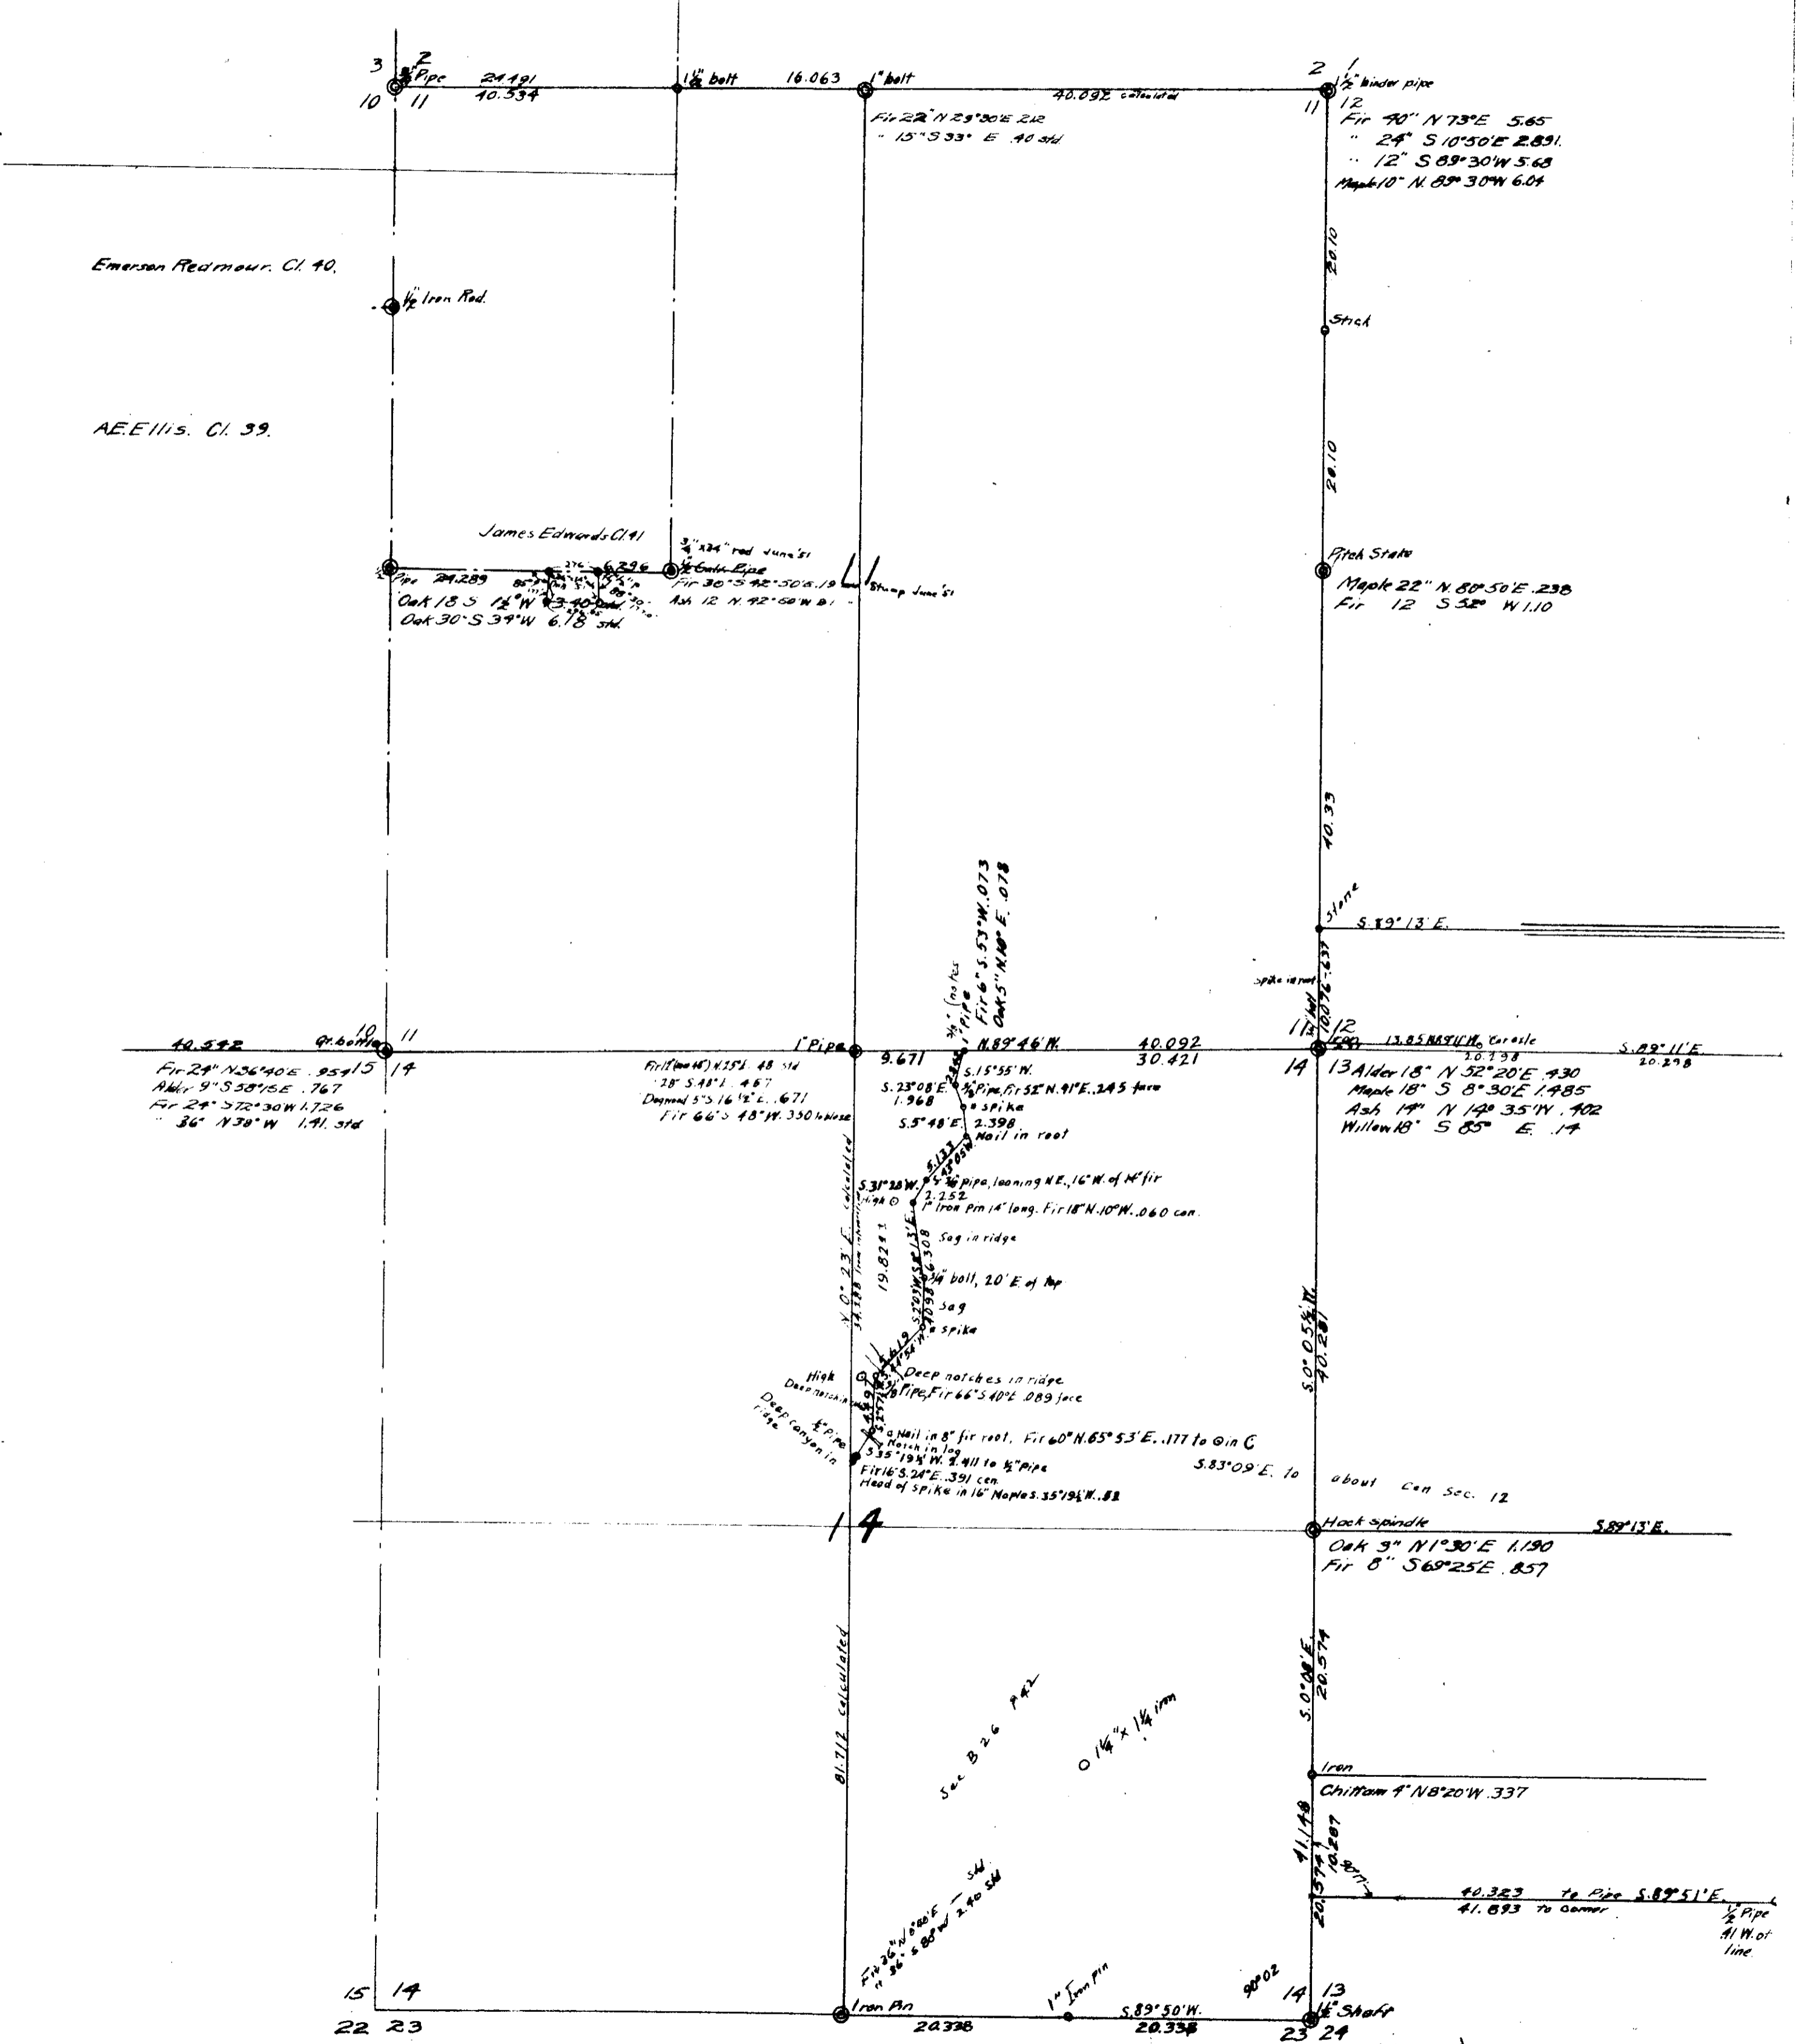

(FB 15-64)