


15-5 00001
2.3.10.11

C.S. 72 43-1A
T.15S. R.5W.
Scale: - 1in = 10 chs.

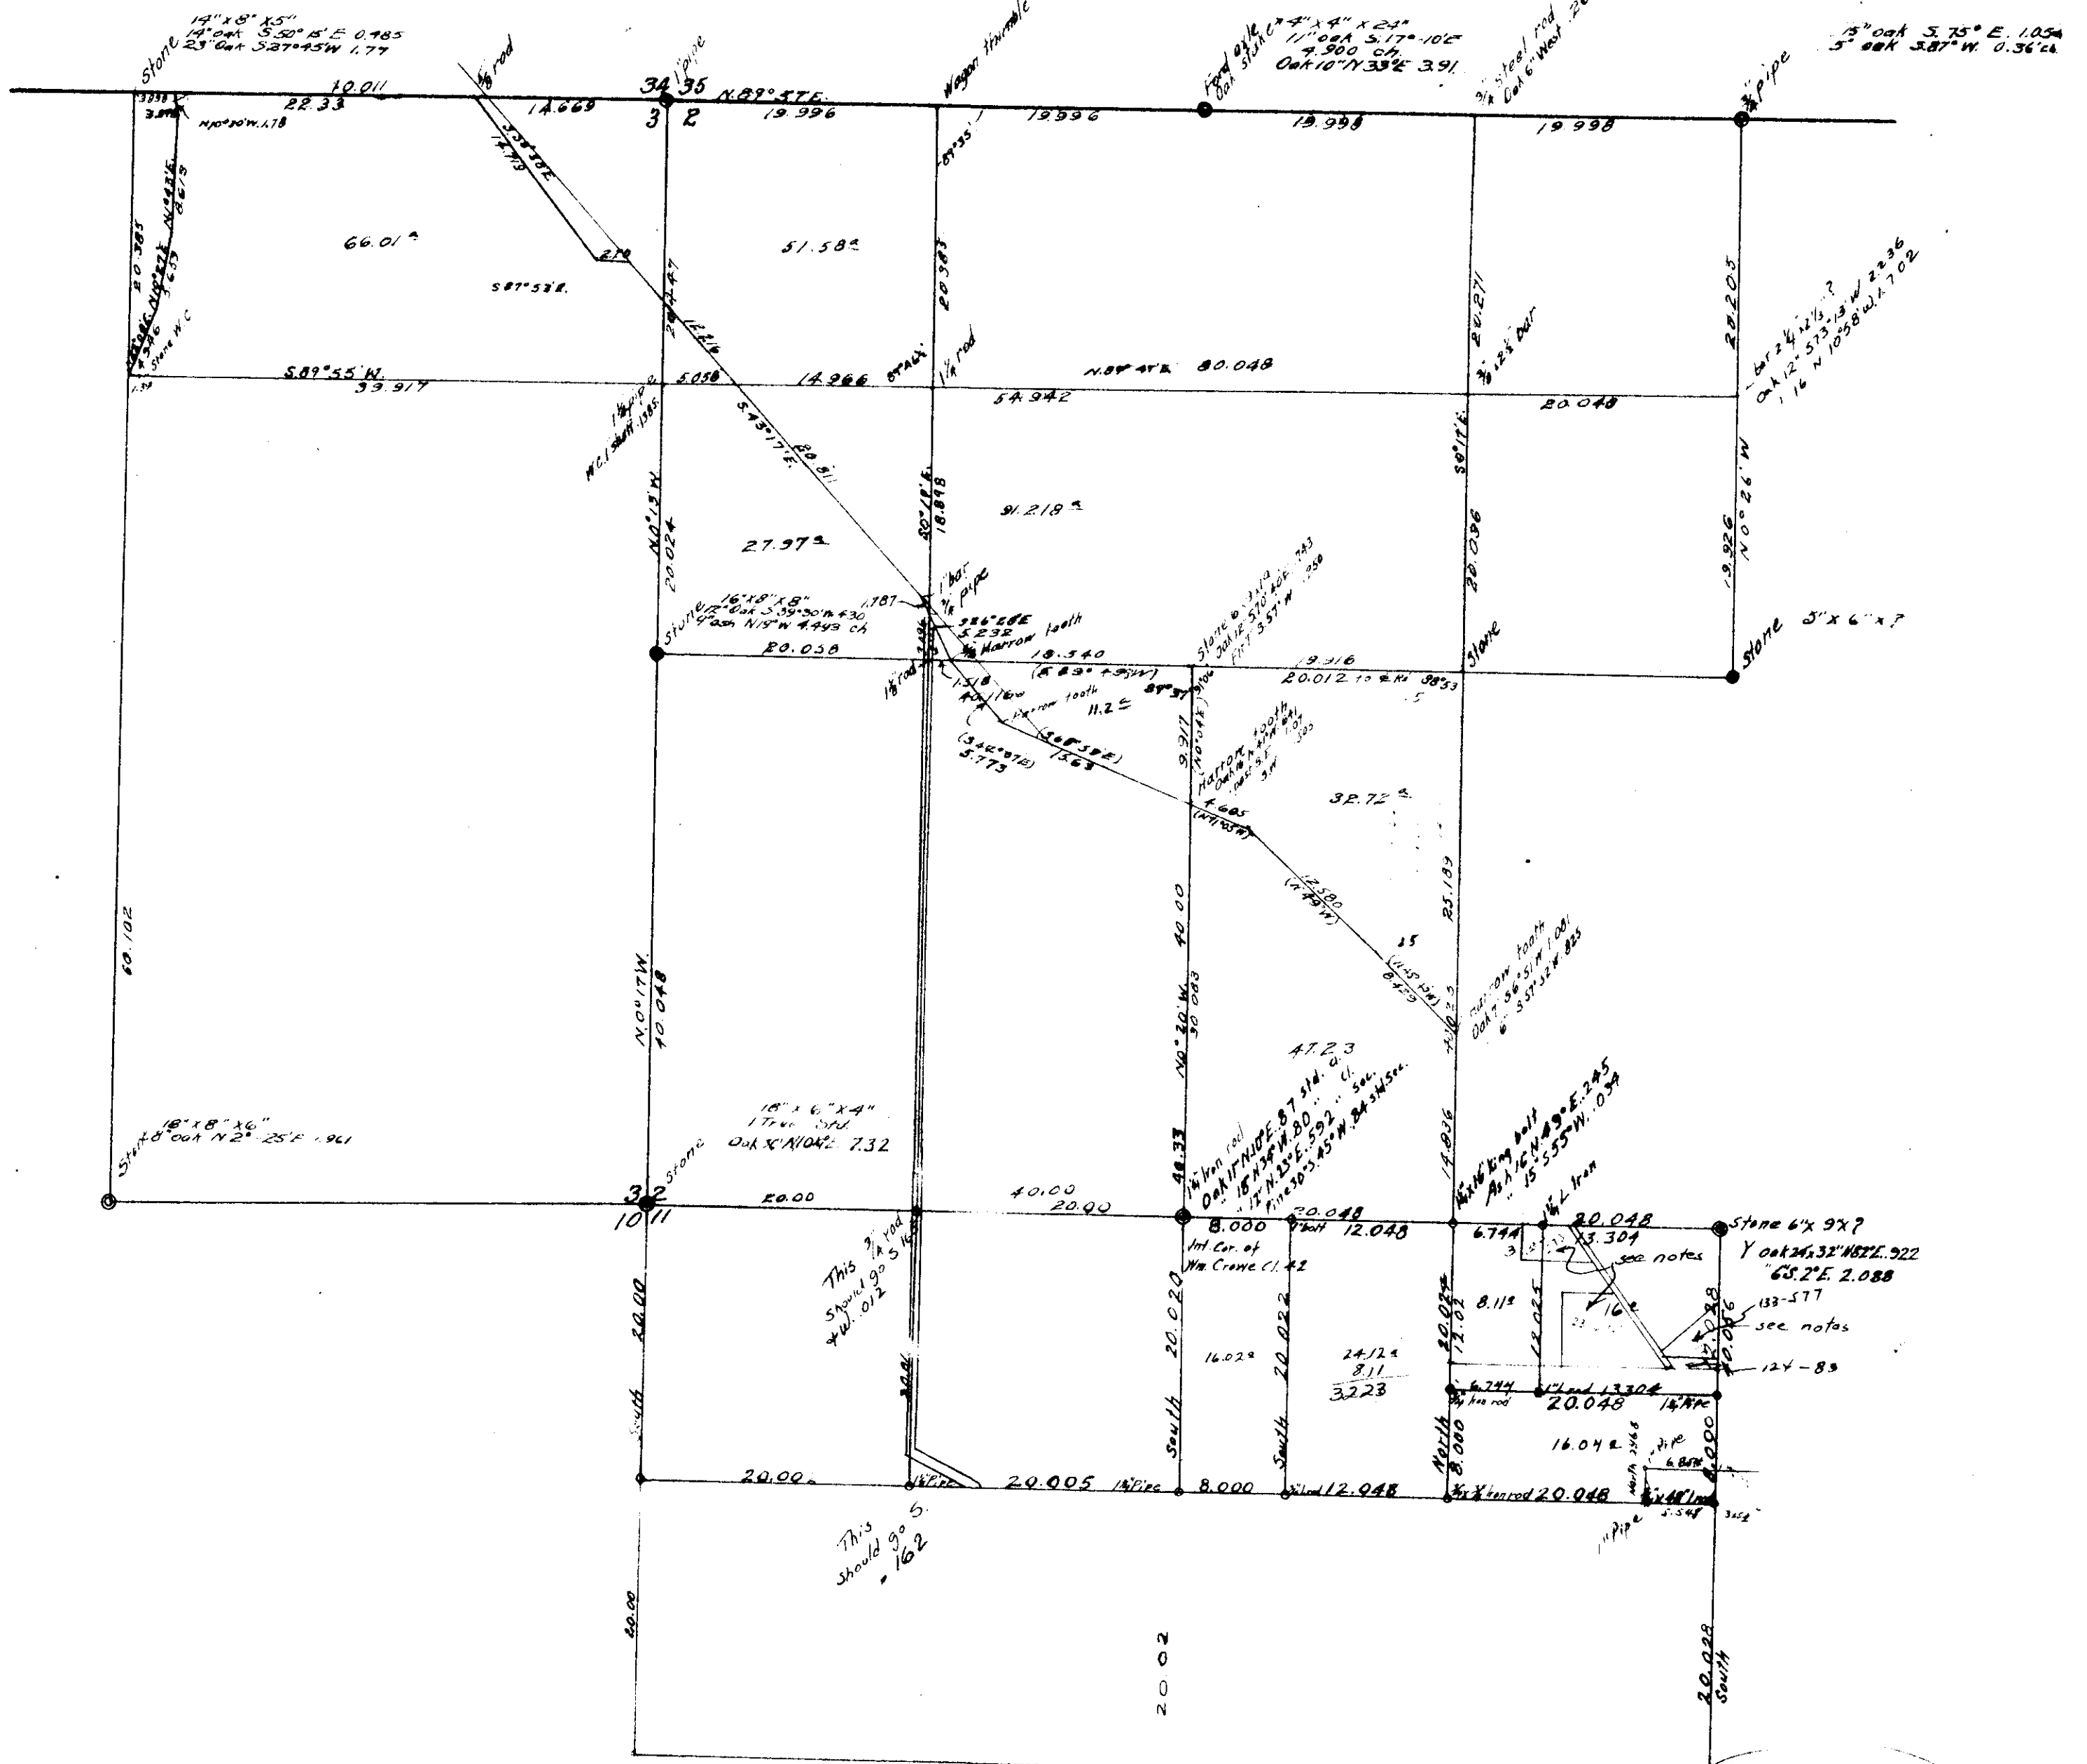

3/4" Pipe Gone 11-50
Ash 14" N.87°E..79 stw.
Pine 18" S.56°N. 1.14 "