


School Property

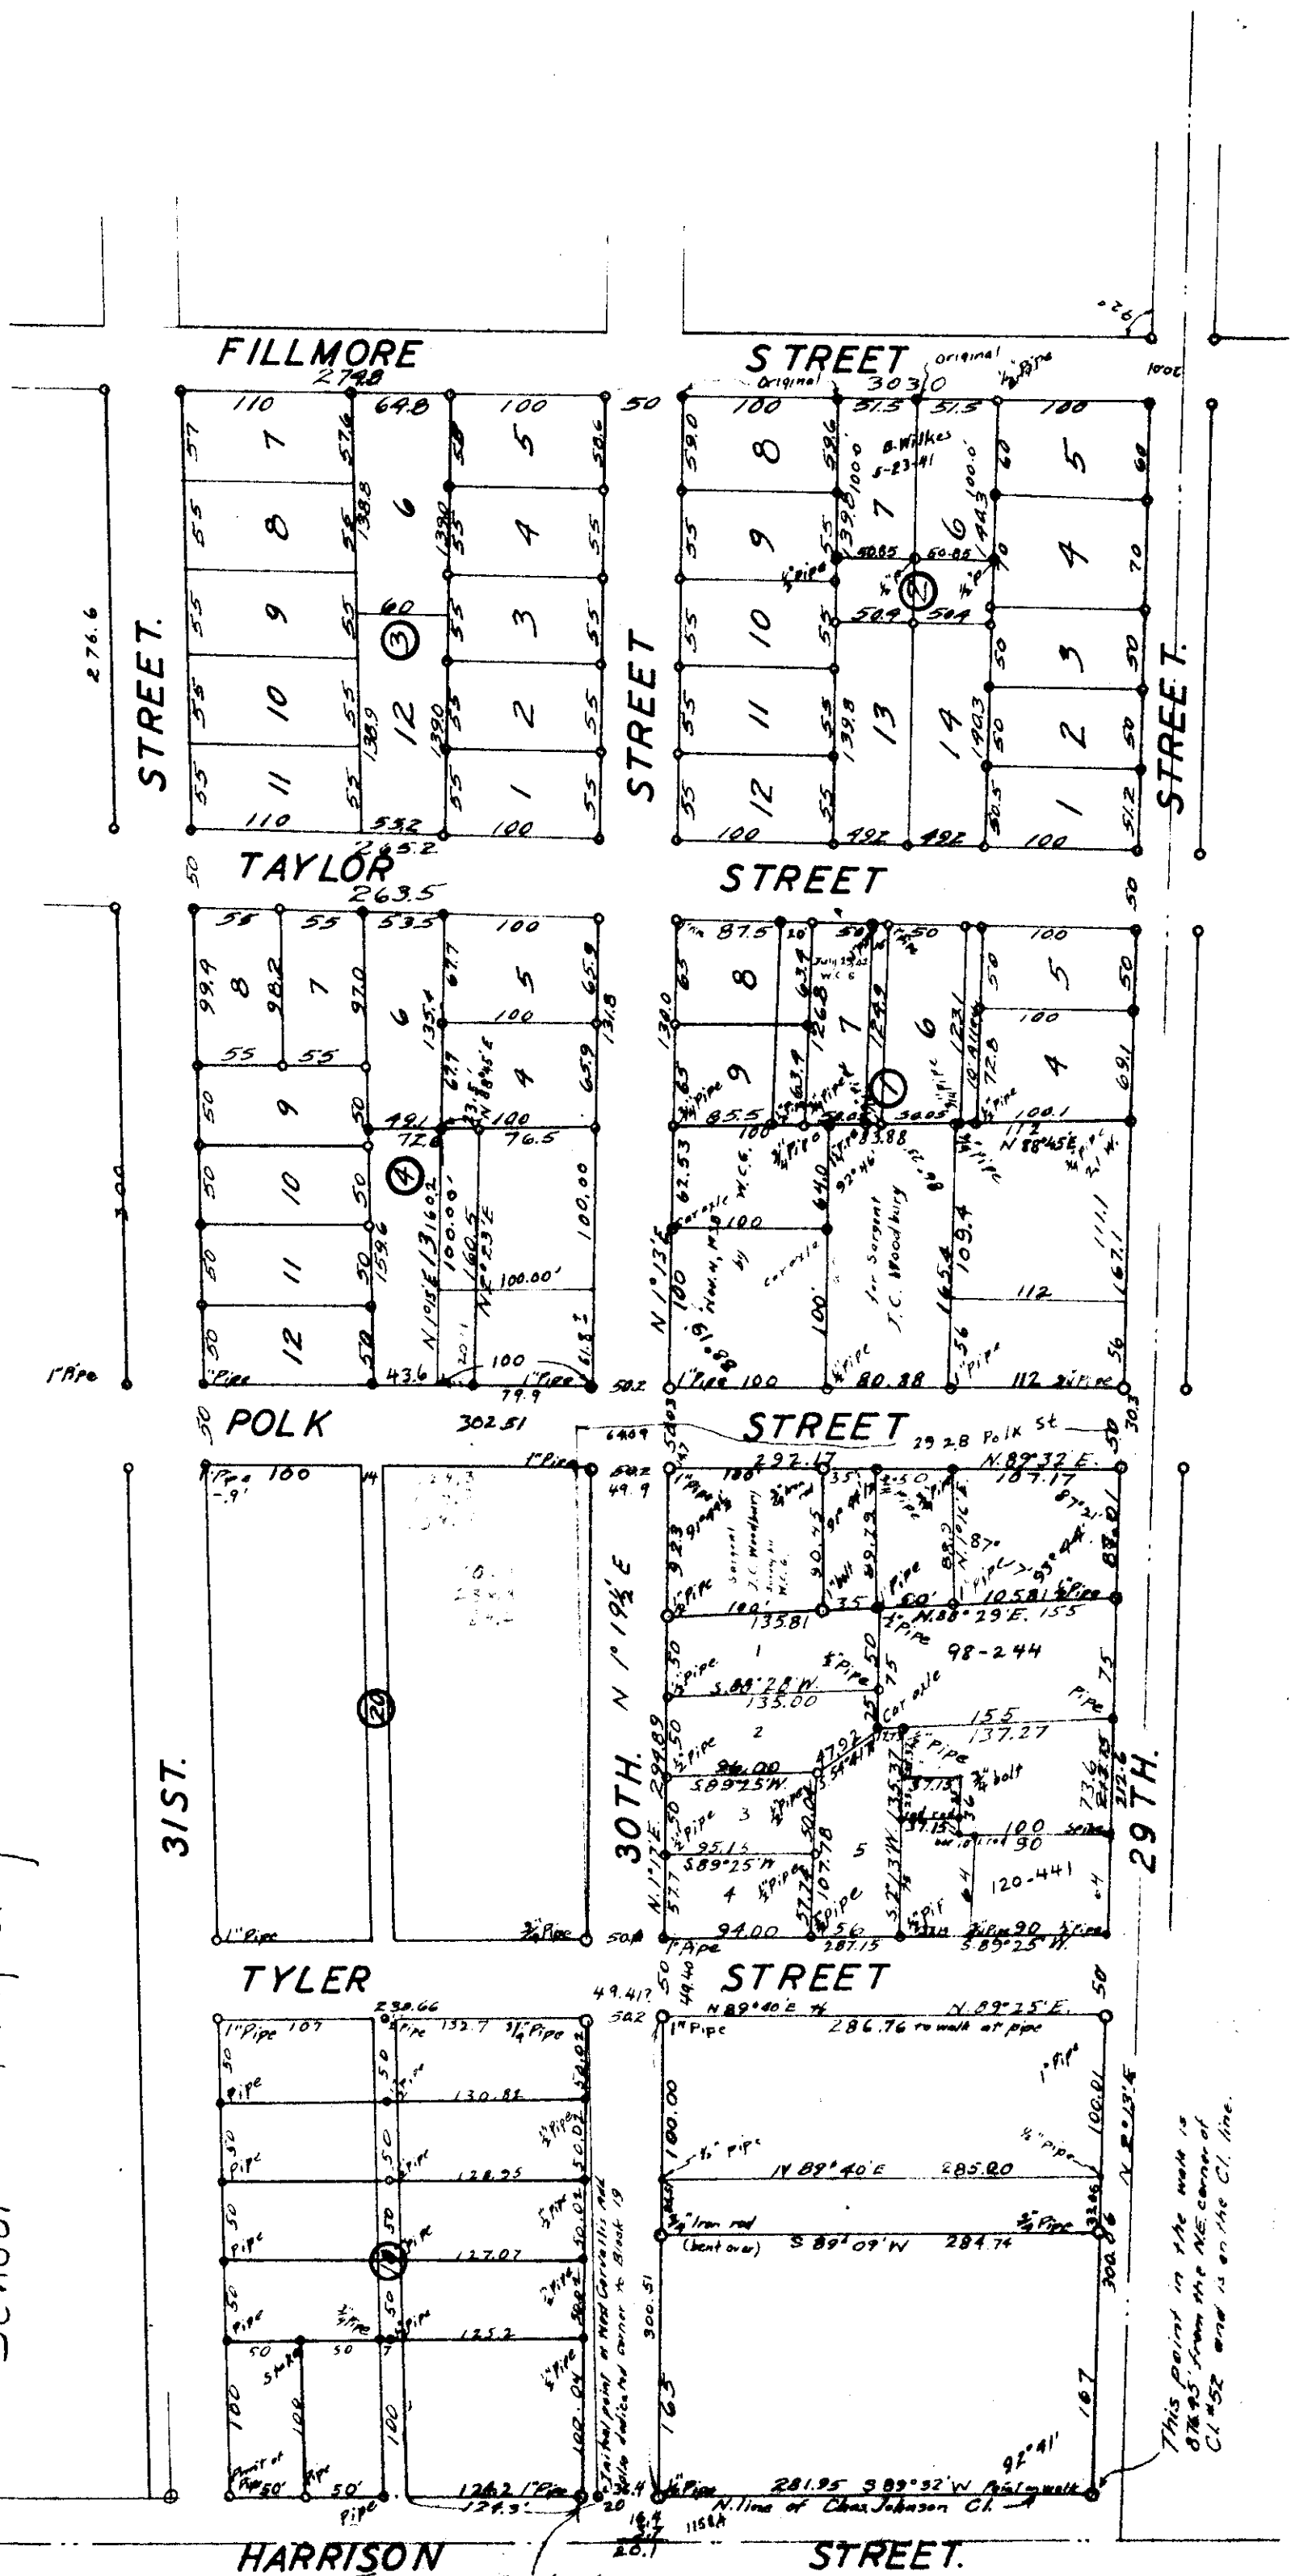

**HARRISON STREET.**  
 The present street corner is 101' N on the CI line from the original corner of Block 19 West Cortalis Addition.

This point in the wall is 078.45' from the NE corner of CI #52 and is on the CI line.