


JOB'S ADDITION

Scale 1 in. = 100 ft.

Bearing to  $\frac{1}{2}$  of 16th St.

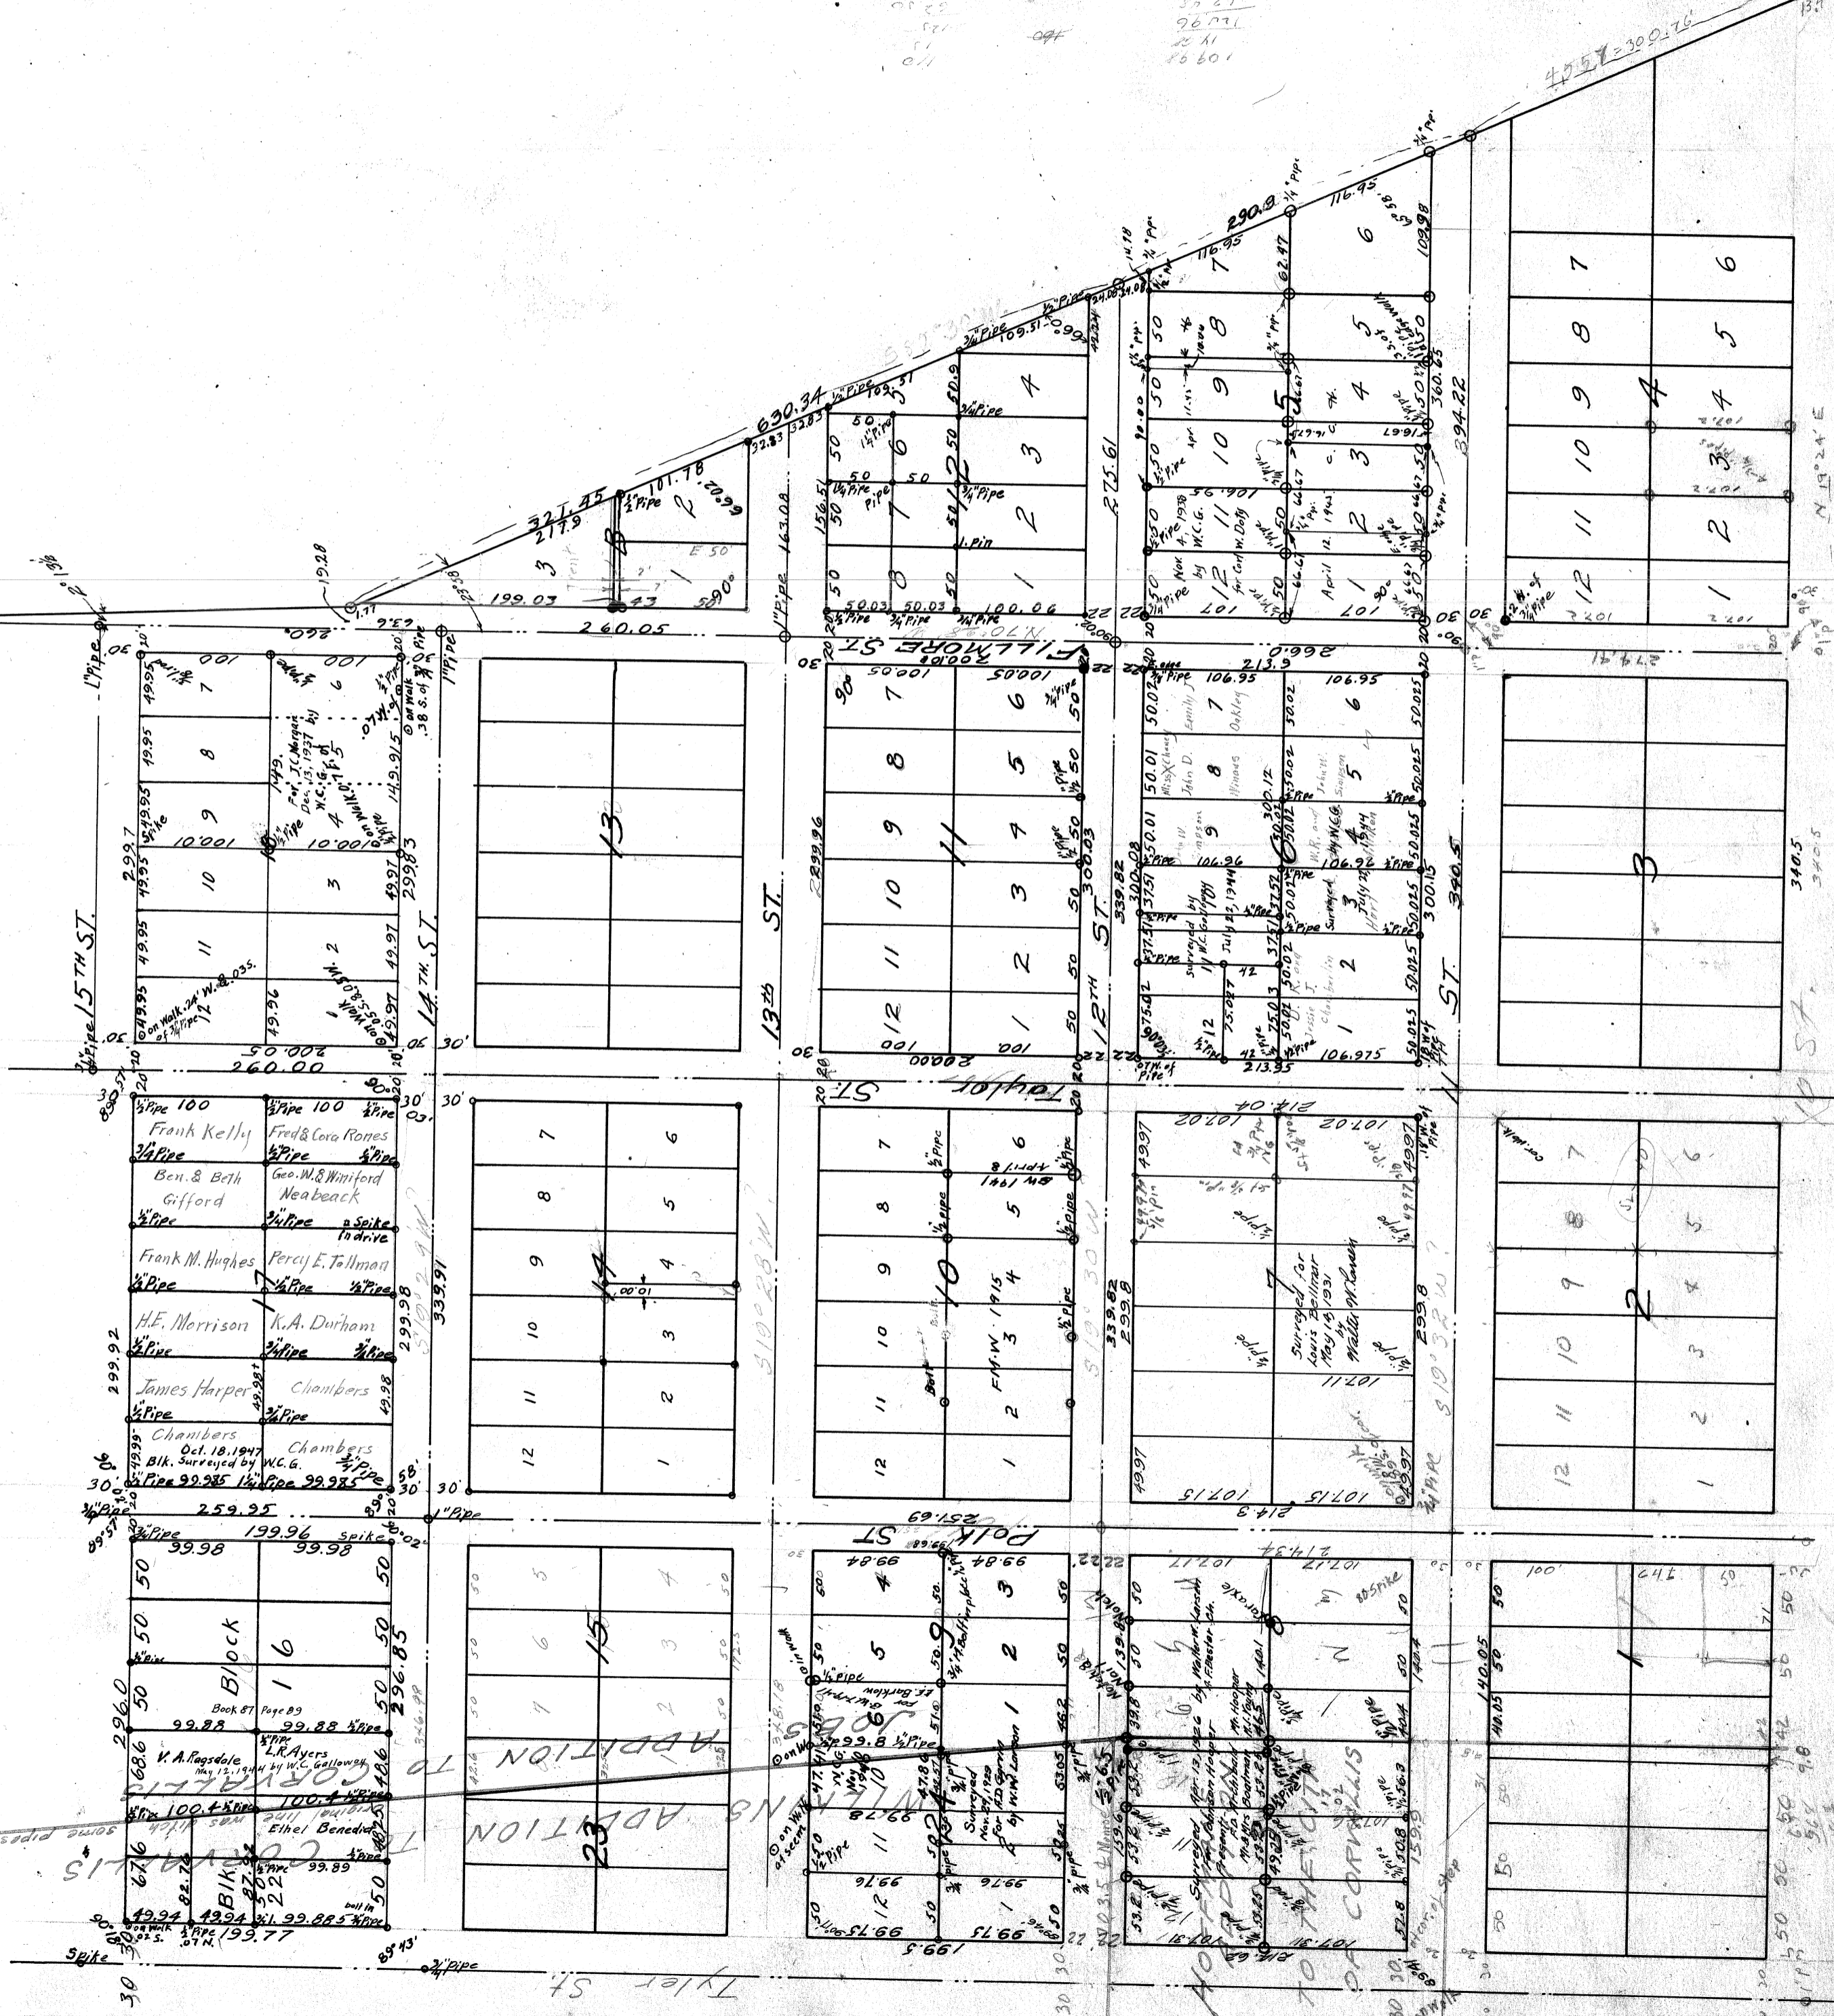

339.73

340.5

340.5

# JOB'S ADDITION

Scale 1 in = 100 ft.

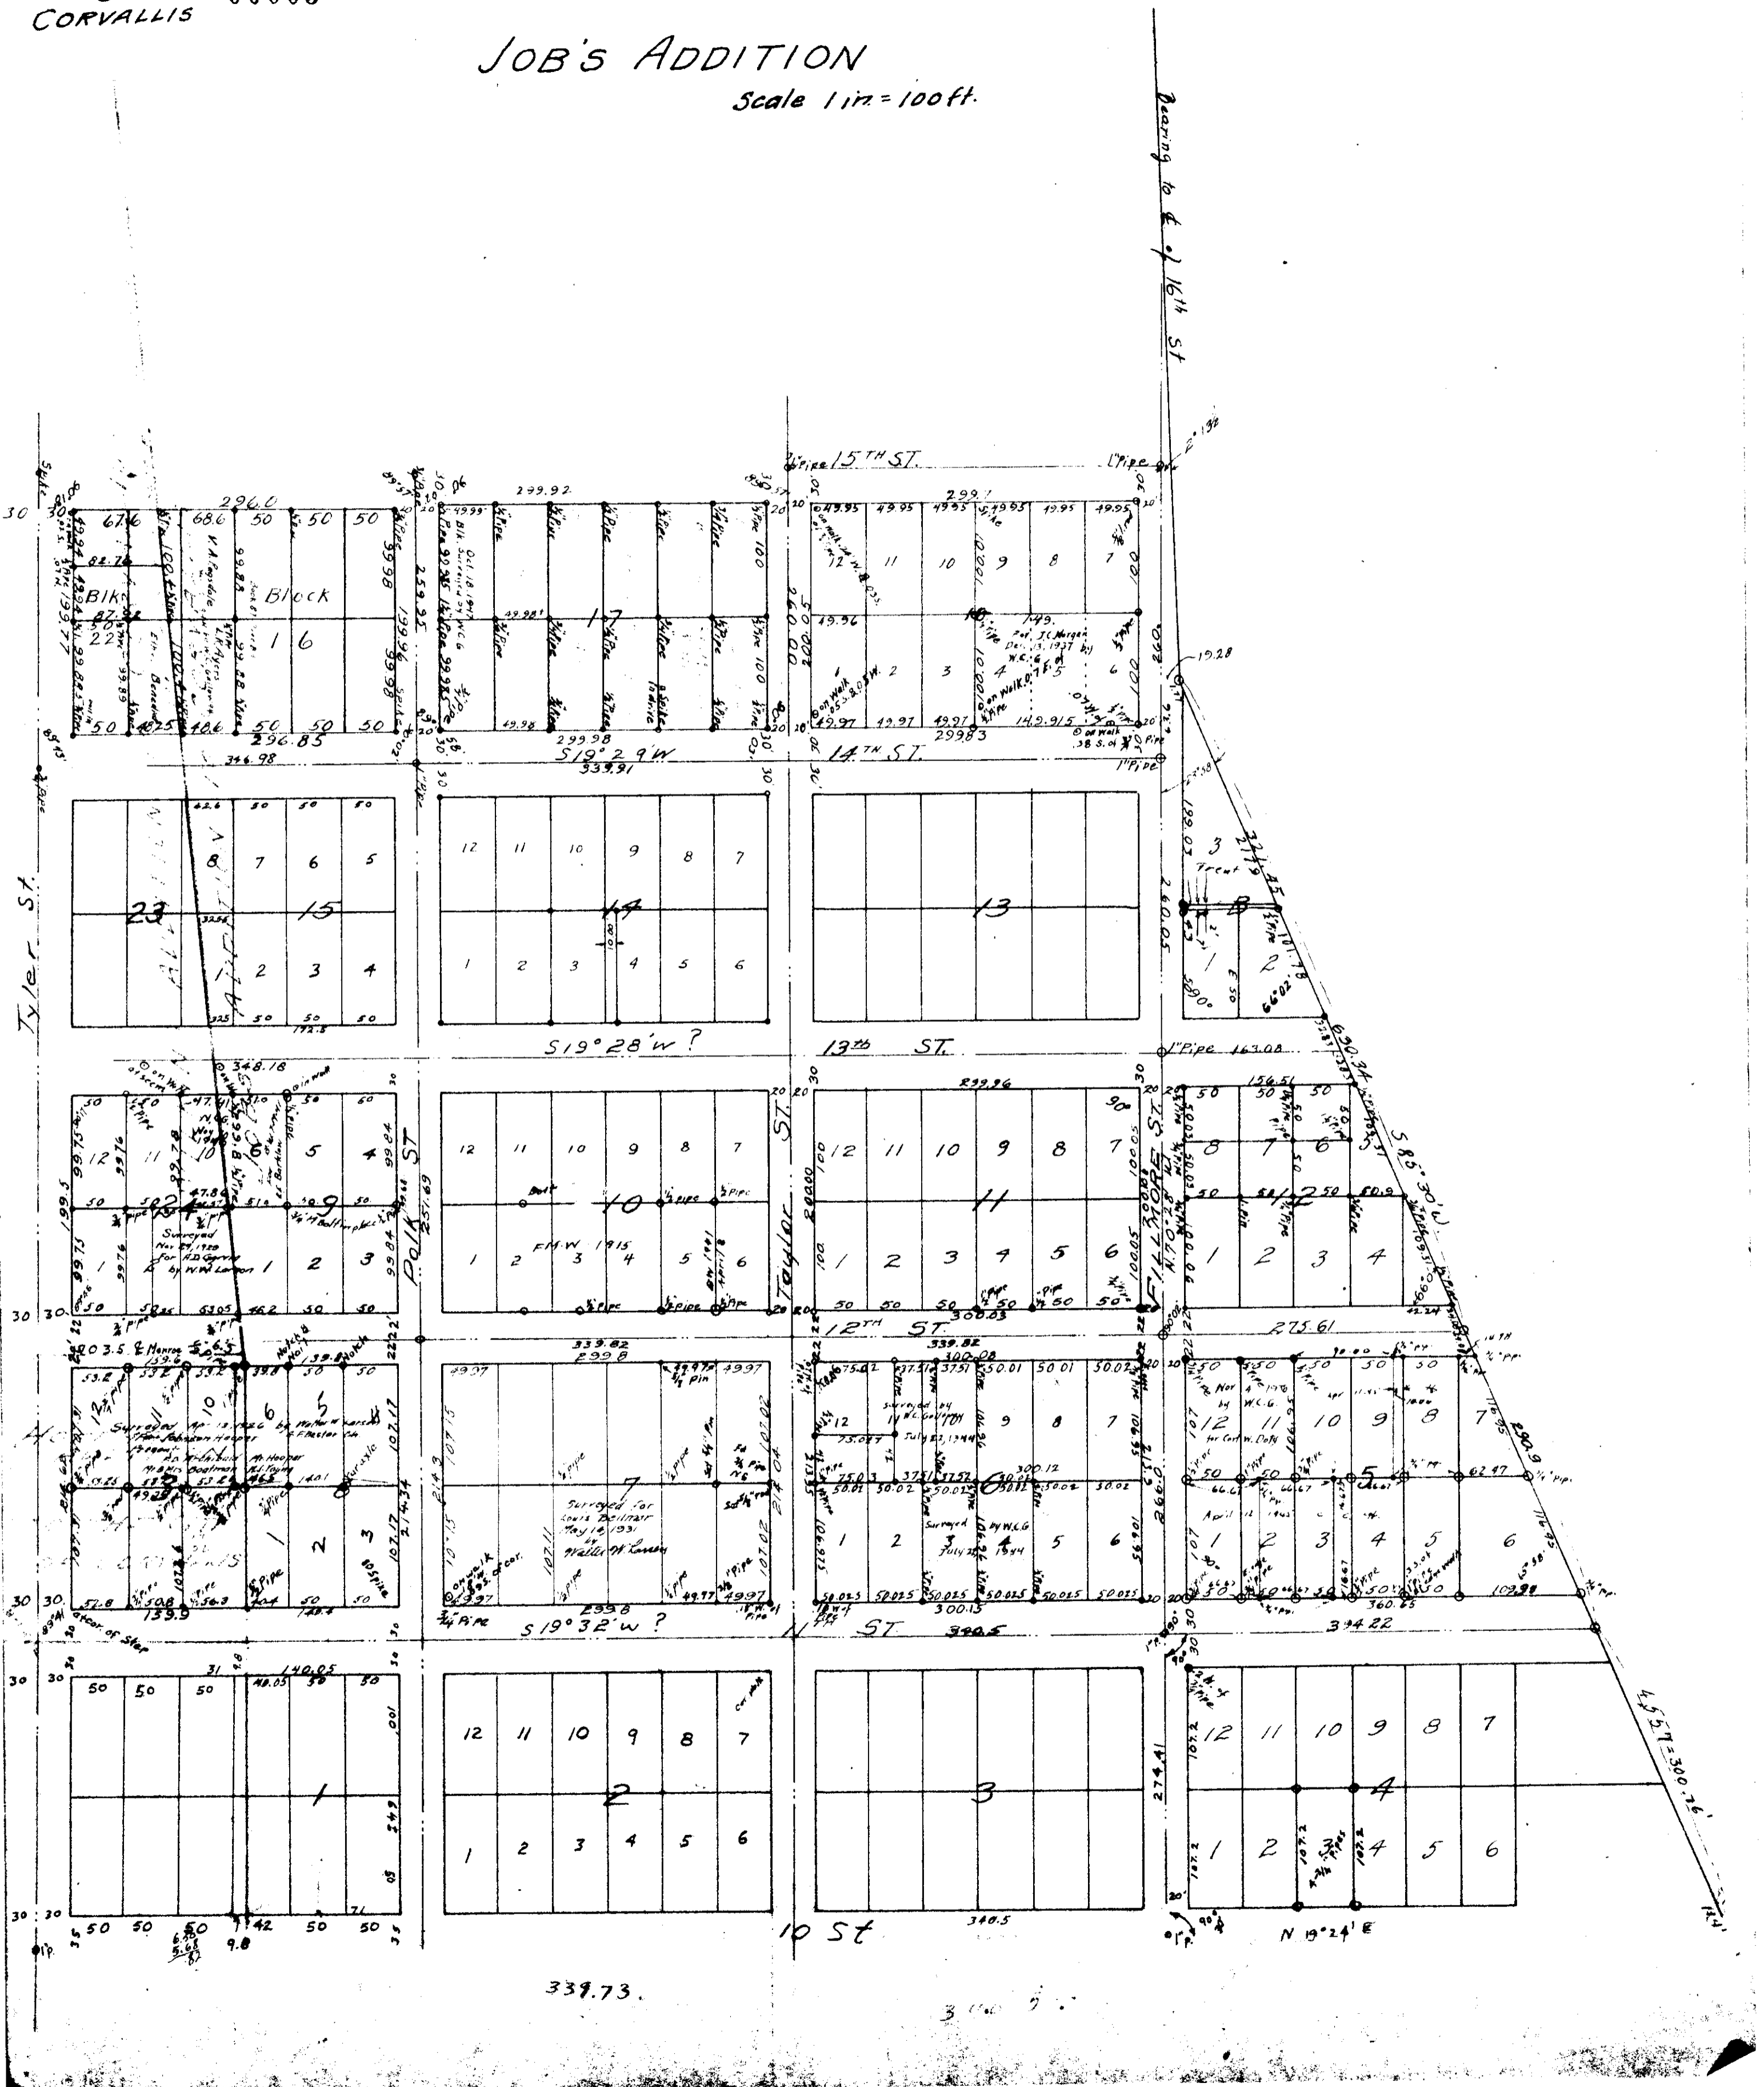

339.73

300.5

N 19° 24' E