

Δ = 2°31'43"
D = 20'
7 = 72'
L = 142.76'
R = 2864.77'
E = 0.92'

Fill more?

FREMONT


STREET

POLK (South St)

STREET

STREET

TYLER

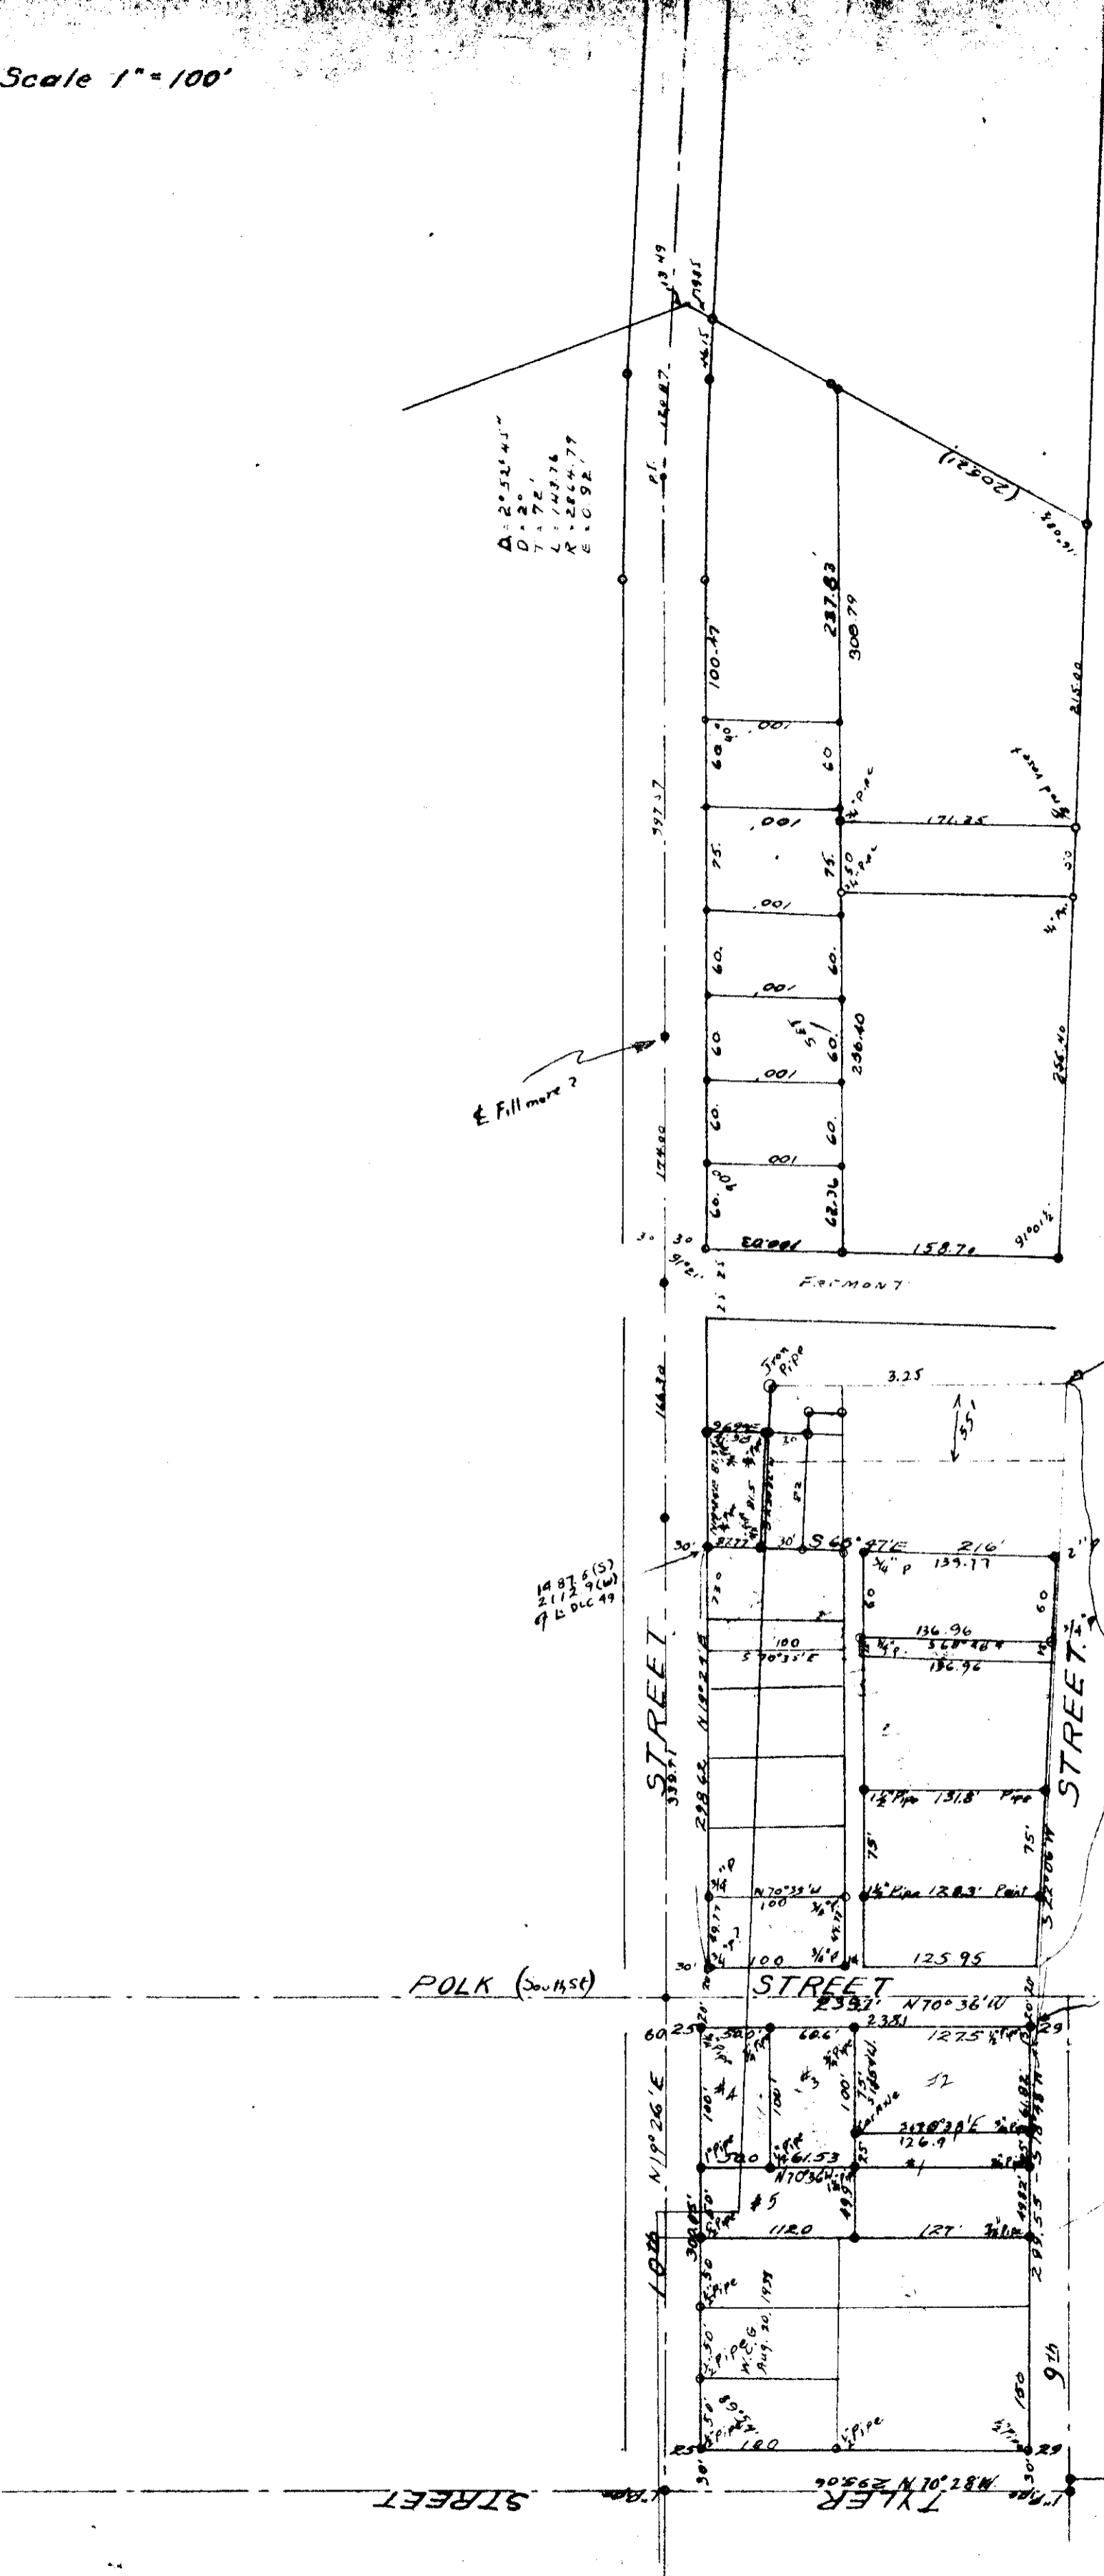

(T-101) 7
7 ac ±
7M-Faddon
15 19.3 (S) 1/2 LCI 49
18 16.3 (W) 1/2 LCI 49

1885' (S) 1/2 LCI 49
2000.4 (W) 1/2 LCI 49

2026' (S) 1/2 LCI 49
2083.5 (W) 1/2 LCI 49

14 87' (S)
21 12' (W)
47 L D C 49