



00008  
CITY #6

# Rayburns Addition 9th St

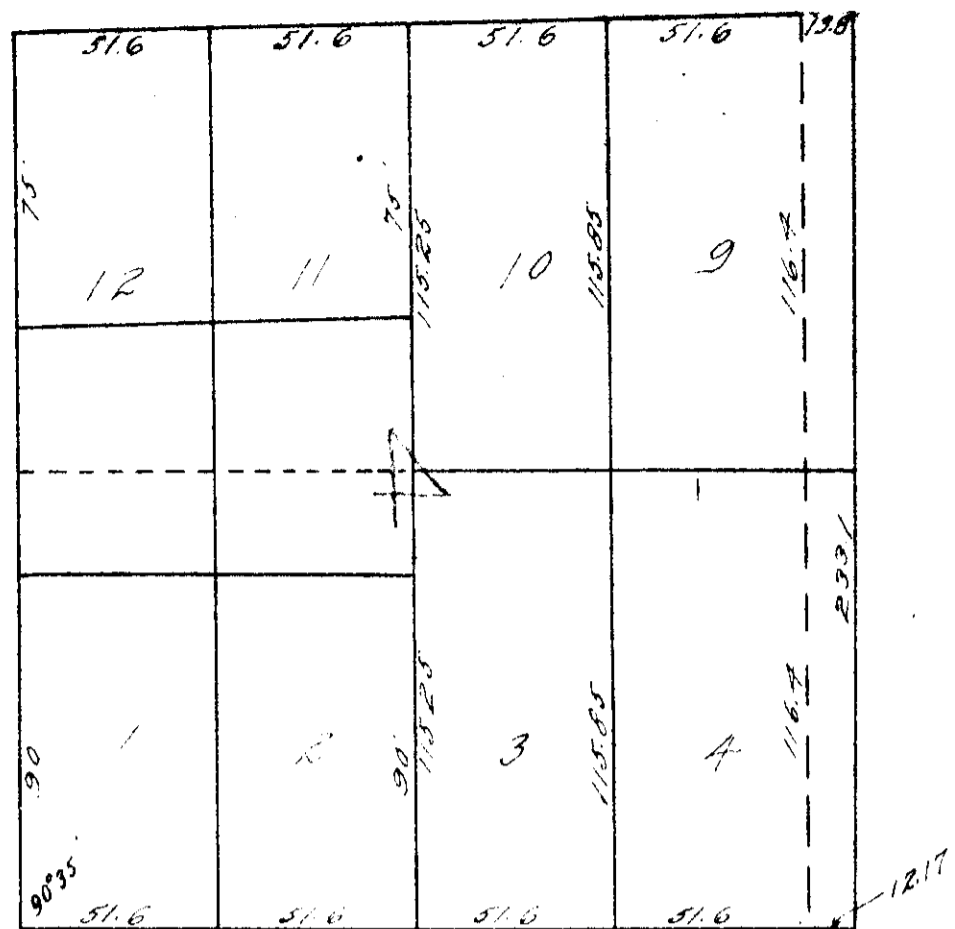

# 8th St

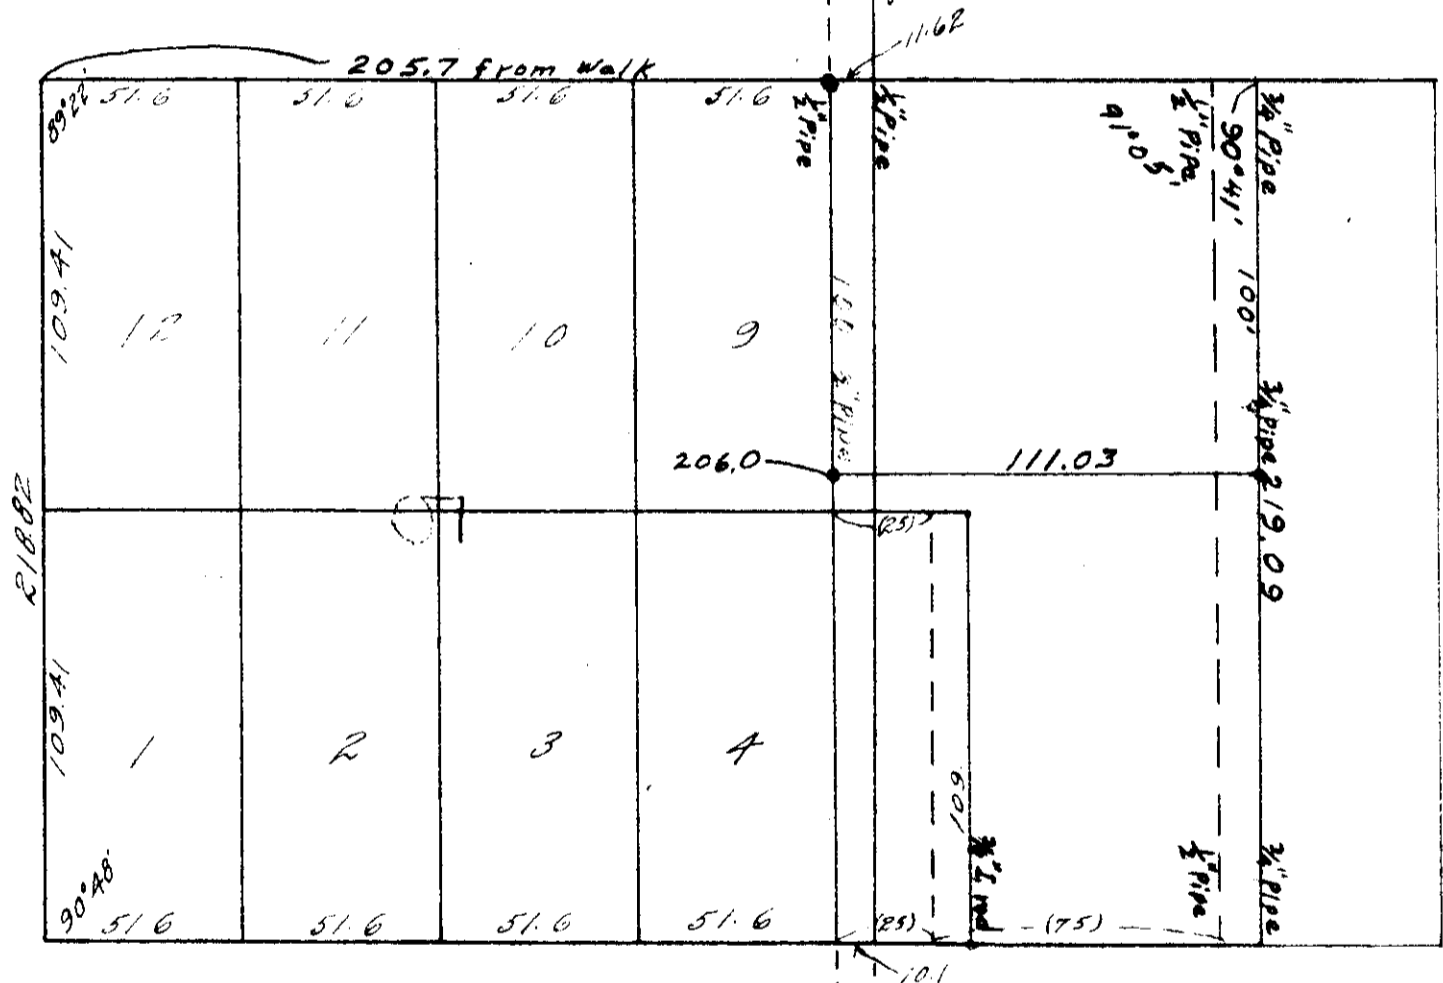

# 7th St

