


See Plot 23 for this part.

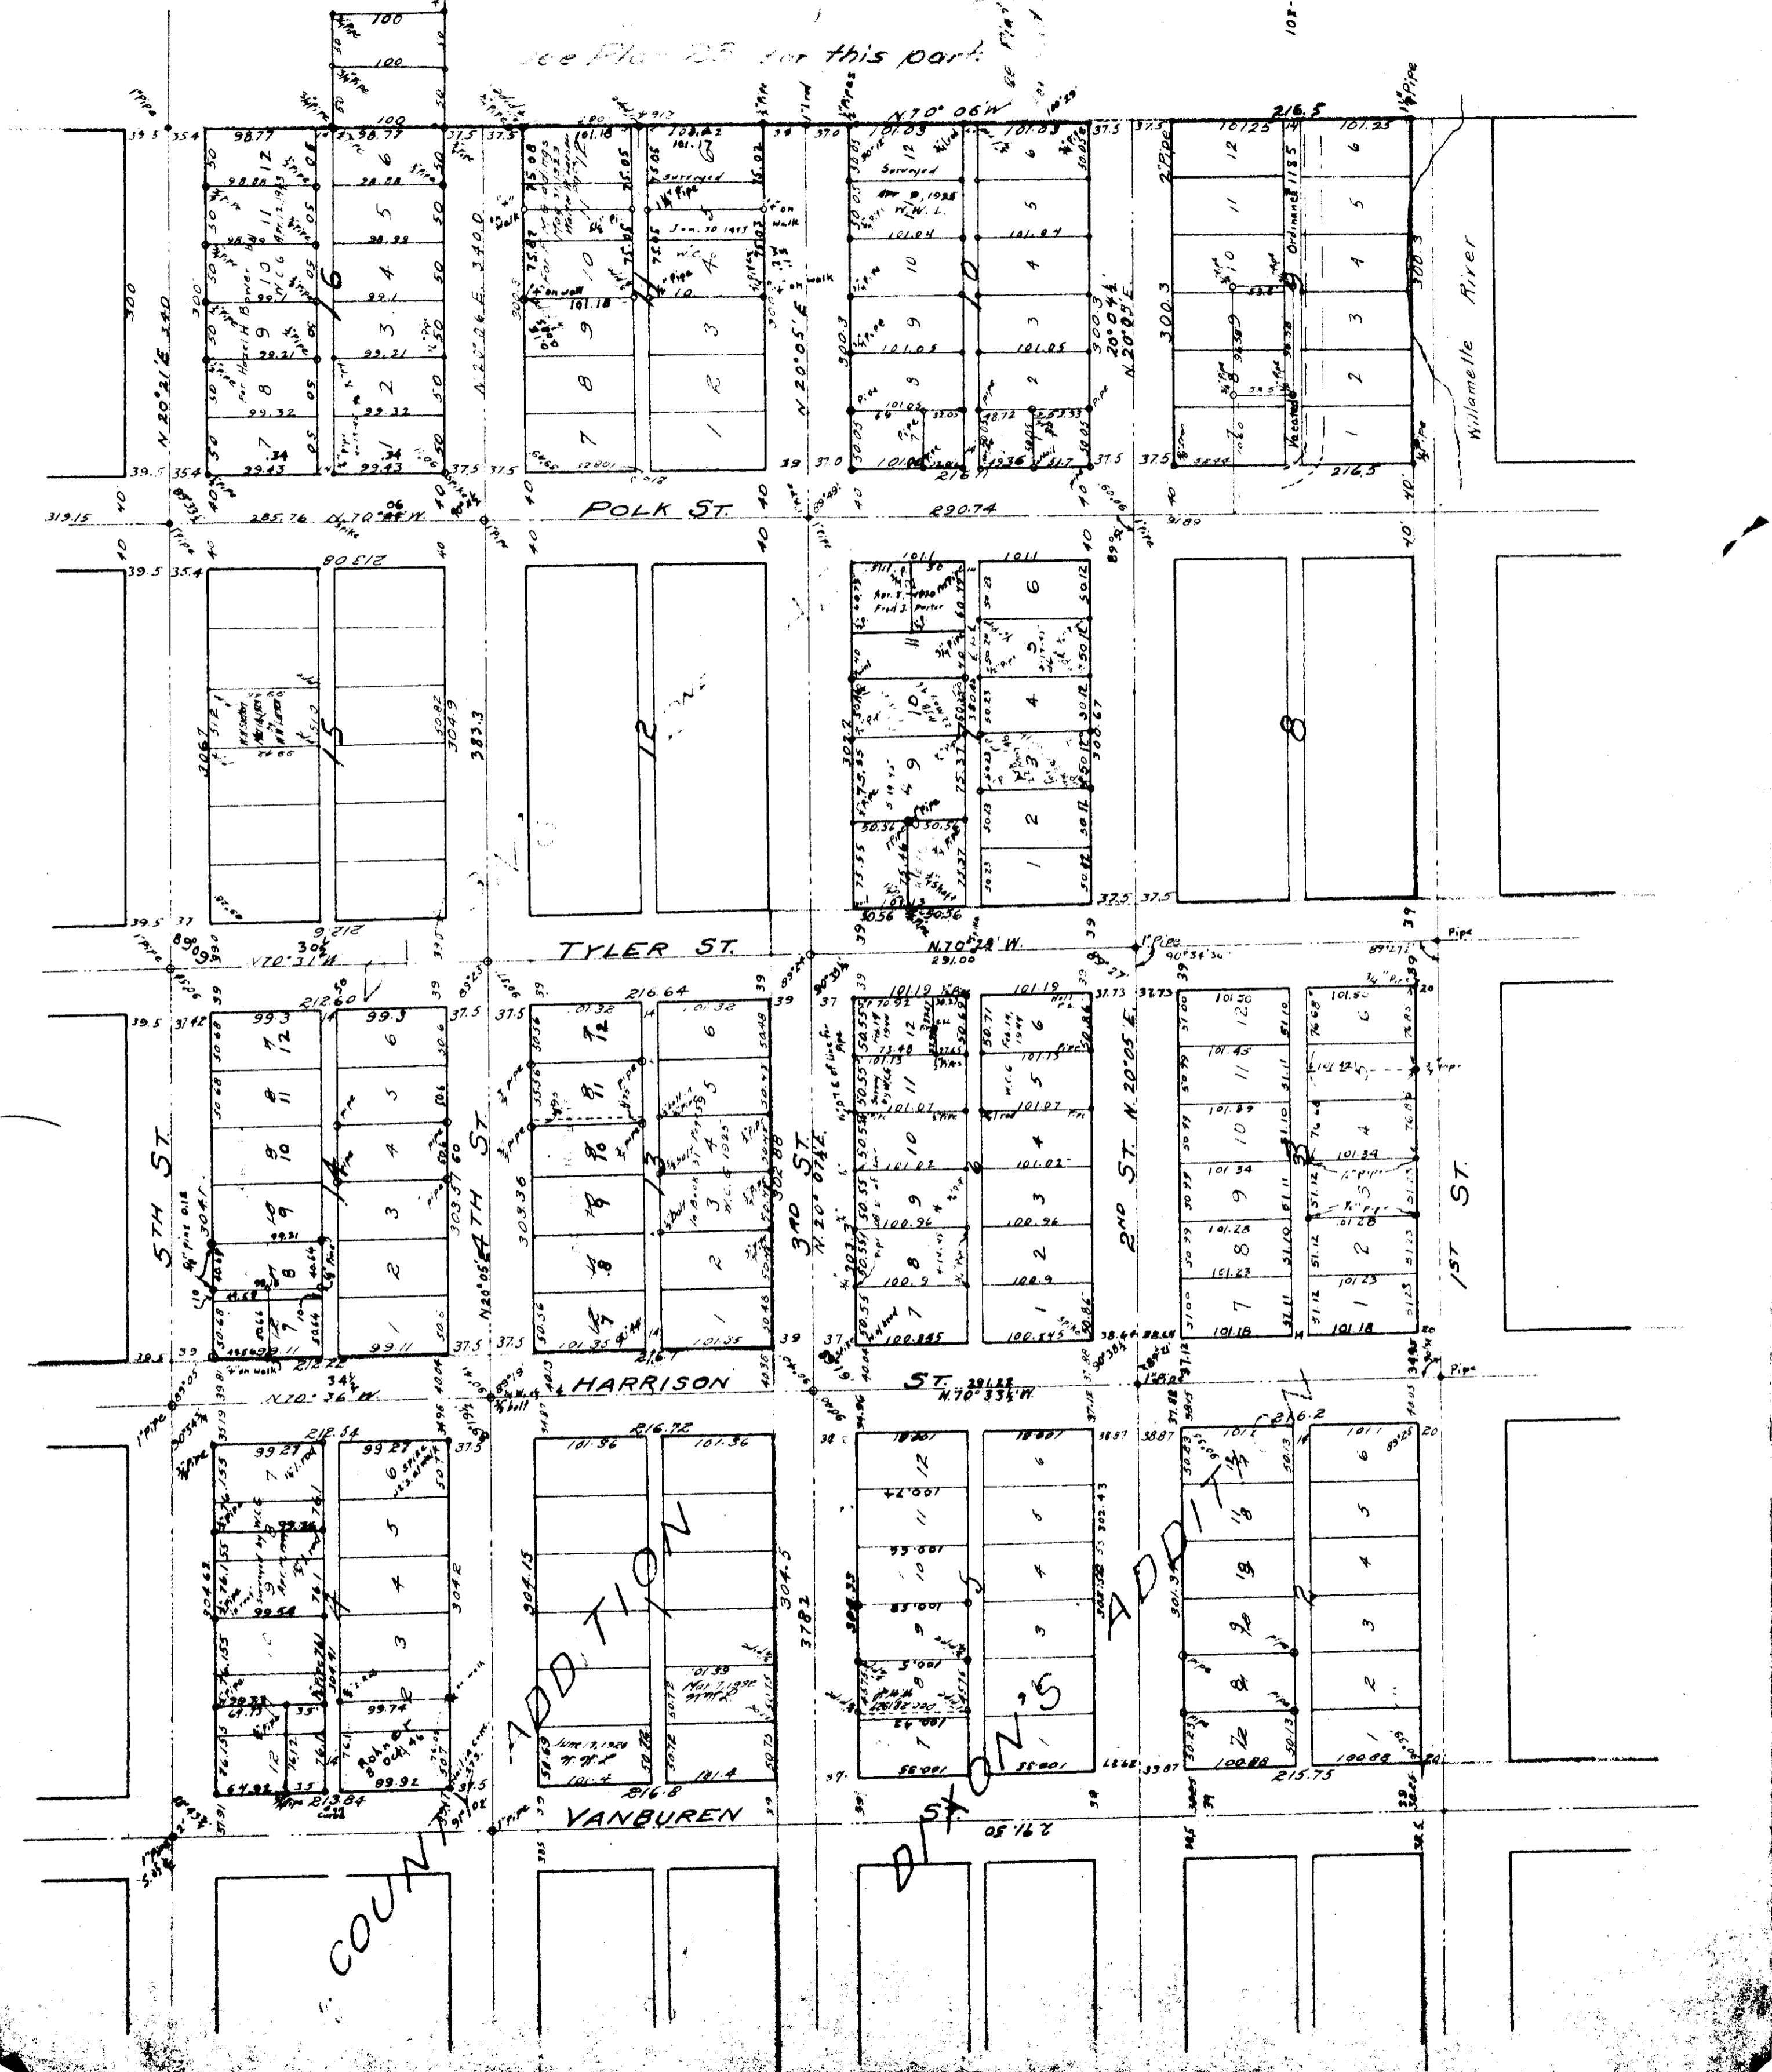

COUNTY

ADDITION

DISTON