
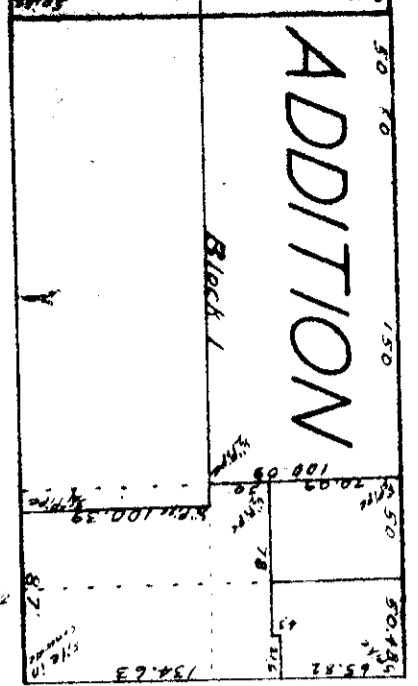
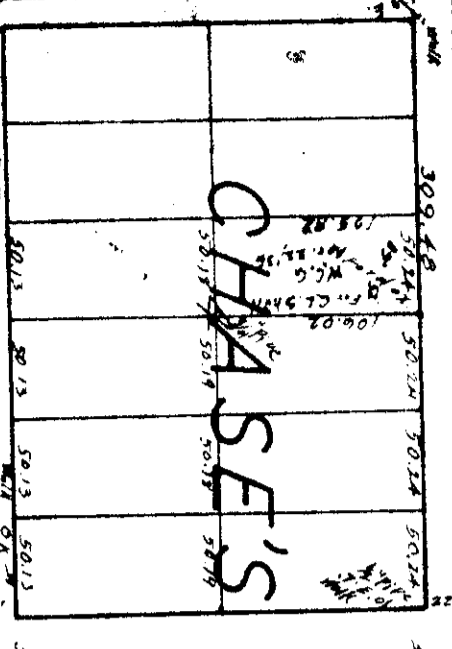



12 00012

MONROE STREET





NICHOLAS'S FIRST ADDITION

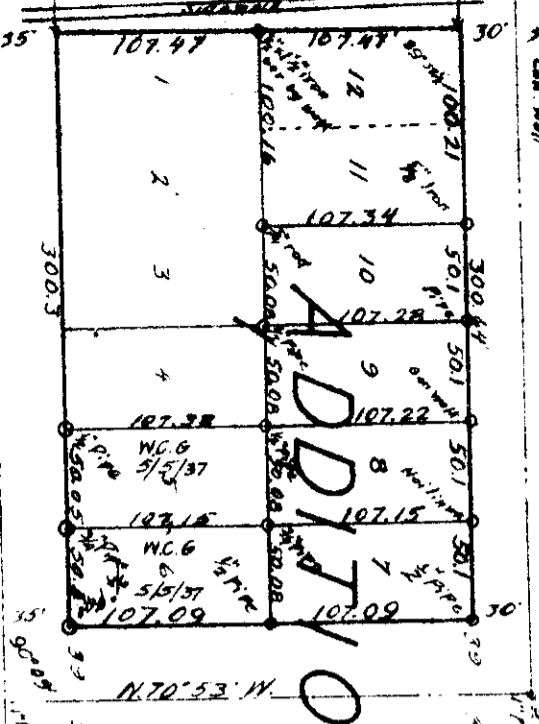


FISHERS

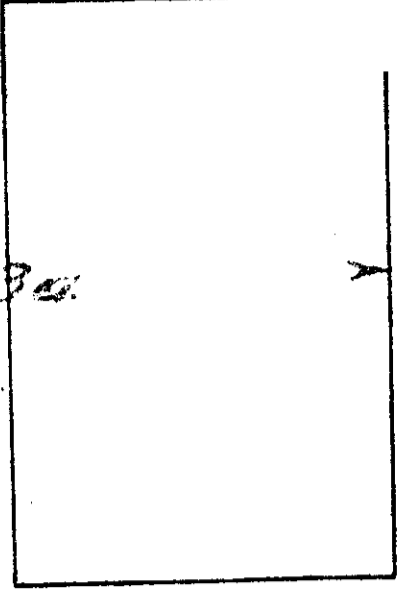

JACKSON STREET


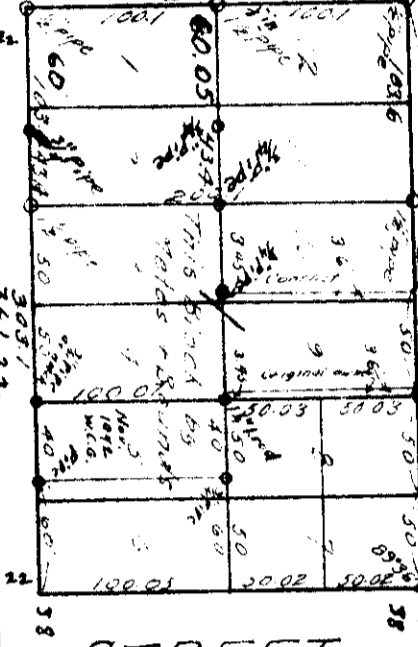
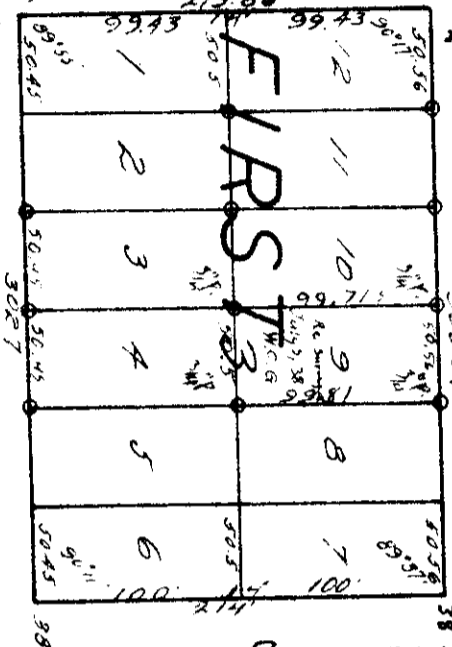
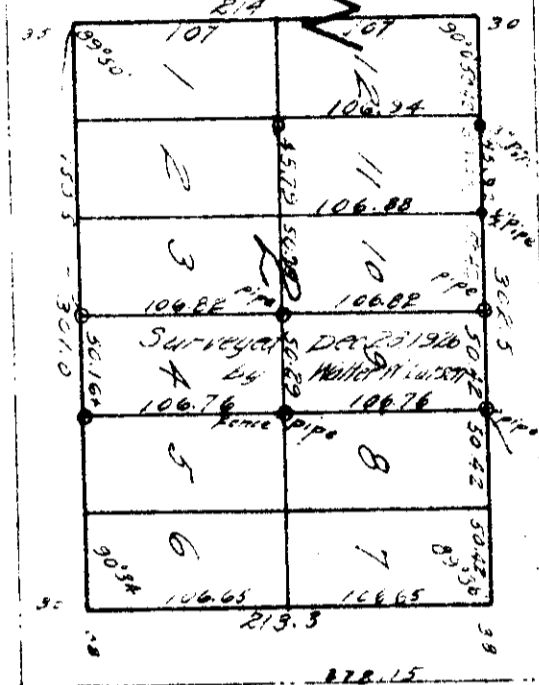
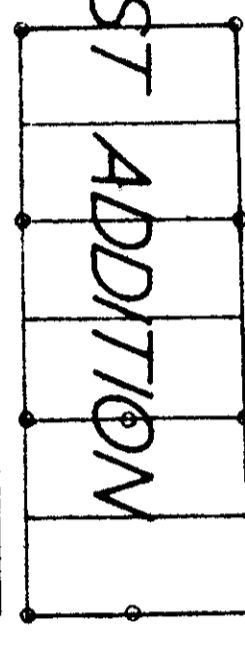


WILKINS

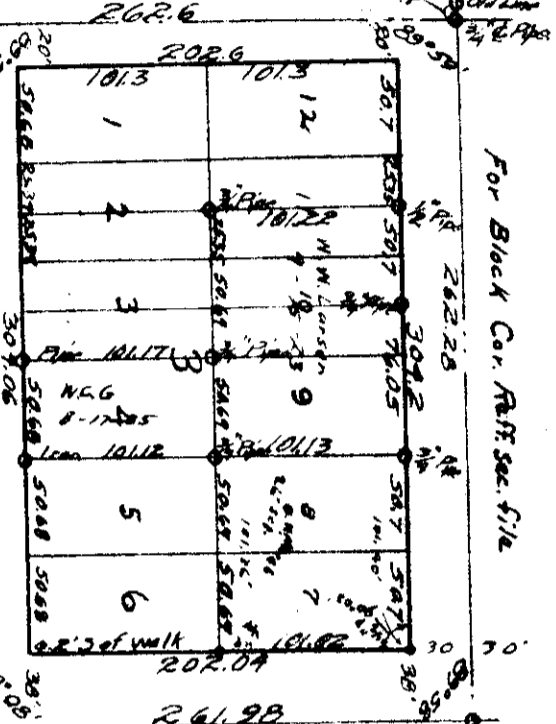






VAN BUREN STREET

See Plot 12A For this Block

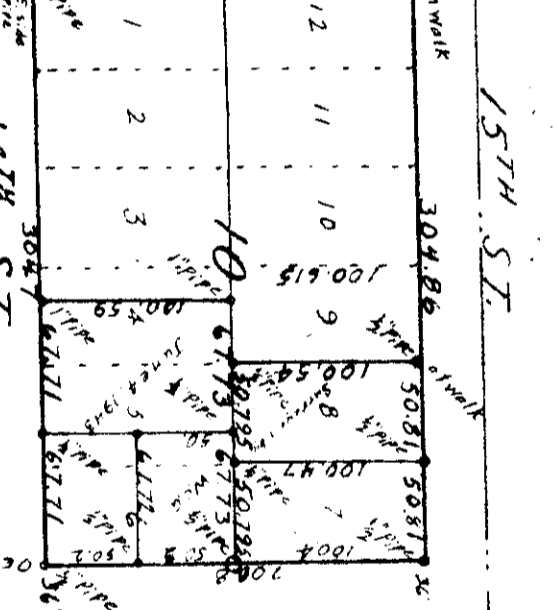
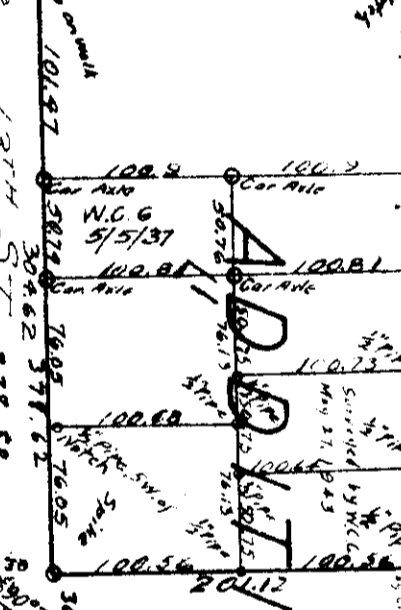
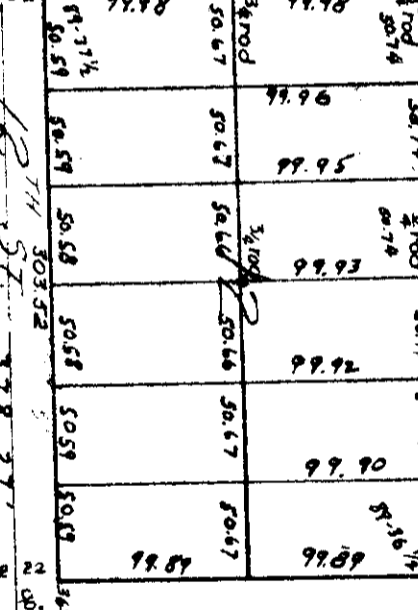
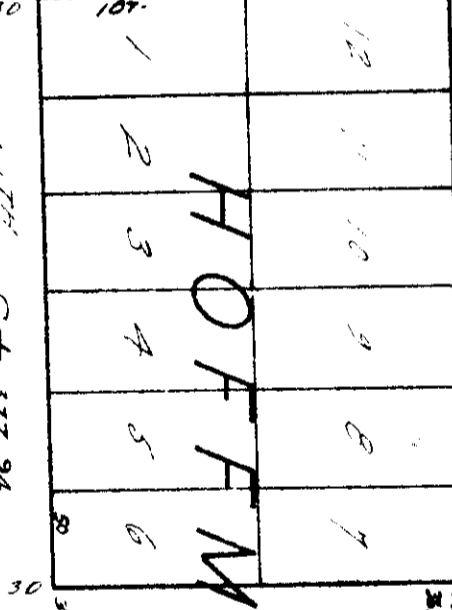
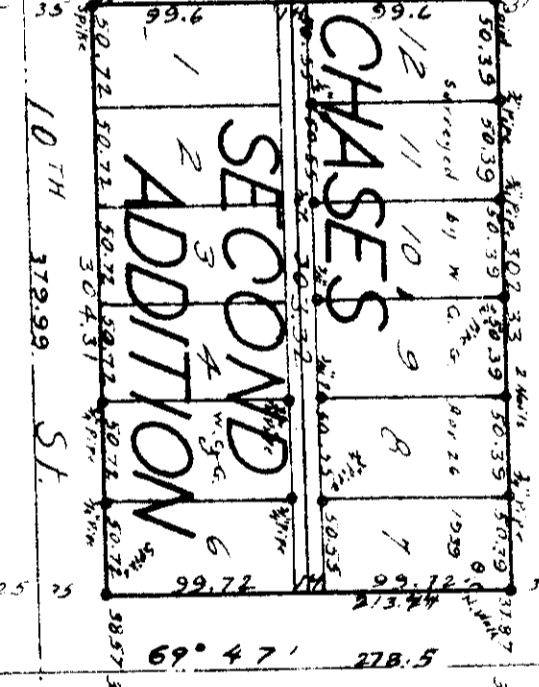


HARRISON STREET

See Plot 12A For this Block

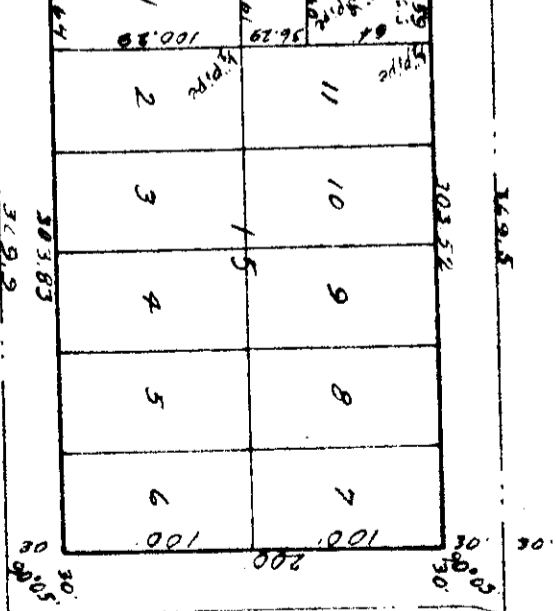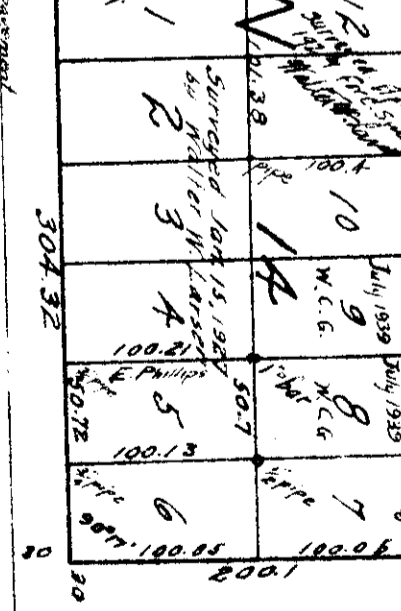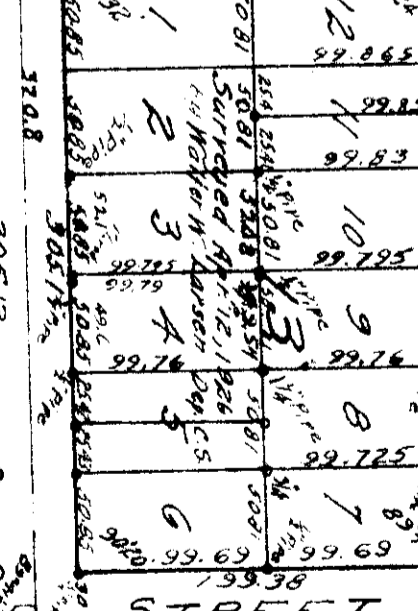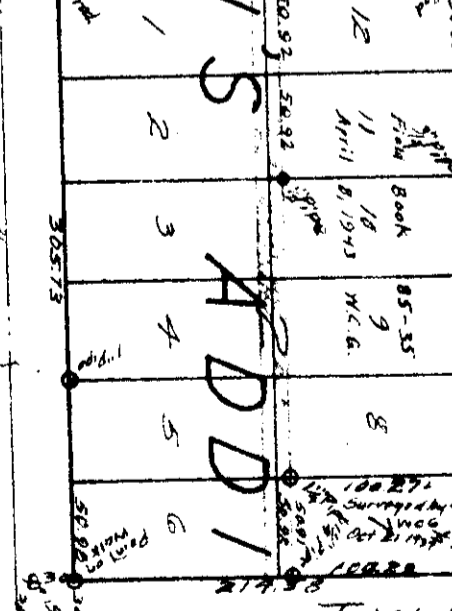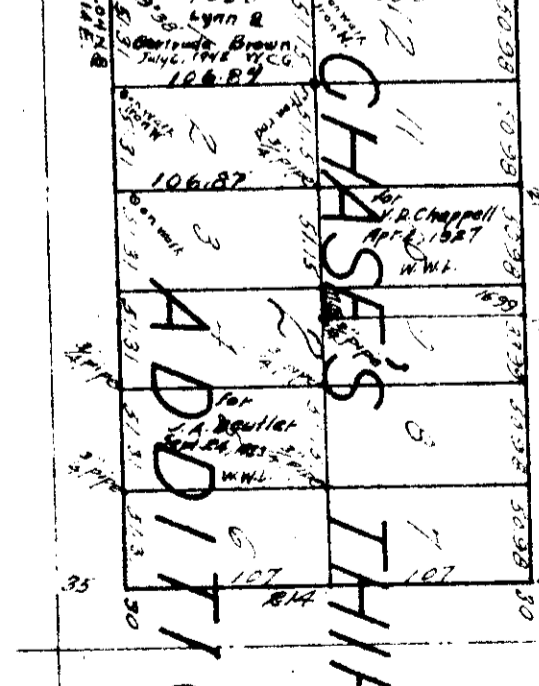

TYLER STREET

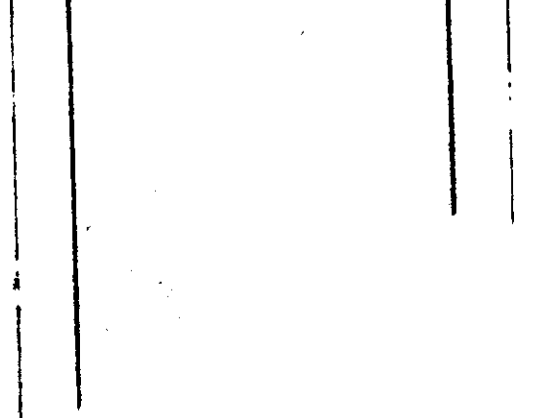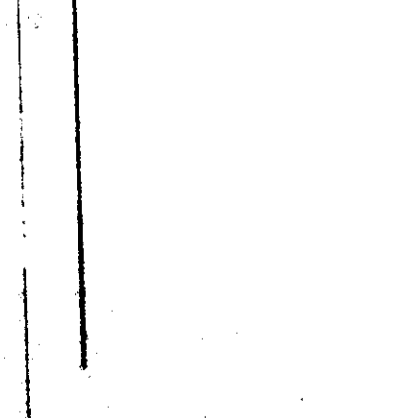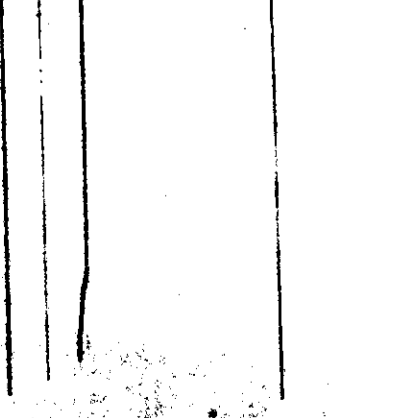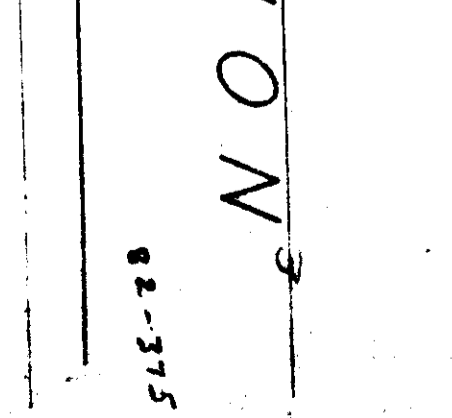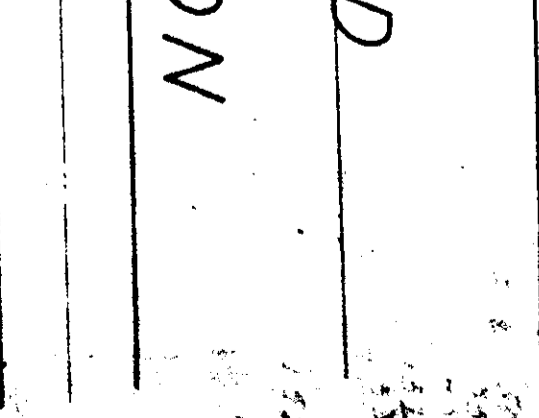

82-375