



Nice residence
Very fine people

Chimney

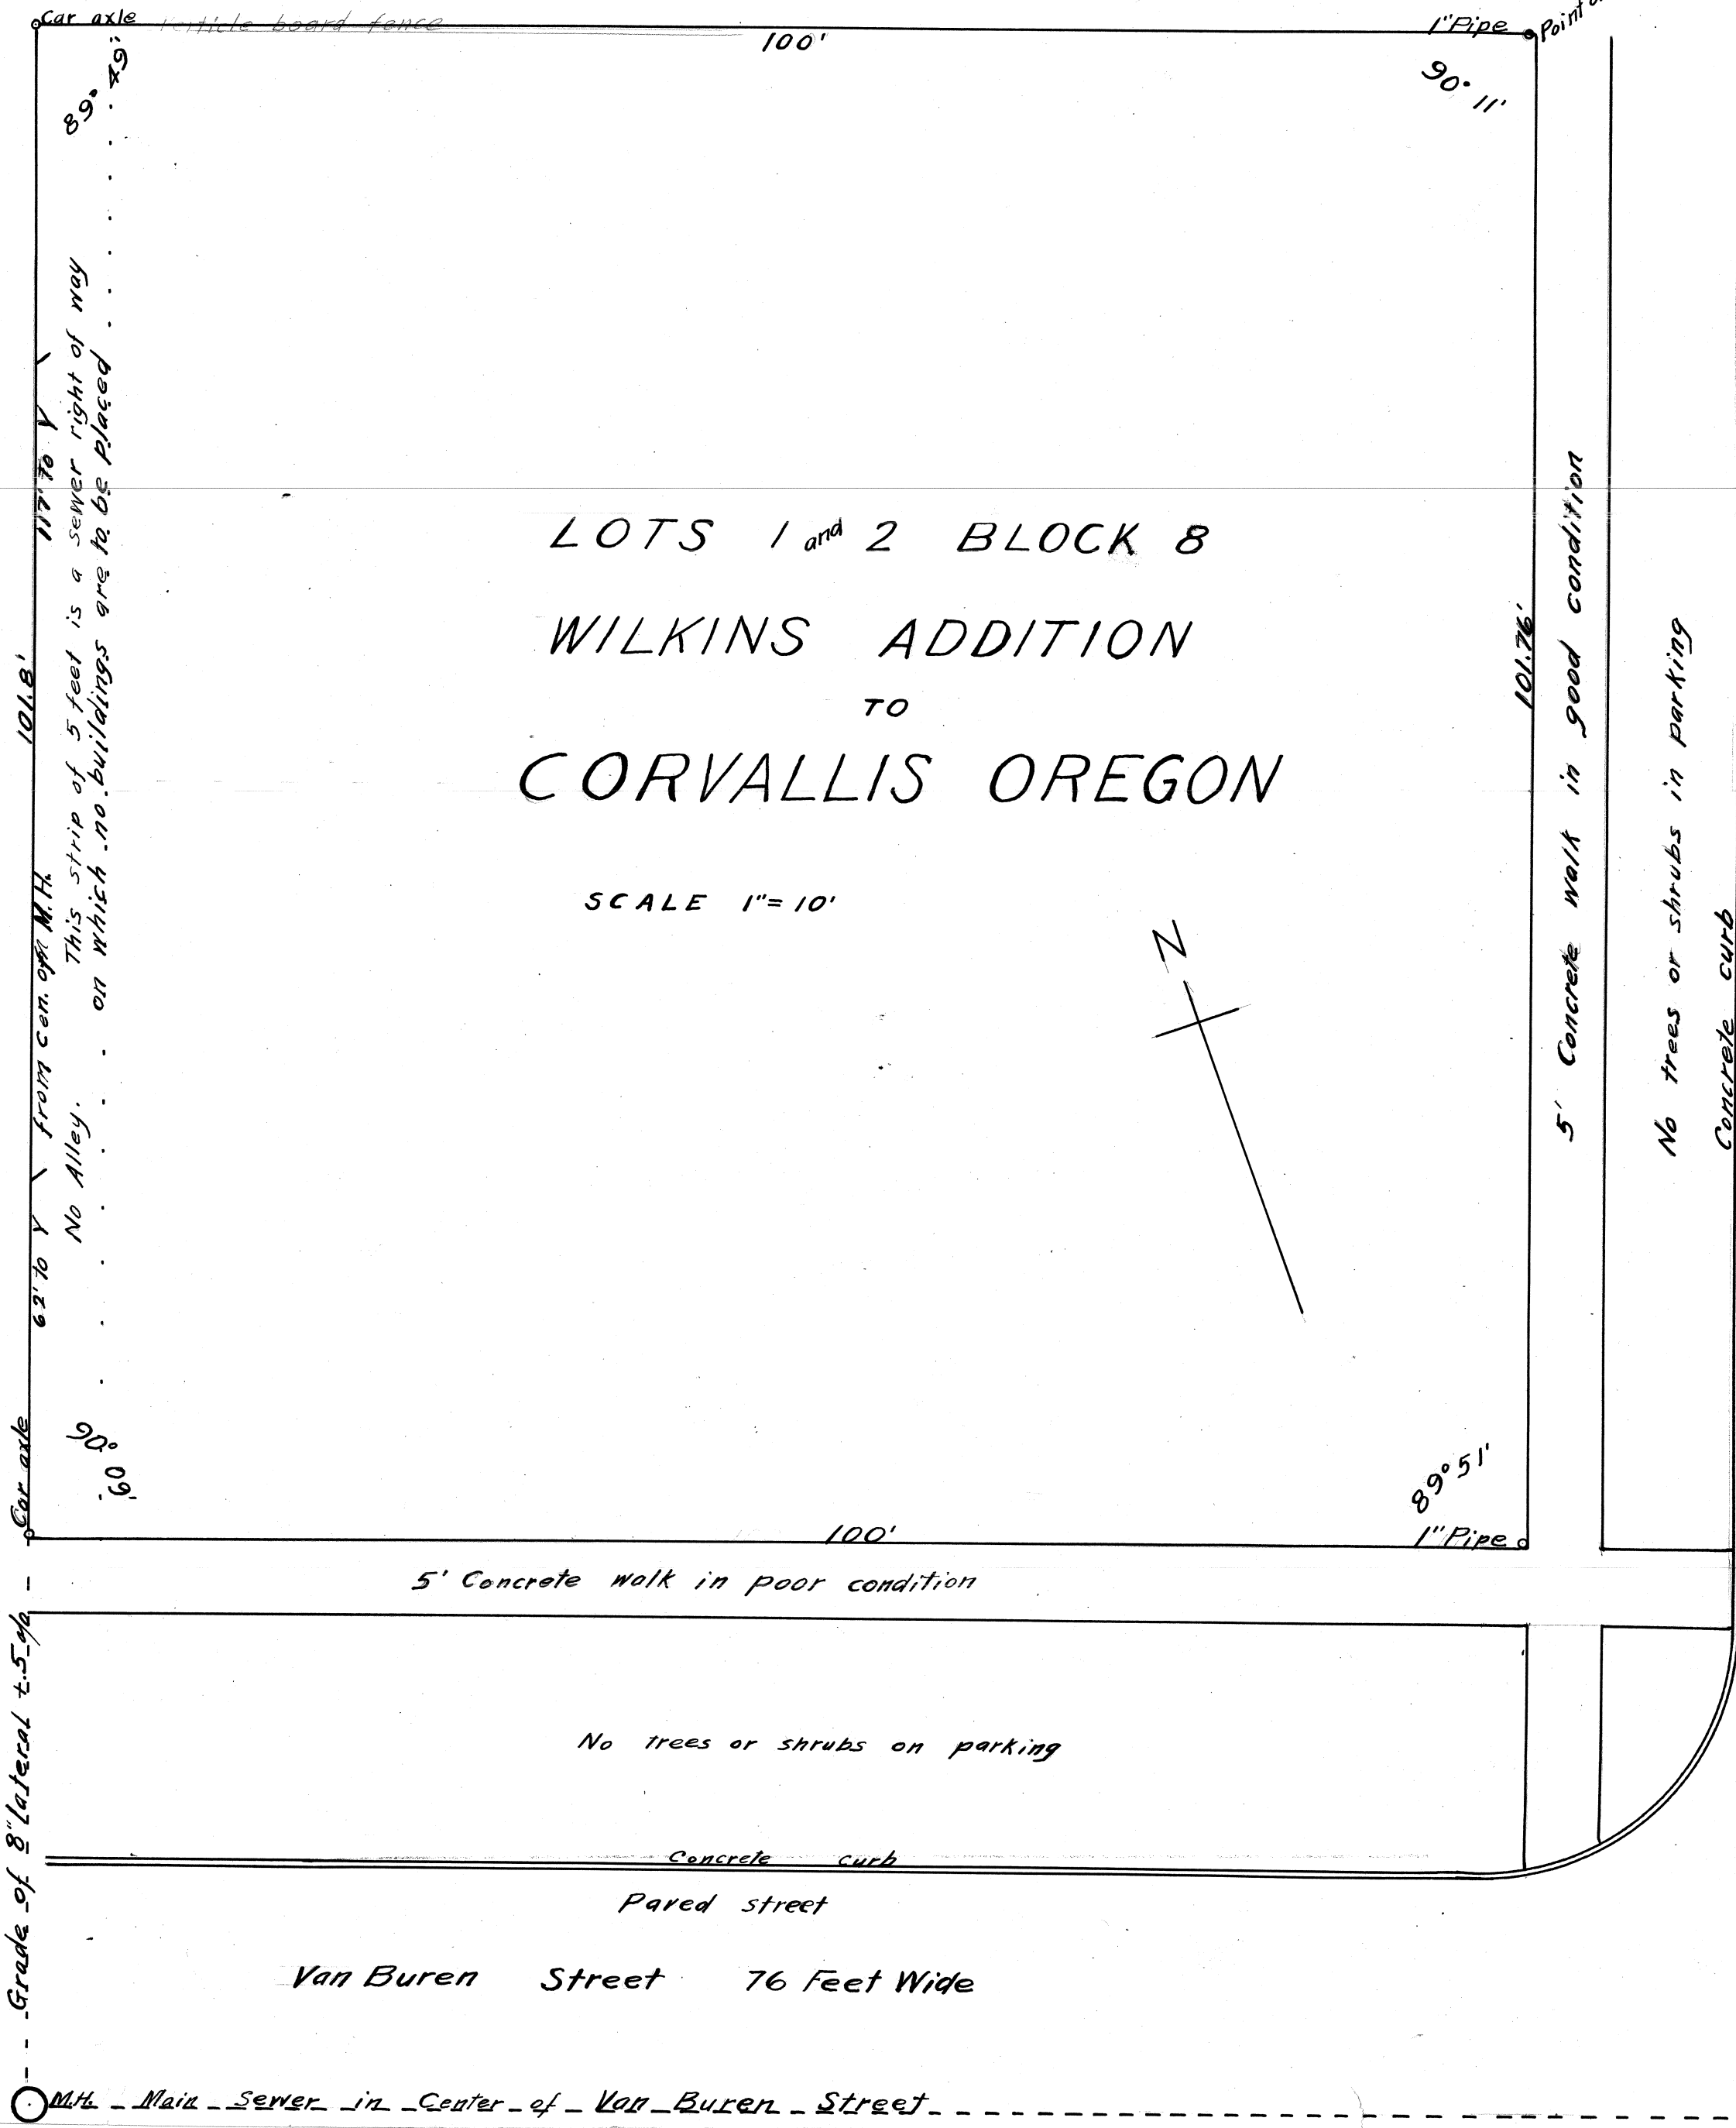

LOTS 1 and 2 BLOCK 8
 WILKINS ADDITION
 TO
 CORVALLIS OREGON

SCALE 1"=10'

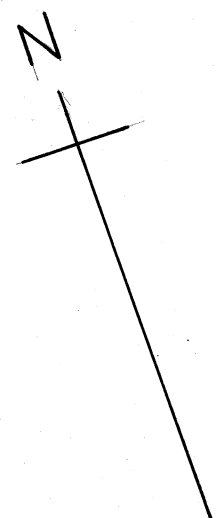

Car axle
 117' to Y
 101.8'
 from cen. of M.H.
 No Alley.
 62' to Y
 Car axle
 90° 09'
 Grade of 8" lateral 4.5-46
 M.H. Main Sewer in Center of Van Buren Street

particle board fence
 100'
 This strip of 5 feet is a sewer right of way on which no buildings are to be placed.
 5' Concrete walk in poor condition
 No trees or shrubs on parking
 Concrete curb
 Paved street
 Van Buren Street 76 Feet Wide

100'
 90° 11'
 1" Pipe Point on walk
 101.76'
 5' Concrete walk in good condition
 No trees or shrubs in parking
 Concrete curb
 Street paved 32' wide with concrete, in good condition
 16TH STREET 60' Wide

1" Pipe
 90° 51'
 1" Pipe