


See Plot 2

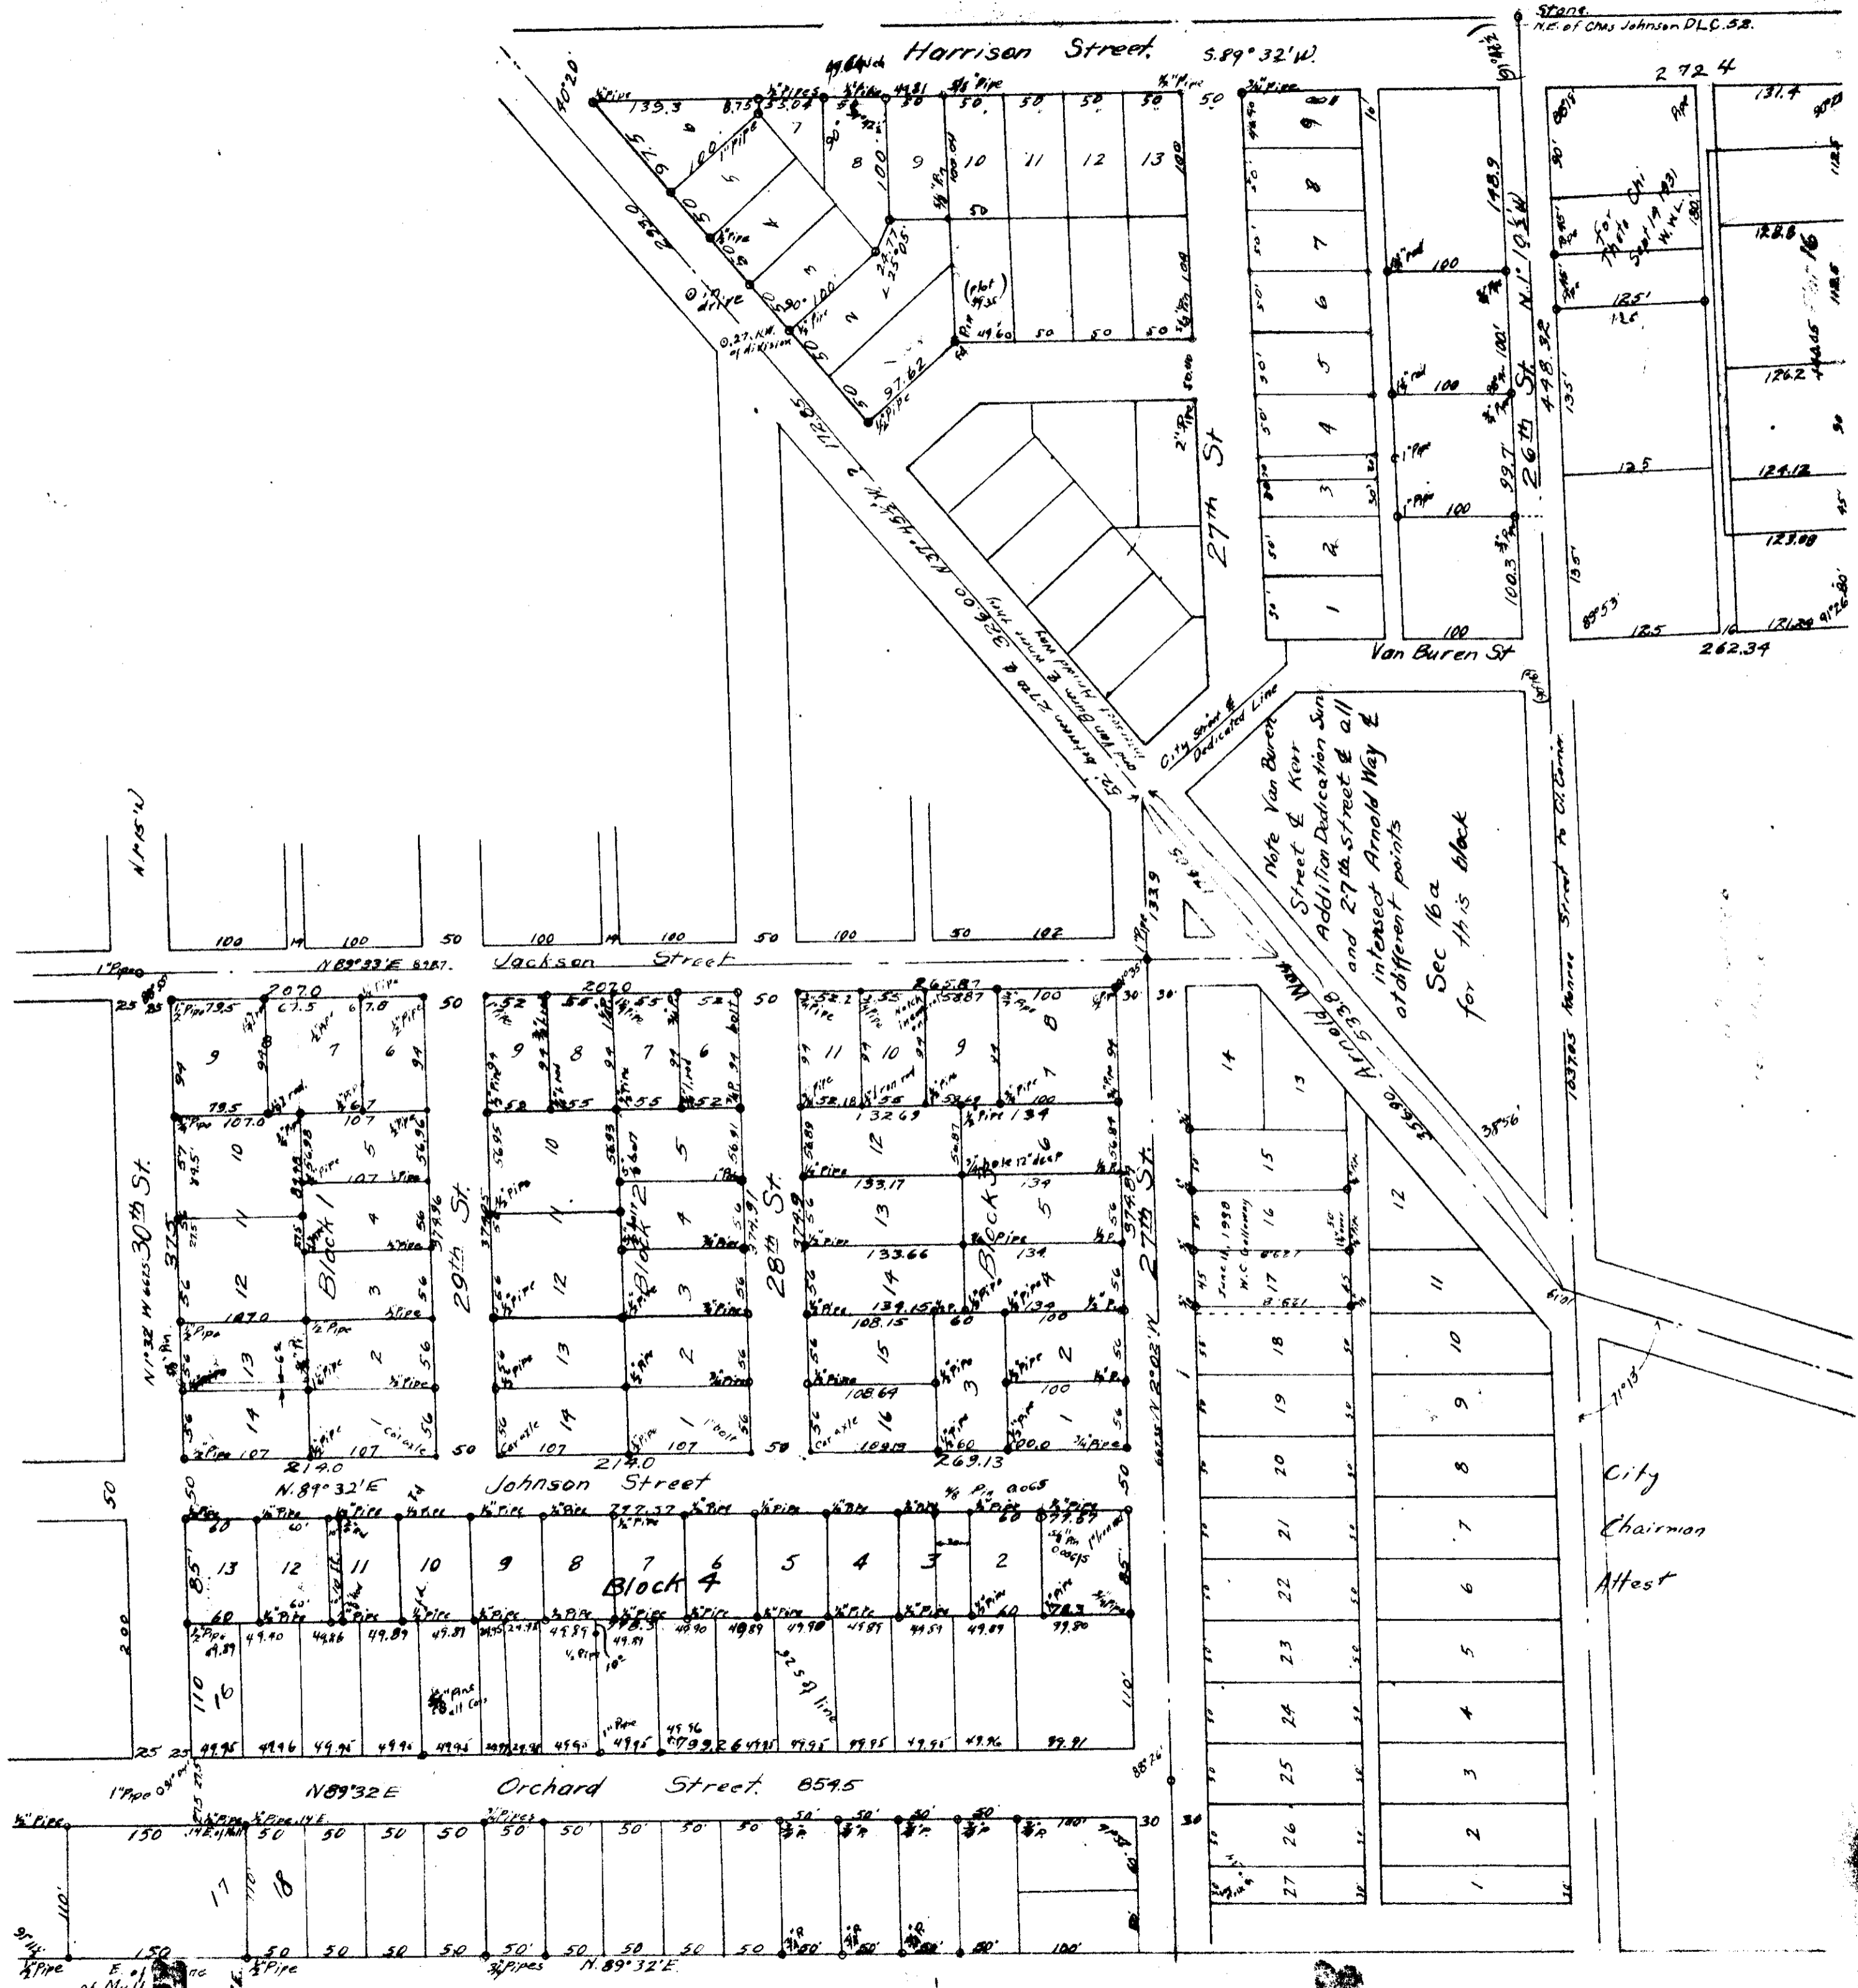

City  
Chairman  
Attest