


CP00021C

SUPPLY STATION PORTLAND GAS & COKE COMPANY CORVALLIS OREGON


Scale 1" = 20'

W. C. Hallaway Co. Engr.
Oct. 25, 1939

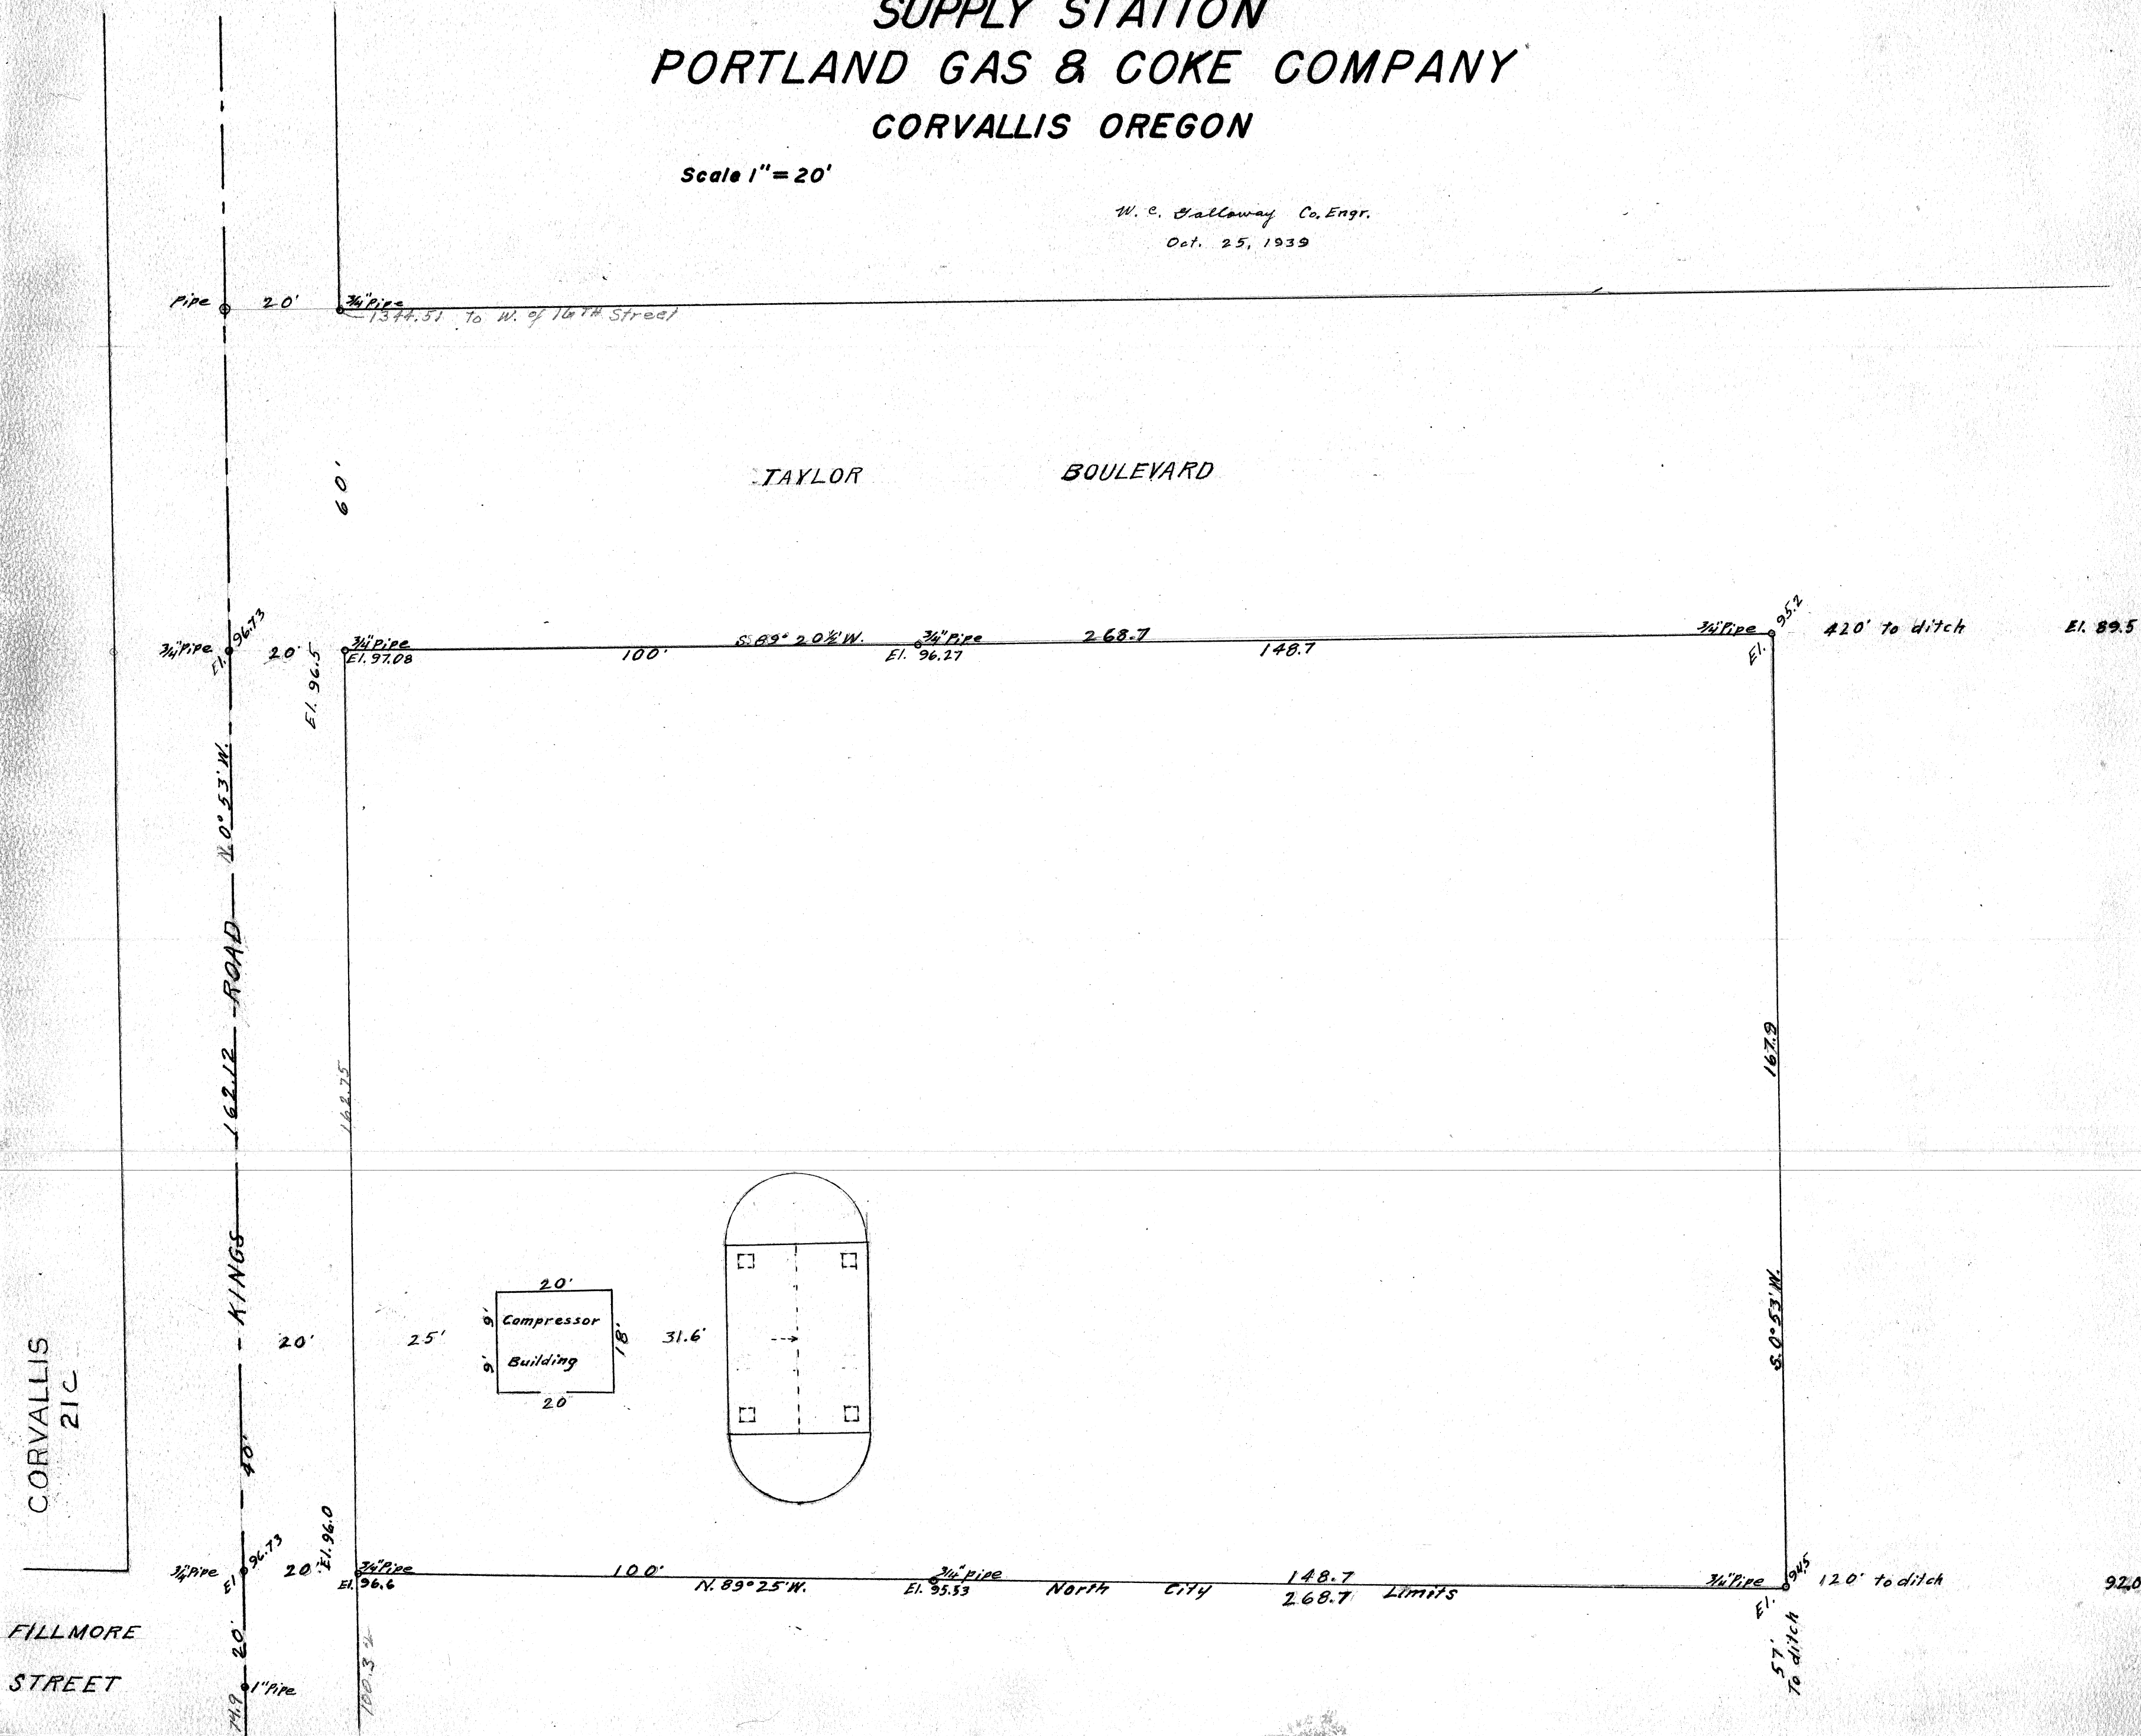

CORVALLIS
21C

FILLMORE
STREET

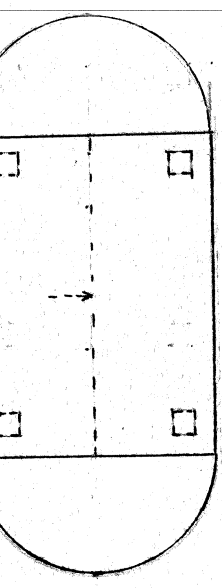

El. 89.5

92.0