


Mill Property  
of  
E.W. Fisher Estate  
City of  
Corvallis, Benton Co. Oregon  
Scale 1"=50'

Oct 31, 1913, by F. Marcon Wilkers  
B11-P41

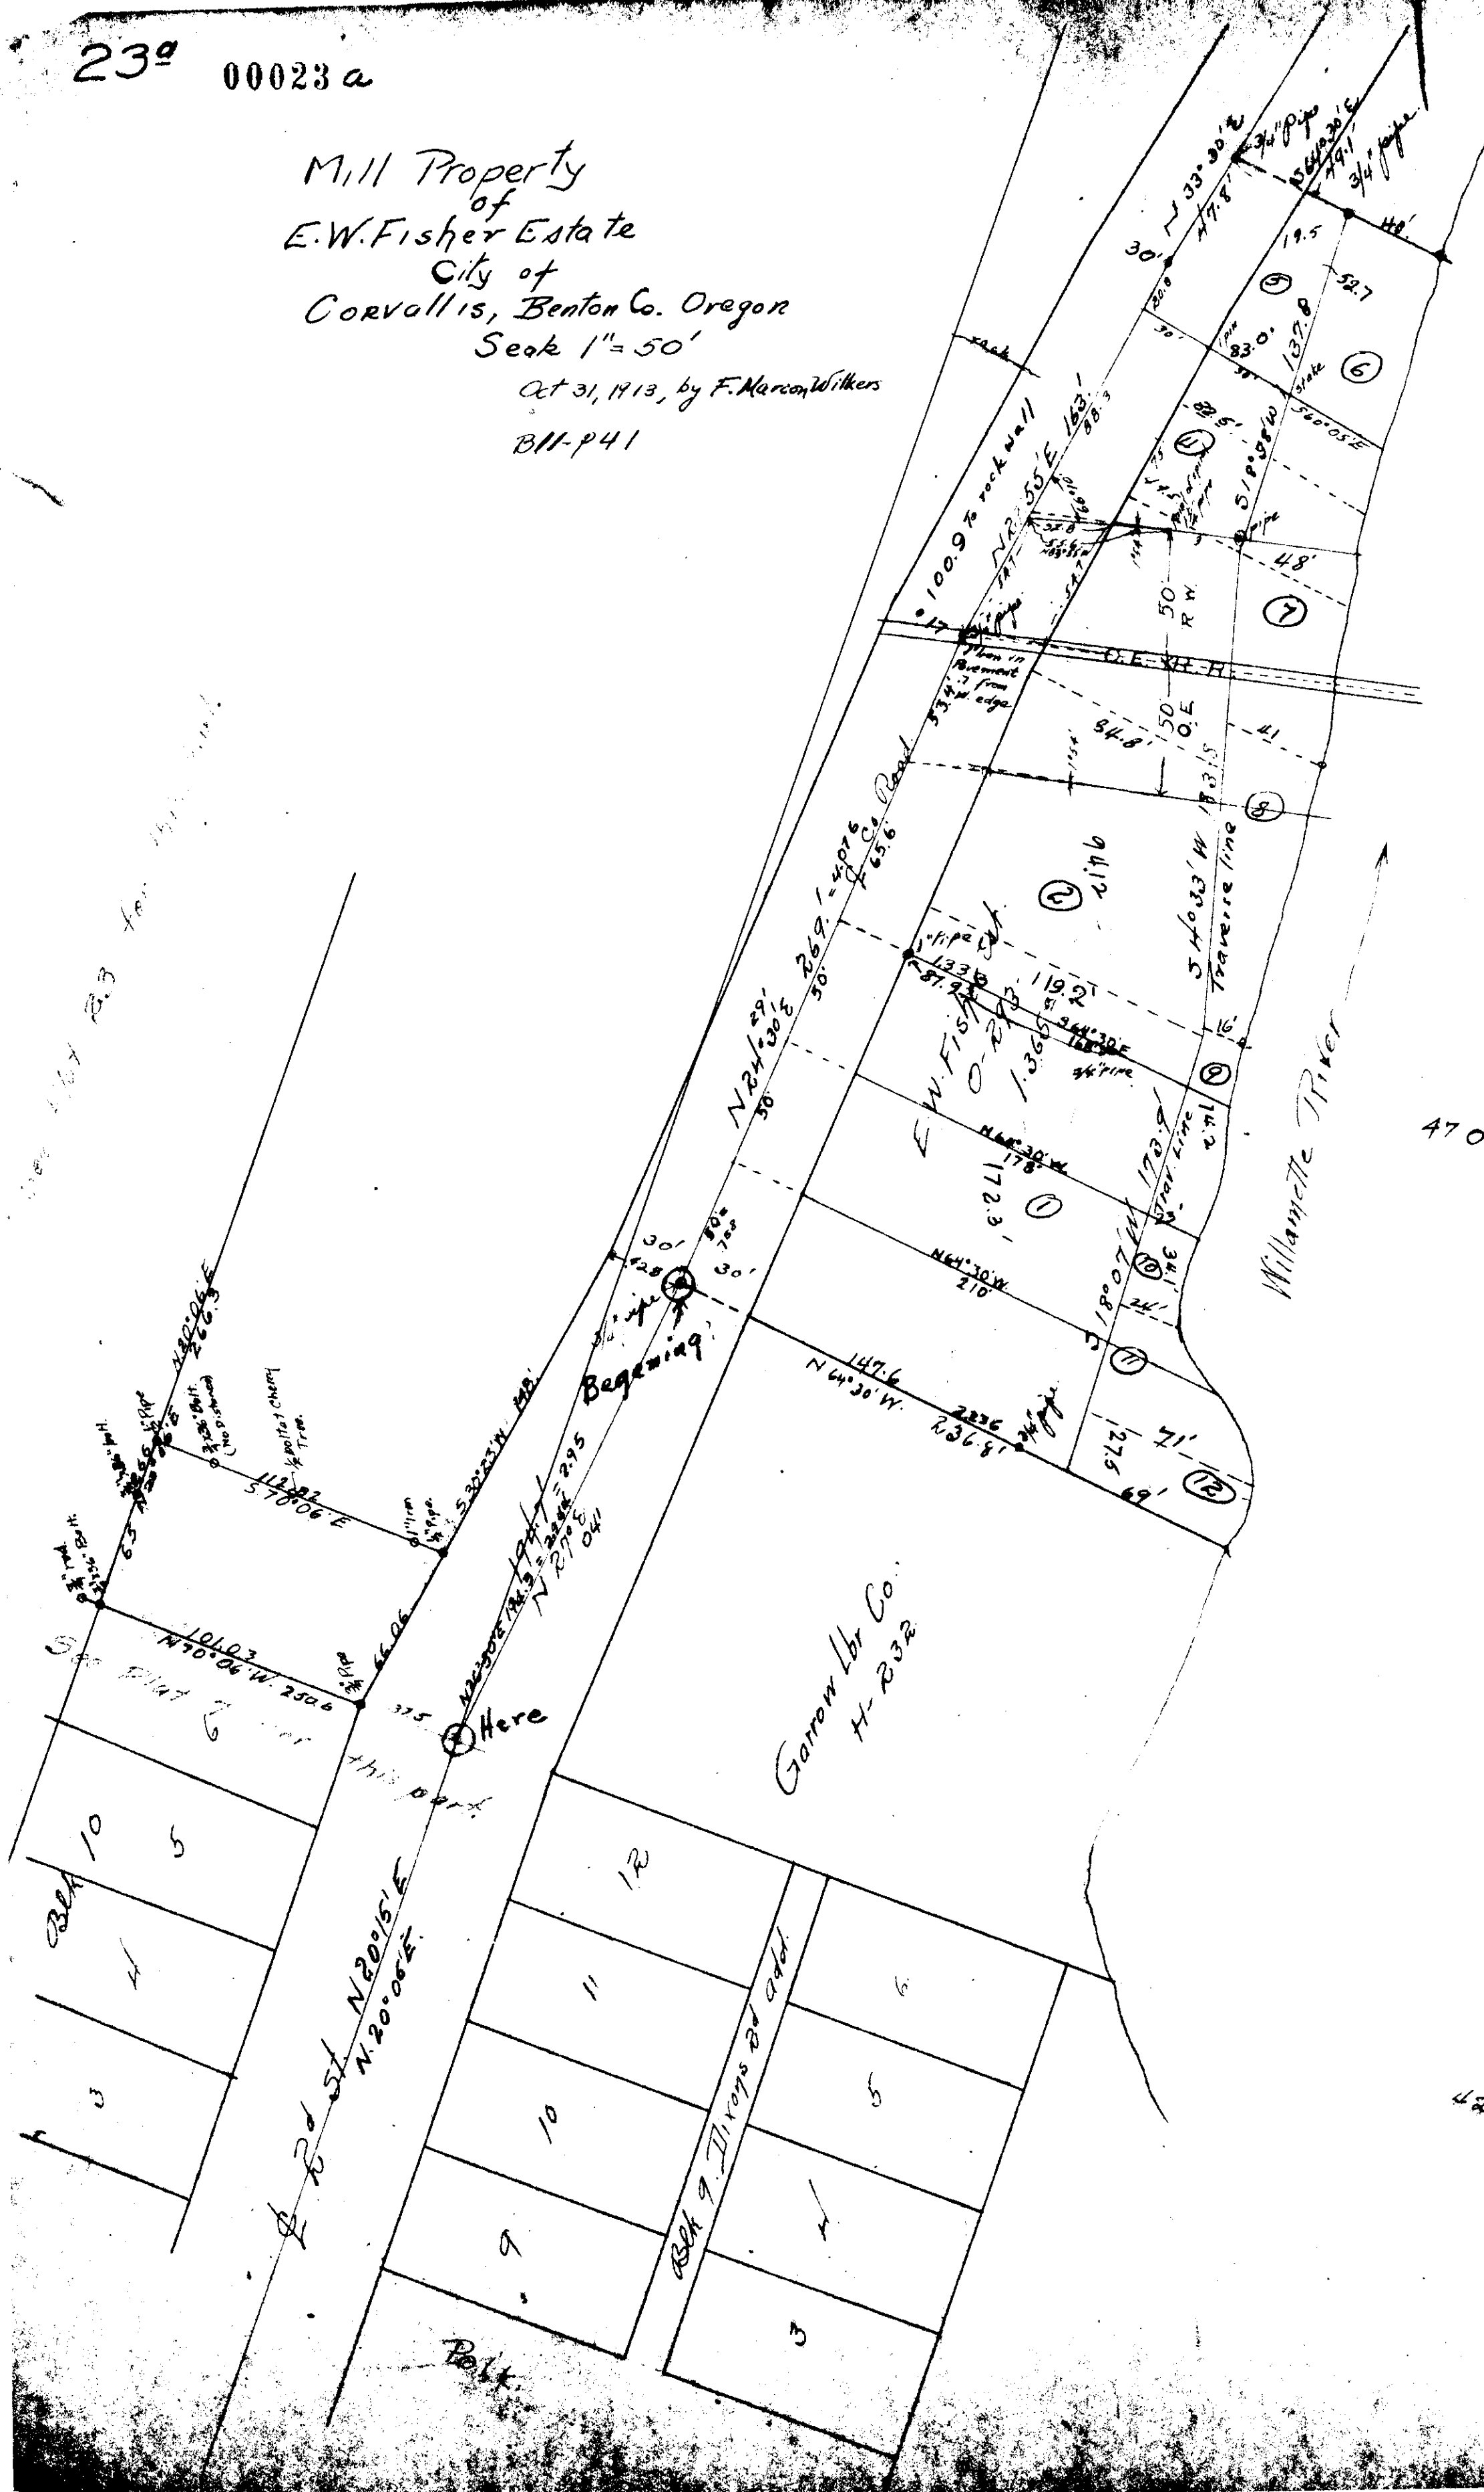

Areas

- ① = 22140.55 sq. ft.
  - ② = 9608.40
  - ③ = 5206.96
  - ④ = 3407.25
  - ⑤ = 1380.74
  - ⑥ = 5953.20
  - ⑦ = 2670.00
  - ⑧ = 3092.25
  - ⑨ = 1446.90
  - ⑩ = 801.35
  - ⑪ = 1904.75
  - ⑫ = 1925.00
- 
- 59537.35
- = 1.365 a

4701

4201