



No 2

Sec 188 or 221

Plat of Survey No. ~~26~~ #89

Claim No. 44-45, 60

MADE FOR Joe Smith.

Section Township 10


Range 145W


Scale: 20 Chns to the Inch.

Field Notes recorded at page, Vol., Record of Surveys.

Field Book 2 - p 24-31-32.  
3 - p 7-49.

Platted & filed in 10-5

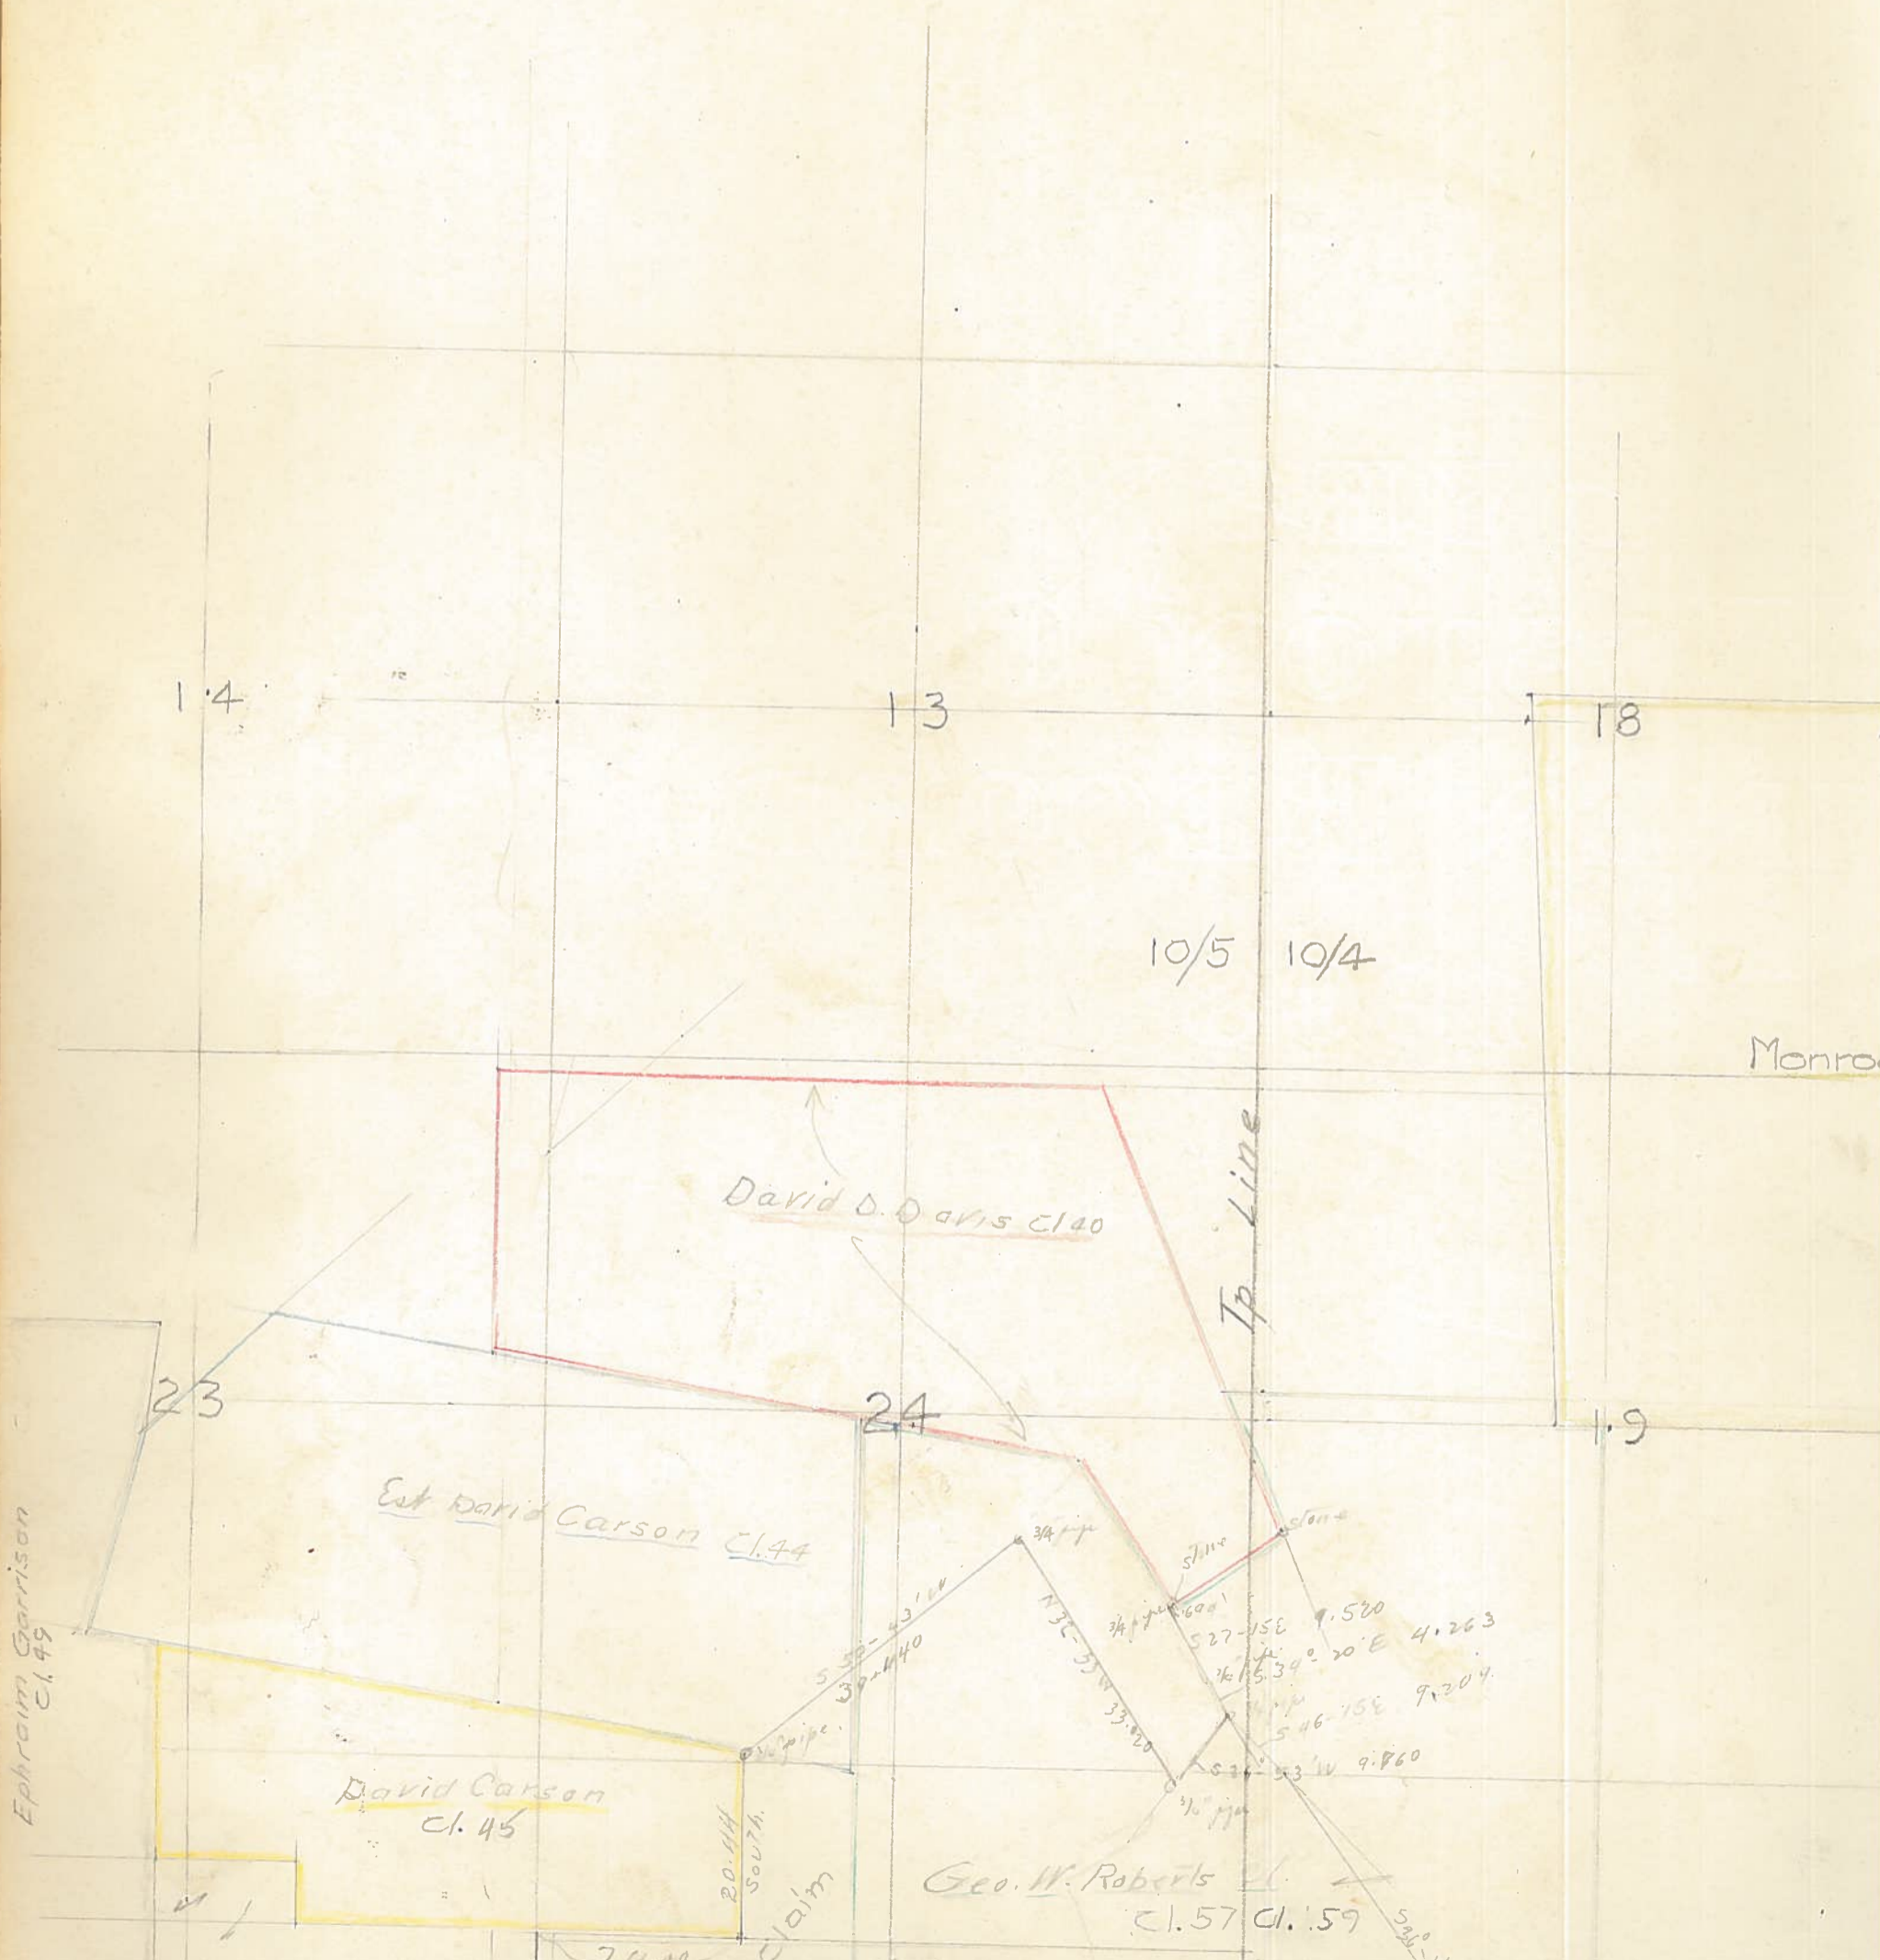

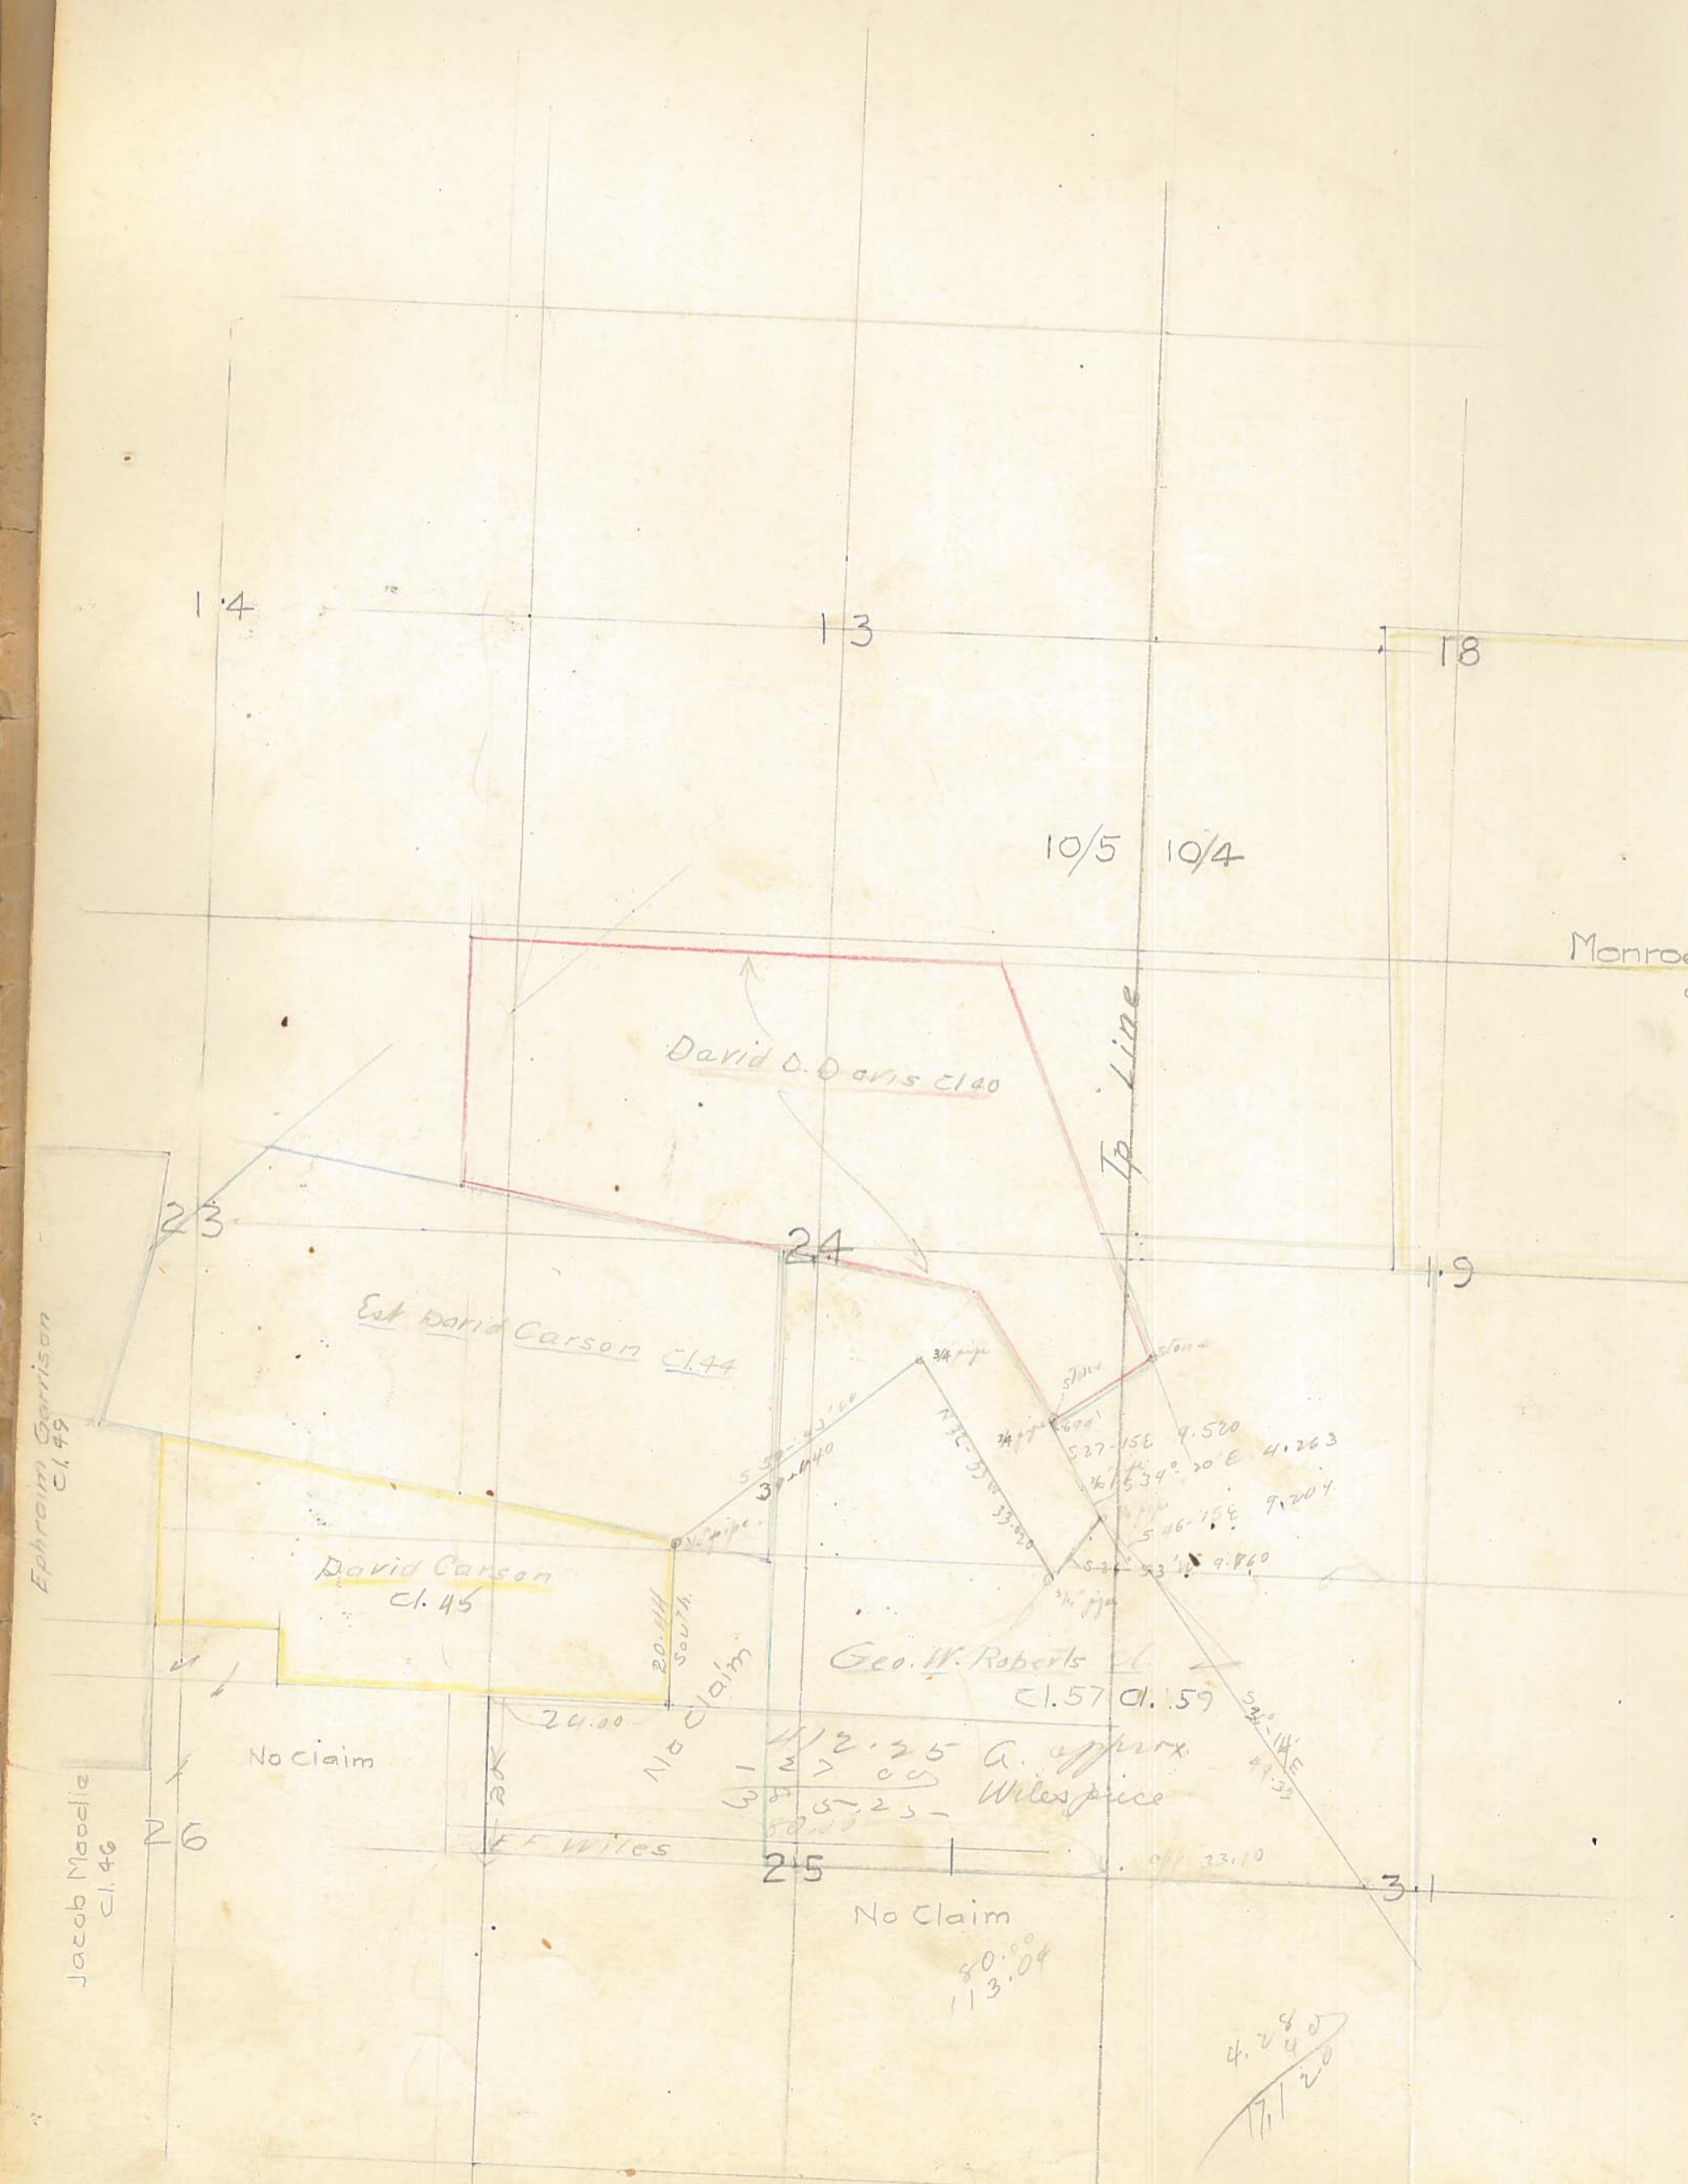

14 13 18

10/5 10/4

Monroe

David D. Carson cl. 40

Est David Carson cl. 44

David Carson cl. 45

Geo. W. Roberts cl. 57 d. 59

Ephraim Garrison cl. 49

Jacob Moodie cl. 46

No claim

No claim

No Claim

Tp Line

1/2.25 A. approx  
- 27.00 Wiles price  
38 5.25 -  
50.00

34 17  
S 27-15 E 9.520  
76 15 34 20 E 4.263  
5 46-15 E 9.204  
S 27-15 E 9.860

80.00  
113.04

4.280  
171.20

20.00 SOUTH

EF Wiles

off 23.10

25

31

26

23

24

2. Re enter. This S.M. ... of Hedges Cl. 7.08.

**#89**

Name	F	S	#	Horizontal	Vertical	Area
6-25	9.62	224.1	✓			
8-25	15.02	136.3	✓			
5-25	31.63	379.9	X2			
6-57	55.71	561.4	✓			
	70.89	355.3	✓			
8-25	81.50	250.4	✓			
12-15	92.67	267.3	✓			
9-50	✓	511.	✓			
6-10	✓	570	✓			
	151.88	391.	✓			
	157.18	123.6	✓			
7-95	161.73	107.	✓			
		257.	✓			
		570.	✓			
		740.3	✓			

Continued on Pg 31

**#89**

N 9° E 2.12

Area	Height	Area	Area
135.4 X 9	1427.2	135.4 X 2	270.8
377.7 X 9	3400.2	377.7 X 2	755.4
561.4 X 9	5053.2	561.4 X 2	1122.8
352.2 X 9	3169.8	352.2 X 2	704.4
247.2 X 9	2224.8	247.2 X 2	494.4
261.2 X 9	2351.2	261.2 X 2	522.4
492.6 X 9	4433.4	492.6 X 2	985.2
428.2 X 9	3854.2	428.2 X 2	856.4
497.1 X 9	4473.9	497.1 X 2	994.2
391.4 X 9	3522.6	391.4 X 2	782.8
123.6 X 9	1112.4	123.6 X 2	247.2
106.1 X 9	954.9	106.1 X 2	212.2
221.1 X 9	1989.9	221.1 X 2	442.2
3767.0			
1497.3			
5264.3			