RECORD OF SURVEY

for STARKER FORESTS, INC.

in the S1/2 SECTION 10, T11S, R7W, W.M. and the SW1/4 SECTION 11, T11S, R7W, W.M. BENTON COUNTY, OREGON MAY 20, 2005



Benton County Surveyor's Office

C.S. FILE NO. 10044 FILING DATE 9-6-05

(1) SW CORNER SECTION 10

Found 3" octagonal bolt with 1 1/2" iron pipe alongside per GHC | | -7-0000 | and BCCR 3330 BT's found:

14" Fir, (N33°E, 95.0 ft.) 32" Alder, (SO1°E, 52.7 ft.) 20" Maple, (\$39°W, 65.0 ft.) Healed face

32" Fir Stump, (N28°W, 73.4 ft.) Scribing visible Found 3/4" square iron rod, (South, 64') Corner lies in swampy area, 40' East of fork in gravel road.

Healed face

Bark scribing visible

(2) 1/4 CORNER SECTIONS 10 & 15

Found 3/4" bolt per GHC 11-7-00005 with railroad iron (per BCCR 1026) alongside.

BT's found: 34" Rotted Fir Stump, (N47°W, 175.2 ft.) Scribing visible 24" Rotted Fir Stump, (N62°E, 1.149 chs.) No marks visible 40" Rotted Fir Stump, (N25°W, 0.77 chs.) No marks visible 20" Fir, (N68°E, 29.8 ft.) Healed face 6" Alder Snag, (SO4°E, 26.7 ft.) Bark scribing visible Corner lies on gentle South slope, 200' South of gravel road.

(3) SE CORNER SECTION 10

Found I" X 24" iron rod (badly bent) per GHC II-7-00005 Referenced where straight and replaced with 5/8" X 30" iron rod with plastic cap (LS 1084).

Rotted Fir Stub, (NO7°W, 0.26 chs.) No marks visible 24" Maple, (S29°E, 0.600 chs.) Rotted Fir Stub, (N49°W, 0.150 chs.) No marks visible Corner lies on South slope, 20' North of creek.

(4) ANGLE POINT NO. 1 - SECTION 10

Found 5/8" iron rod (cap gone) - C.S. 8413 BT's set 20" W. Fir, S55°W, 34.6 ft. Marked: "API SIO BT" 18" Fir, N29°W, 32.4 ft. Marked: "API SIO BT" Corner lies 5' East and 2' South of fence corner.

NARRATIVE

The purpose of this survey is to define the boundary between Tax Lots 600 and 700 of Tax Map | | -7-|| and Tax Lot 100 of Tax Map 11-7-10, and to mark the indicated boundary lines.

Tax Lot 100 of Tax Map 11-7-10 is described by M32409-81. Tax Lot 600 of Tax Map 11-7-11 is described by M230117-97. Tax Lot 700 of Tax Map 11-7-11 is described by M57966-84.

C.S. 8412, C.S. 8413, and C.S. 9421 have monumented the West line of Tax Lots 600 and 700, and the Northwest corner of Tax Lot 600. We have established the North line of Tax Lot 600 parallel to the South line of Section II as monumented by C.S. 9277.

Monuments found as per GHC 11-7-00001, 11-7-00005, C.S. 3733, C.S. 8412, C.S. 8413, C.S. 8890, C.S. 9277, C.S. 9421, BCCR's 1020, 1022, 1024, 1026, and 3330 were held as control for this survey.

> $(A) = NOO^{\circ}O9'31''W 37.36'$ [NOO°04'44"W, 37.50']

(B) = NOO°03'02"W 158.89 [NOO°04'44"W, 158.75']

(C) = SO0°16'07"W 196.11' [\$00°10'00"W, 196.19'] <\$00°10'00"W, 196.25'>

SURVEYED BY: PETERSON & ASSOCIATES 8155 NW MITCHEL DRIVE CORVALLIS, OREGON 97330

PHONE: 541-757-1794

REGISTERED PROFESSIONAL ATAD SURVEYOR OREGON JULY 31, 1976 JIM S. PETERSON RENEWAL: 12-31-06

Monuments found as noted

Found 5/8" iron rod with plastic cap (LS 2663) per C.S. 9277

Found 5/8" iron rod with plastic cap (LS 1901) per C.S. 8412 8 8413

Found 5/8" iron rod with plastic cap (LS 2088) per C.S. 9421

Set 5/8" X 30" iron rod with plastic cap (LS 1084)

() Data of record as per GHC 11-7-00005

[] Data of record as per C.S. 9421

{ } Data of record as per C.S. 8412 & C.S. 8413


Data of record as per C.S. 9277

Noundary lines marked with 6' fiberglass posts,

blue painted blazes, and blue flagging GHC Galloway Hard Copy

Approximate creek centerline

BCCR Benton County Corner Restoration

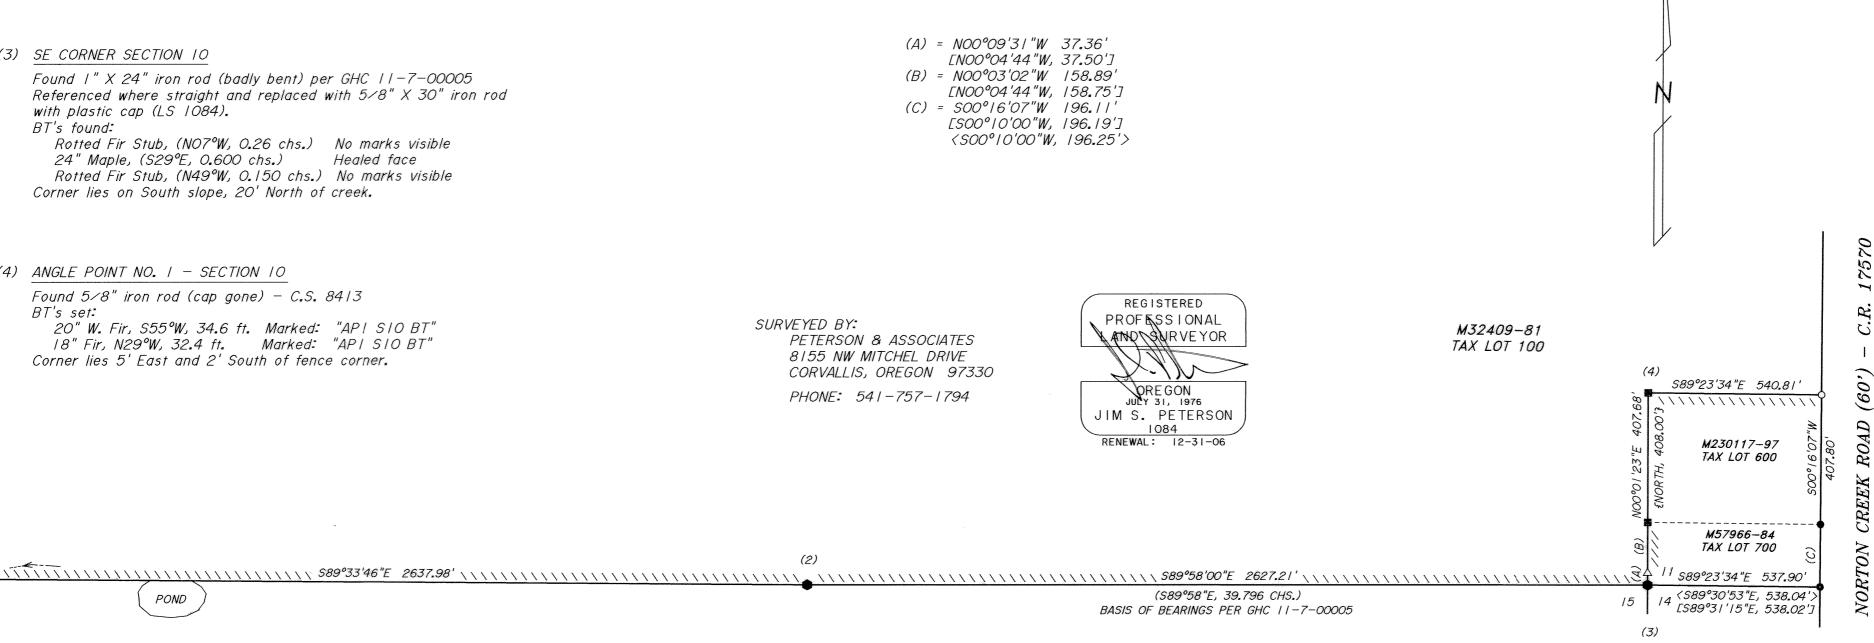

(\$89°58"E, 39.796 CHS.)

BASIS OF BEARINGS PER GHC 11-7-00005

CO5-03 SO5-03