


POSITION EDGE OF PRINT ON THIS LINE

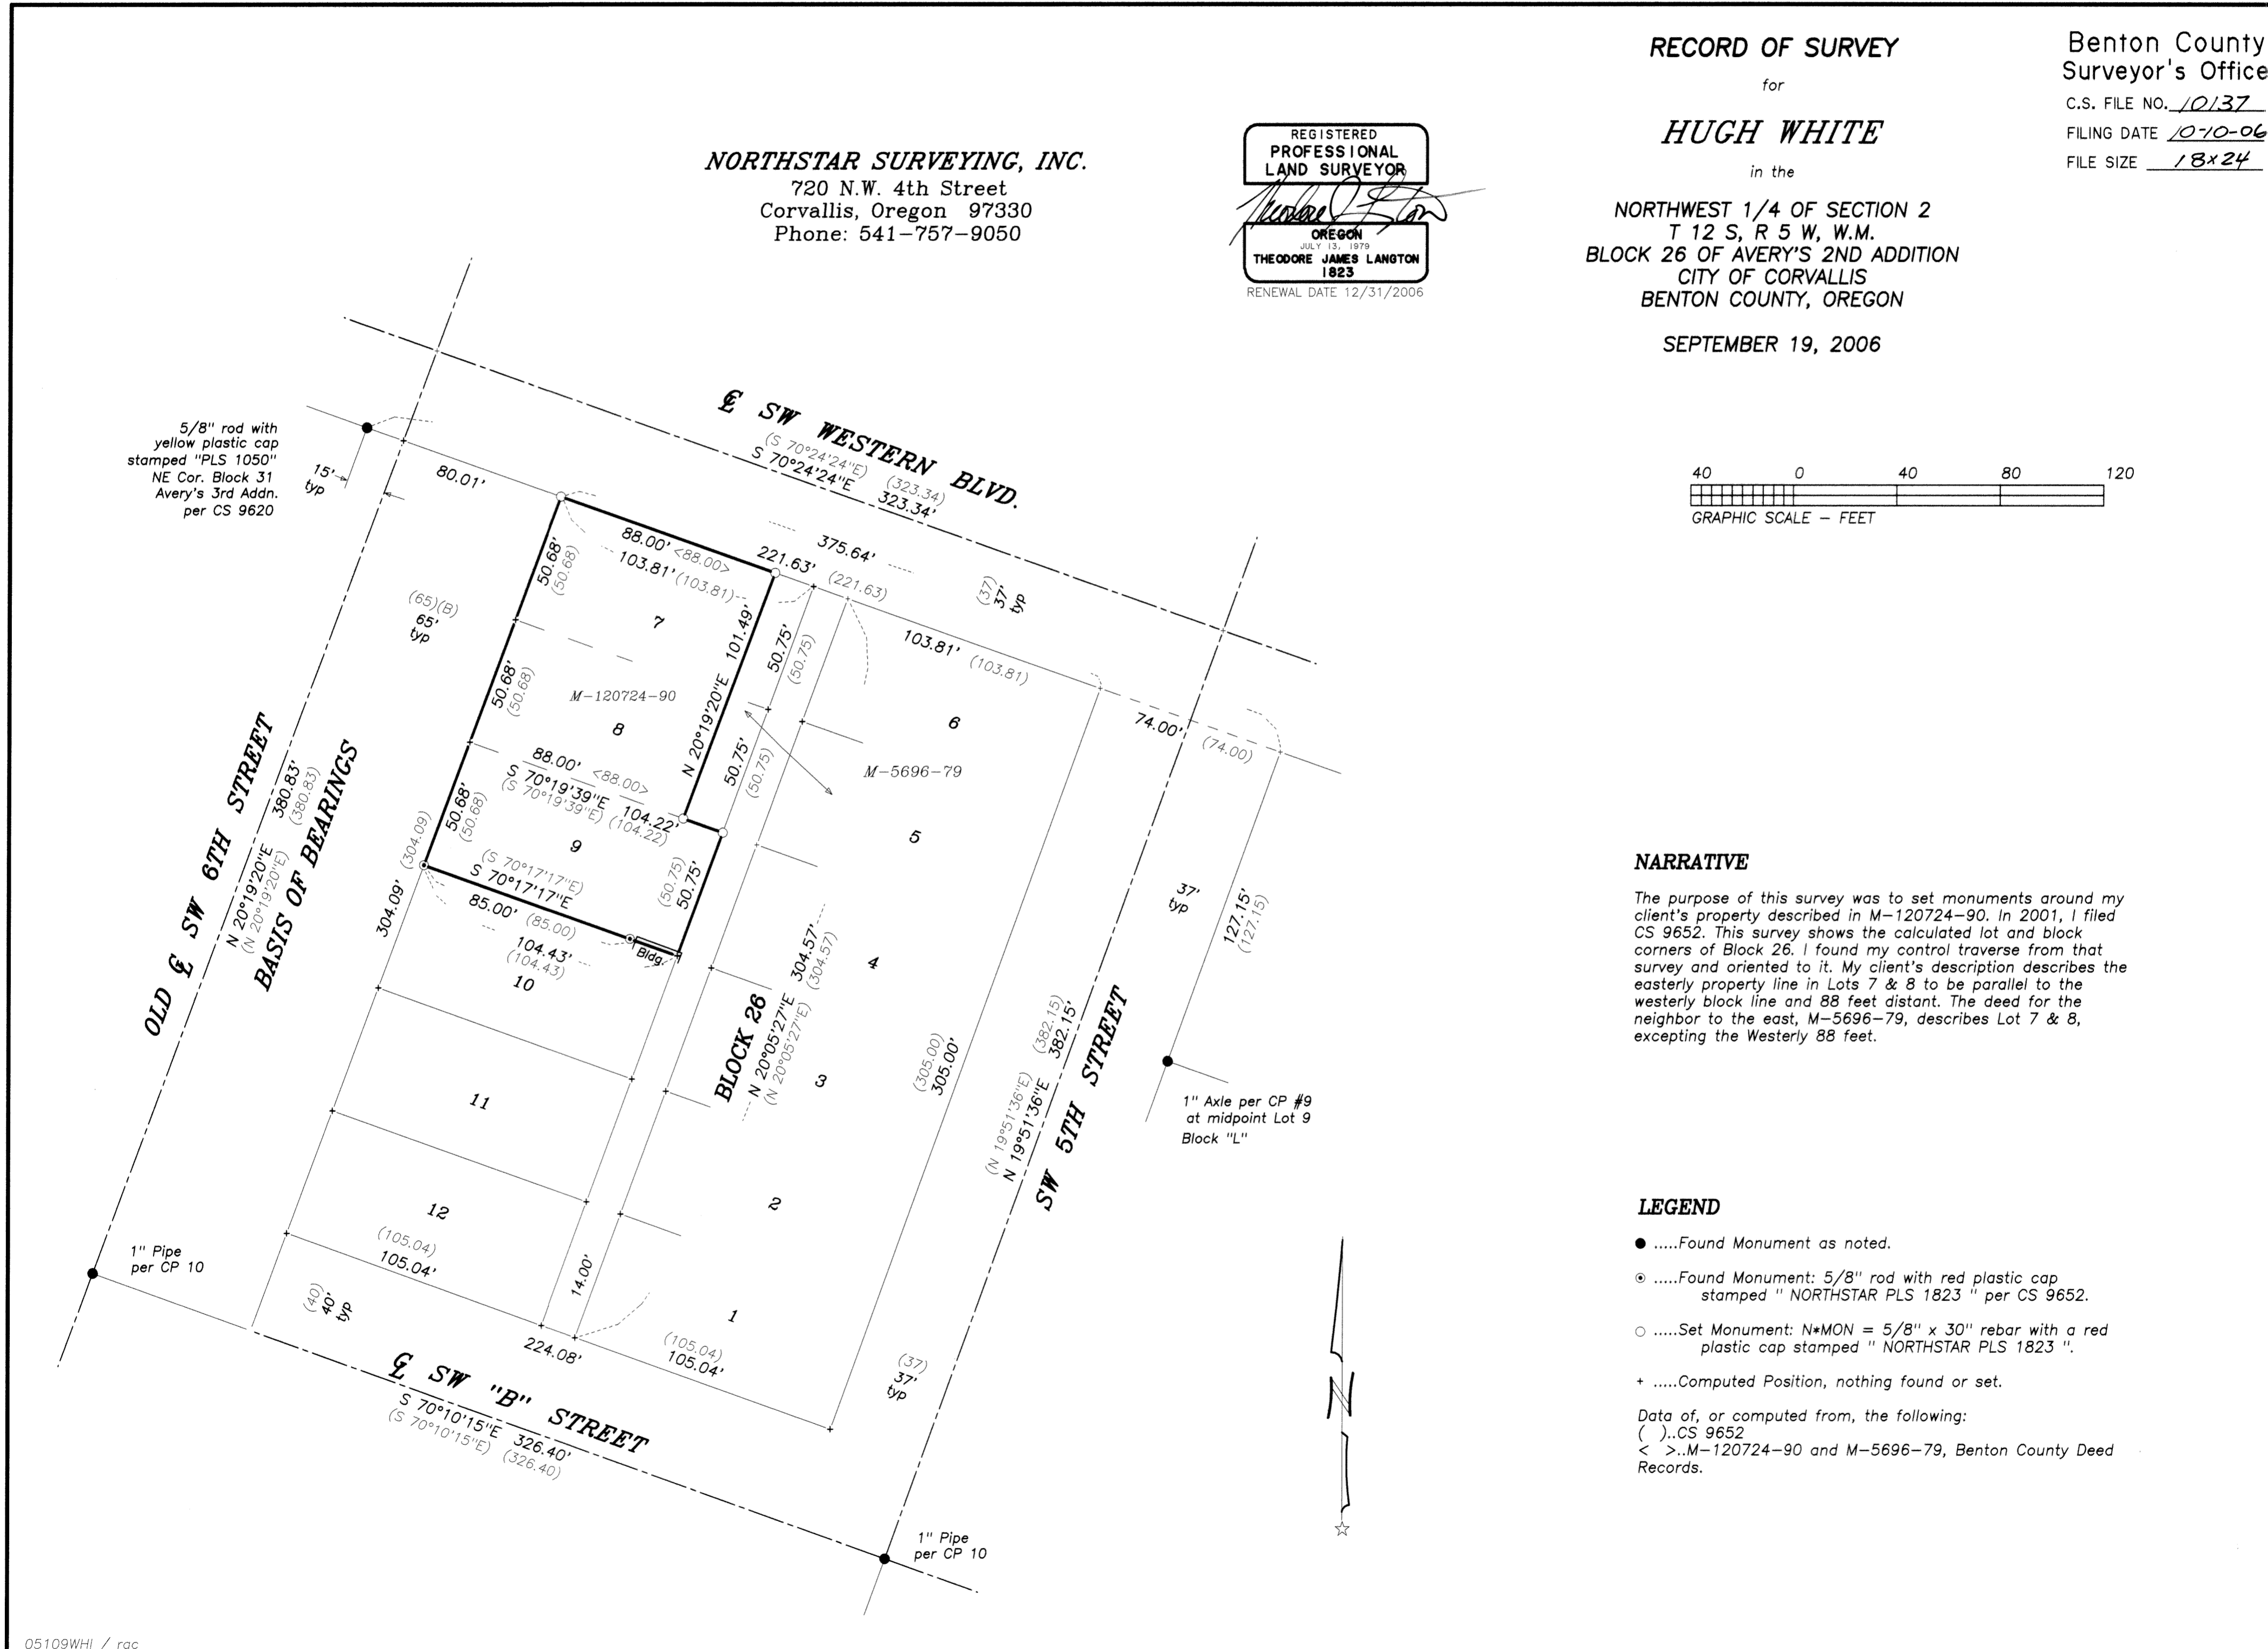

**NORTHSTAR SURVEYING, INC.**  
720 N.W. 4th Street  
Corvallis, Oregon 97330  
Phone: 541-757-9050

REGISTERED PROFESSIONAL LAND SURVEYOR  
*[Signature]*  
OREGON  
JULY 13, 1979  
THEODORE JAMES LANGTON  
1823  
RENEWAL DATE 12/31/2006

**RECORD OF SURVEY**

for

**HUGH WHITE**

in the

NORTHWEST 1/4 OF SECTION 2  
T 12 S, R 5 W, W.M.  
BLOCK 26 OF AVERY'S 2ND ADDITION  
CITY OF CORVALLIS  
BENTON COUNTY, OREGON

SEPTEMBER 19, 2006

Benton County Surveyor's Office

C.S. FILE NO. 10137  
FILING DATE 10-10-06  
FILE SIZE 18x24

