


CS 10191

FILING DATE 12-28-2006

FOR:	VALHALLA CEMETERY
NOTES:	FIELD BOOK 61, PAGE 11-12
SURVEYOR:	W.C. GALLOWAY
DATE STARTED:	JANUARY, 1932
LOCATION:	T12S, R5W, SECTION 4

12-5
Book 61

Book 61 12-5

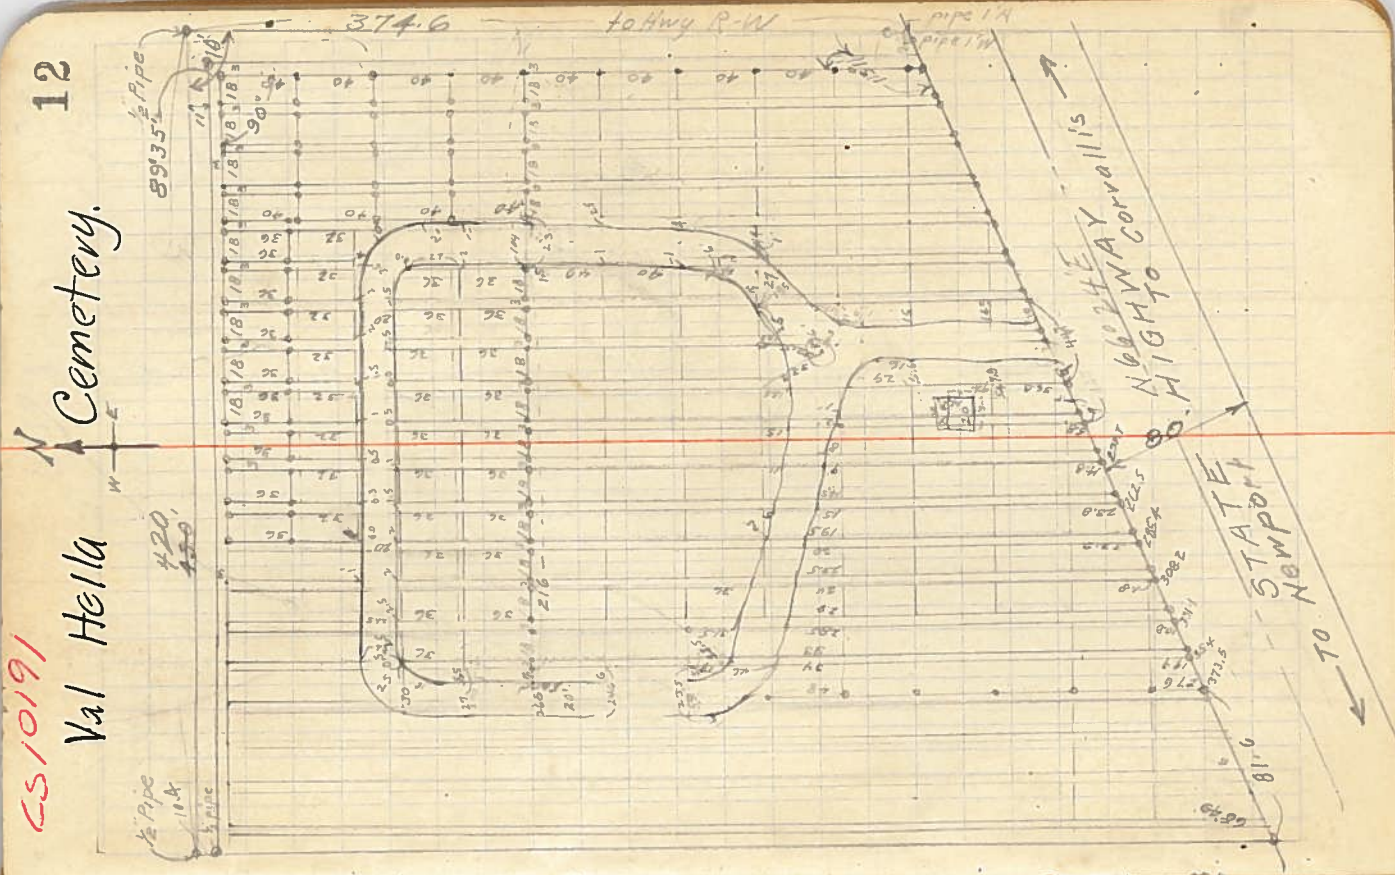

- 18
- 21
- 39
- 42
- 603
- 681
- 684
- 102
- 105
- 123
- 126
- 144
- 399

C	N	S	E	W	N: 1000.00	E 100.00
N. 89° 31' E 343.00	2189 ✓		299 343.00			299 443.00
N. 15° 5' S 0° 08' W 374.6		3746		54 -0.65	11,1002.88	45 442.35
S. E 5.16° 24' W 372.54		149.24		343.126 341.75	628.28	99.19 99.07
S. W N. 0° 08' E 321.02	521.07 321.02		76 0.71		479.31 479.97	100.60 99.93
					1000.00 999.99	100.00 100.00