

CS 10199

FILING DATE 12-28-2006

FOR: BENTON COUNTY
NOTES: FIELD BOOK 89, PAGE 47-52
OLD ROAD 612
SURVEYOR: W.C. GALLOWAY
DATE STARTED: JANUARY 21, 1936
LOCATION: T11S, R5W, SECTION 4
SULPHUR SPRINGS ROAD
CO. RD. 15037

County Road
Surveys
Book 89

FIELD BOOK

931A

47

Road 612
Salpbur Springs Road in Sec. 4 T11-5
CS 10199

Jan. 21, 1936

$\frac{88.05}{10.45}$

Oak 18°S 86°15' E 72.25 = 1095
" 18°N 30°15' W. 184.4 4°45' = 2785

4 sec.

Stake 8 48 X 16

Oak 5°N 85°45' E. 214 = 141

" 4°N 70°30' W. 684 = 451

" 16" about E. 06 = 4

M

Year stake

Fir 10°N 40°W. 75 = 495
Maple 8°W. 23 E 36 = 27.8
Willow 3°S 57°E 10 = 66
Maple 12°S 44°W. = 115 = 75.9
" 2°W N. 27 E. 32 = 41.1
Willow 30°N 40°W. 75 = 495
Maple 1°N 5°W. 32 = 41.1
Maple 24°S 44°W. 112 = 73.9

Adrian Soits 48

James Johnston

Oak 8°N 33°40' E 270 = 178.2
" 8°S 45°E 225 = 148.5
Hsc S 14 1/2 W.

4

4 Cor
58 X 36 Year stake
Maple 4°S 27°30' E. 974.64

W. 15 48.05 S. 91 N. 11
For No. 1934
Fir 10°N 40°W. 75 = 495
Maple 12°S 44°W. = 115 = 75.9
Willow 3°S 57°E 10 = 66
Maple 12°S 44°W. = 115 = 75.9
" 2°W N. 27 E. 32 = 41.1
Willow 30°N 40°W. 75 = 495
Maple 1°N 5°W. 32 = 41.1
Maple 24°S 44°W. 112 = 73.9

TE


E = 30.890'

Δ = 63°35'

Pl.

+50.85' 400.85
 +49.95' 400.7
 62.0
 102.69

At barn

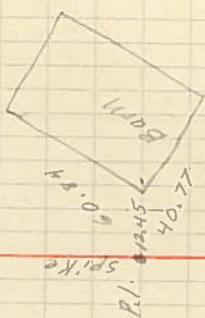

70.44 +5.55'

E=
Δ=4226
C.R.