


**Benton County
Surveyor's Office**

C.S. FILE NO 10219
FILING DATE 3-27-07
FILE SIZE 18x24

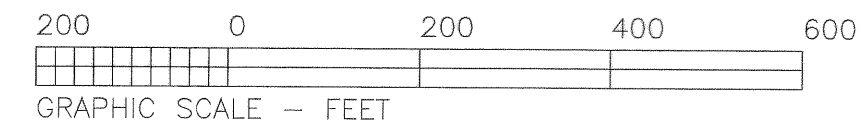

MAP OF
PROPERTY LINE ADJUSTMENTS SURVEY
FOR
**Kenneth E. Simons
Kelly & Kathleen Drebin
and
John & Laura Hawkins**

JANUARY 3, 2006

IN THE
FRANCIS WRITSMAN D.L.C. No. 50
N.E. 1/4 OF SECTION 14
T10S , R5W , W.M.
BENTON COUNTY, OREGON

NARRATIVE

This survey was prepared pursuant to conditions of Benton County Community Development Dept. Case File Nos. LU-05-102 , LU-05-103 & LU-05-104.

Monuments at the corners of Property "1" (prior to adjustments) are called for in deed M-301533-01 and Properties "2" & "3" (prior to adjustments) were Parcels 1 & 2 of Partition Plat 1998-05. All found monuments were held in position and new monuments set as shown.

REGISTERED
PROFESSIONAL
LAND SURVEYOR

Darryl W. Harms

OREGON
JULY 30, 1976
DARRYL W. HARMS
1079
RENEWAL DATE 6/30/07

DARRYL W. HARMS, P.L.S.
720 N.E. GRANGER #1
P.O. BOX 1051
CORVALLIS, OR 97339
PHONE: (541) 745-3948
FAX: (541) 745-3952

LEGEND

- 5/8" IRON ROD FOUND, SOURCE NOTED
- (A) WITH YELLOW PLASTIC CAP STAMPED "SEADERS 1014" PER C.S. 9226
- (B) WITH YELLOW PLASTIC CAP STAMPED "SEADERS 1014" PER PARTITION PLAT 1998-05
- (C) 5/8" IRON ROD, NO CAP PER C.S.7080
- (D) WITH YELLOW PLASTIC CAP STAMPED "SEADERS 1014" PER C.S. 9216
- (E) 5/8" IRON ROD, NO CAP PER C.S.5606
- SET 5/8" X 30" STEEL REBAR WITH YELLOW PLASTIC CAP STAMPED "DARRYL HARMS, PLS 1079"
- () RECORD DATA, SOURCE NOTED

PROPERTY LINE ADJUSTMENTS APPROVED
PLANNING FILE REFERENCE Nos.
LU-05-102 , LU-05-103 & LU-05-104

Peter Idema 3-27-07
BENTON COUNTY PLANNING OFFICIAL DATE

