


C.S. # 1026

See notes in file

F.B. 36-32

SURVEY LOCATED IN LINCOLN COUNTY

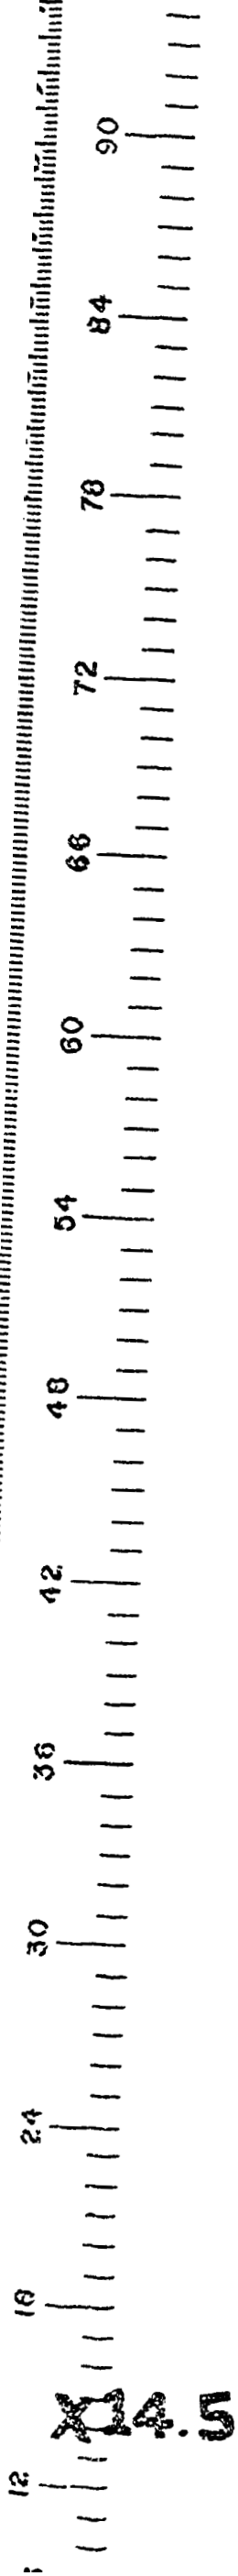

PASTS

FIELD BOOK

36

MAY 1886

36

32

Yachts

Sec. 27, T14S, R12W

1026

Beginning at Pt. N. 21° 3' W. 395.00
 1 L R 21° 30' + 40' 502.6 N. 0° 17'E.
 2 L R 7° 30' + 40' 627.35 N. 7° 41' E.
 3 L R 2° 51' + 150' thru 1000.0 N. 10° 38' E.
 4 L R 8° 20' + 5° 20' 500.0 S. 58° 02' E.
 5 L R ~~8° 20'~~ + 5° 30' 1594.5 S. 88° 44' E.
 6 L L 11° 12' + 12° 40' 253.0 N. 24° 04' E.
 7 L L 9° 05' + 13° 50' 285.7 N. 82° 11' E.
 8 L R 113° 10' - 20° 20' 86.5 S. 21° 21' E.
 B.M. 1 Take out water E. 40'

S. 0° 09' E. 585.00
 N. 57° 15' W. 699.03
 N. 21° 13' W. 395.35
 N. 0° 17' E. 502.04
 N. 7° 41' E. 627.3
 N. 10° 38' E. 999.6
 S. 88° 02' E. 657.2
 S. 88° 44' E. 246.84
 N. 82° 11' E. 274.86
 S. 21° 21' W. 81.11

T.O. Loringood Water System
 May 6, 1927.

Yachts on Highway

Sta. B.S. F.S. H.I. Lev. Remks.

100 H.S.K. 10.10 217.68 B.M.
 27.6 N. 10° E. 8.95 10.78
 150 N. 10° E. 470 228.46

2198 N. 11° E. 3.95

36 N. 57° E. 9.14

15 N. 46° E. 7.92

15 N. 15° E. 5.44

912 N. 20° E. 4.57

723 N. 50° E. 4.47

713 N. 60° E. 4.16

7.56

~~4.78~~

2.18

228.46

41.91

30.63

10.78

beg. at hq. P. S.E. of Lot B block
 in Yacobs' being the S.E. corner
 Town Block sighted along Felipe
 of Block to 3 1/2 pipe N. 24° 44' E.

S. 55° 39' E 14112
 2° 50' 3602
 N. 26° 42' E + 7° 30' 1464

80 25
 81 24 416 W
 S. 55° 39' E.

24° 46'
 18' 16'
 6° 30' Mollé

24° 46'
 6° 30'
 18' 16'

S. 55° 39'
 6° 30'
 S. 62° 09' E.

N. 26° 42' E
 6° 30'
 N. 20° 12' E

504
 56
 3024
 2024
 33264

14412
 3578
 5040

24° 46'
 18° 16'
 6° 30' Mollé

N.E. less
 S.E. greater

1451