


RICE TRACTS

103 10'

Chas. Johnson Cl. N^o 40, T.12S, R.5W.

Scale-1"=300 Chs

C.R. ERR.

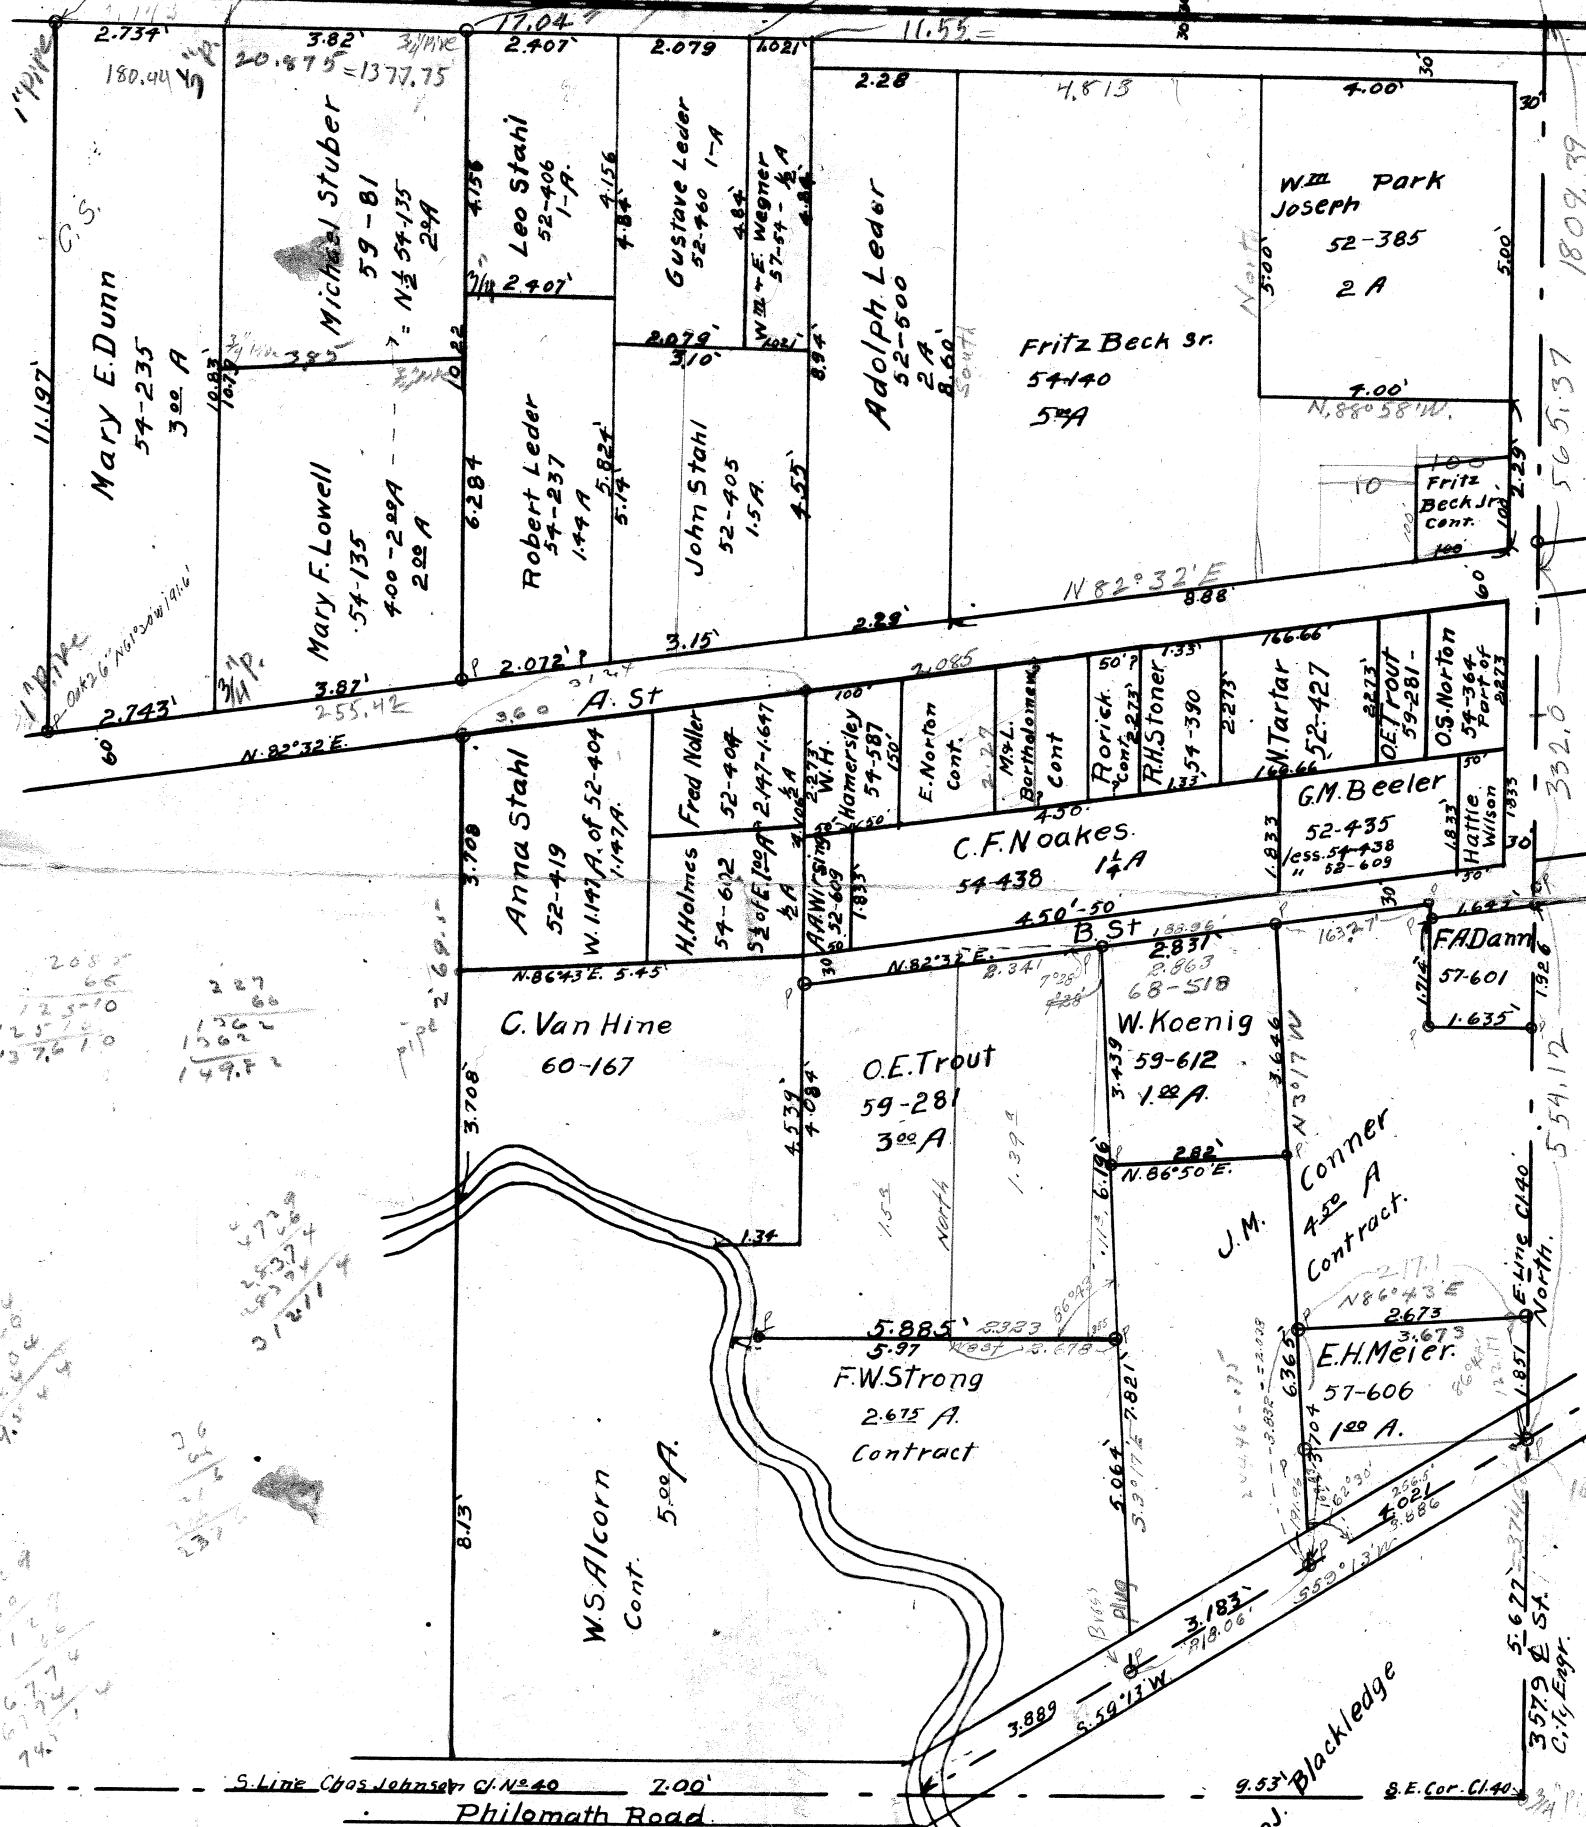

20.85 = 1376.1
 1946
 14.626
 12.571


2.743
 255.42
 N. 82° 32' E.

268
 12.570
 1376.10

1228
 264
 149.2

2.096
 2.733
 2.733
 5.471

12.6
 19.32
 19.92

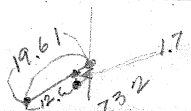

1000
 700
 1809.39
 565.37
 332.0
 554.12
 1809.39
 Kings Road + R.R. N.E. 1/4
 Kings Road
 Kings Road