

C.S. # 1032

Original Town of  
Marysville  
Block 4 and 5

F.B. 36-46

PASTY

FIELD BOOK

36

MAY 1885

36

46

1032

Miscellaneous

Mouse

66.92  
66.93  
67.0

102277C

102 07 87

First St

67.42

1011

Madison St.

13  
53


529  
4350  
4350  
1754  
260

67.46  
63  
66.93

1027674  
52  
582  
582  
544628

291  
582  
582  
00553

1st St.

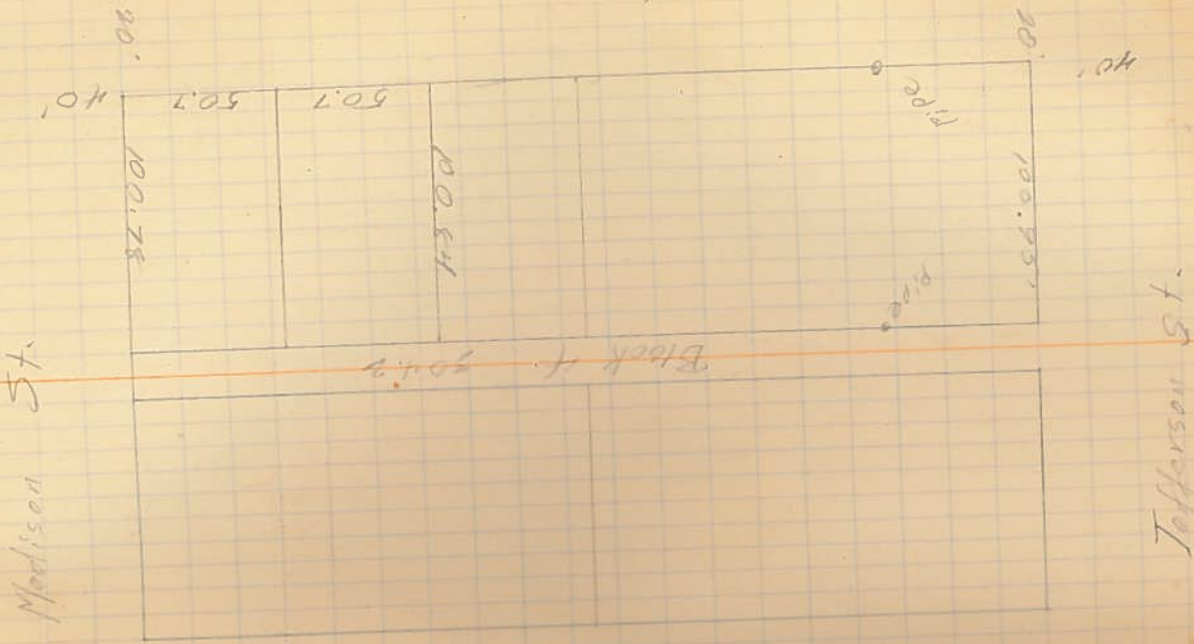

2nd St.