


RECORD OF SURVEY

for **HULL-OAKES LUMBER CO.**

in the SE1/4 SECTION 35, T14S, R6W, W.M.  
and the JEREMIAH STARR DLC NO. 44  
BENTON COUNTY, OREGON  
MARCH 10, 2009

Benton County  
Surveyor's Office

C.S. FILE NO. 10361  
FILING DATE 3-26-09  
FILE SIZE 14x17

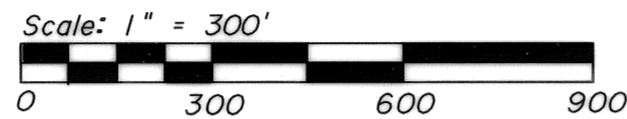

**NARRATIVE**

The purpose of this survey is to monument the Southwest corner of Parcel 2 of Partition Plat 2008-04 and to mark the boundary between Parcels 1 and 2 of said plat.

Parcels 1 and 2 of Partition Plat 2008-04 are both unsurveyed. It appears from said plat that the Southwest corner of Parcel 2 is intended to be 275.00 feet (along the township line) from the Northwest corner of Parcel 3 of Partition Plat 92-17, and we have set said corner on that basis.

Monuments found as per BCCR 146844070R2, C.S. 9564, and C.S. 5793 were held as control for this survey.

- ● Monuments found as noted
- Set 5/8" X 30" iron rod with plastic cap (LS 60065)
- £ } Data of record as per Partition Plat 2008-04
- ( ) Data of record as per C.S. 9564
- [ ] Data of record as per C.S. 9768
- BCCR Benton County Corner Restoration
- \\\\\\ Boundary lines posted with 6' steel posts
- Iron pipe diameters are inside measure

SURVEYED BY:  
PETERSON & ASSOCIATES  
8155 NW MITCHEL DRIVE  
CORVALLIS, OREGON 97330  
PHONE: 541-757-1794

REGISTERED  
PROFESSIONAL  
LAND SURVEYOR

OREGON  
JULY 15, 2003  
BRIAN M. PETERSON  
60065  
RENEWAL: 12-31-10

