

**Benton County  
Surveyor's Office**

C.S. FILE NO. 10509  
 FILING DATE 11-4-11  
 FILE SIZE 8 1/2 x 14

MAP OF SURVEY  
 FOR  
**E.D. HUGHES  
 EXCAVATING, INC.**  
 NOVEMBER 1, 2011


IN THE  
 A.N. LOCKE D.L.C. No. 41  
 N.E. 1/4 OF SECTION 14  
 T.11 S., R.5 W., W.M.  
 BENTON COUNTY, OREGON.

**N.W. James St.**  
 ROAD No. 15600

**N.W. Barbara St.**  
 ROAD No. 15601

**N.W. James Pl.**  
 ROAD No. 15602

FD. 5/8" IRON ROD  
 SET IN C.S. 5902

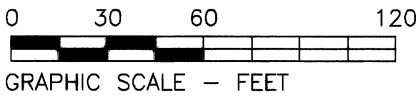

**Legend**

- MONUMENT FOUND, TYPE & SOURCE NOTED
- SET 5/8" X 30" STEEL REBAR WITH RED PLASTIC CAP STAMPED "DARRYL HARMS, PLS 1079"
- ( ) RECORD DATA FROM C.S. 10327
- [ ] RECORD DATA FROM C.S. 5902 AND JACKSON CREEK SUBDIVISION

(S 00°03'26"E 415.64')  
 S 00°03'26"E 415.58  
 BASIS OF BEARINGS

INTERIOR CORNER OF WEST LINE  
 OF LOT 16, JACKSON CREEK  
 SUBDIVISION

FD. 5/8" STEEL REBAR  
 WITH YELLOW PLASTIC  
 CAP STAMPED "DARRYL  
 HARMS, PLS 1079"  
 SET IN C.S. 10327

(254.86') 254.86'

(160.78') 160.72'

60

60

60

**Narrative**

The monument marking the Southwest corner of the South end of N.W. Barbara St. was disturbed during construction of a roadway to the property to the west. I replaced the monument on line between found monuments as shown.

REGISTERED  
 PROFESSIONAL  
 LAND SURVEYOR

*Darryl W. Harms*

OREGON  
 JULY 30, 1976  
 DARRYL W. HARMS  
 1079

RENEWAL DATE 6/30/13

DARRYL W. HARMS, P.L.S.  
 P.O. BOX 1051  
 CORVALLIS, OR 97339  
 PHONE: (541) 745-3948  
 E-MAIL  
 darrylharms@proaxis.com