

W. C. GALLOWAY, COUNTY SURVEYOR
RESIDENCE TELEPHONE 721-J

ORIGINAL


WALTER W. LARSEN, DEPUTY
RESIDENCE TELEPHONE 924-R

COUNTY SURVEYOR OF BENTON COUNTY
TELEPHONE 519-J

CS 1123

CORVALLIS, OREGON.

Sec 30 - T. 11 S. R. 5 W.
Scale: - 1" = 2 chains

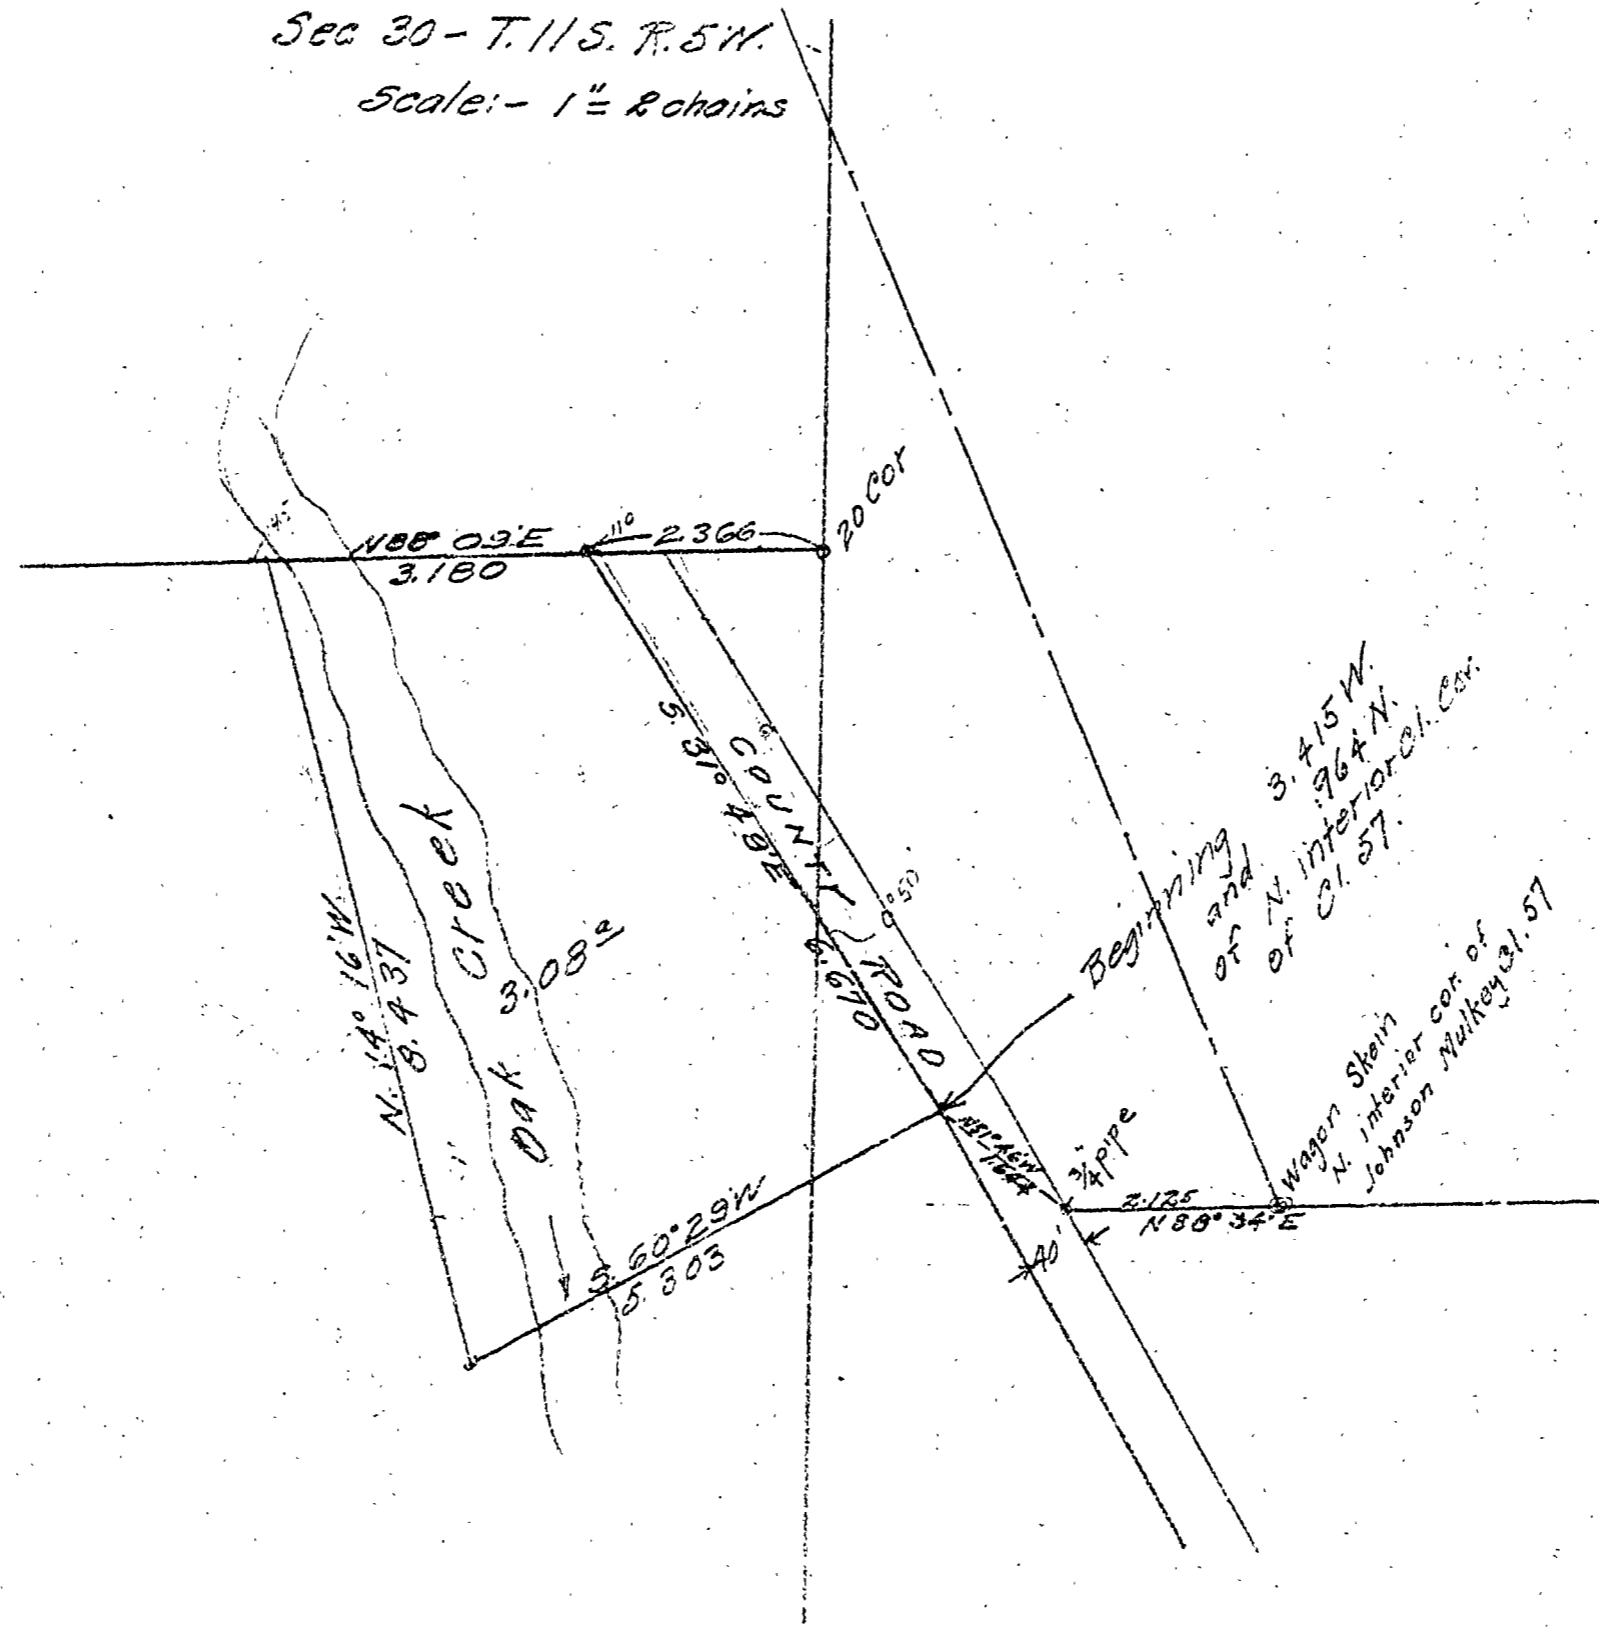

T. H. S. R. 5 W

Book 52

BOOK 52. 11-5

March 11, 1930

C.S. R.R. Cont

For C.C. Measey

Began at N.E. Cor Lake

Marked by Cl. B.S. on fence West

Marked by T 11-5

6.700 6.09R
3.770
4.000

88°53L
90°02E
0°18L
set 1" pipe
S.E. of Barn N65°W

N 1°20'W
Silver Maple 10" S61°W 15.93
North N.E. of tree S67°W

9.757
5.000
3.443
1.800

18.800
1.773
0°13R
0°13R
0°0'
set 1.630
+ 654E
018E

1.424
787
R.140

1.418
779
R.140
0°0'

3.555
3.035
5.000
4.995
18.894

1.932
1.912 = 1.406N 1.895E
80.300

Fire 15 N20W 1.06
" 30 S66E 1.51
" 12 S78W 1.35

1128

1128

018E

67752
1912
1355404
67752
609768
67752
129542
75551
1912
47102
75551
661959
735513
1406293
1.895
11.8
54.66
66.50
19475
50.136
1.163
= 1.952
0.11E
1.895
1.324
40372
1.324

19.973
20.360
240.273
24.136

