


C.S. # 1207

Dixon's 2nd Addition  
Block 17


F.B. 84-105

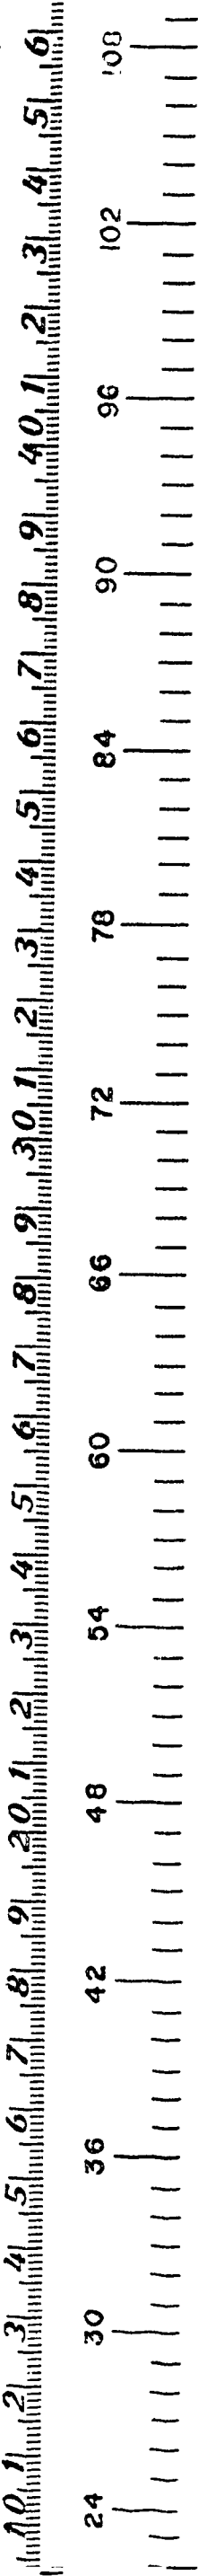

PC#84

100.1  
100.02  
97.08  
903

302.6  
100.87  
201.73  
100.87  
504.60

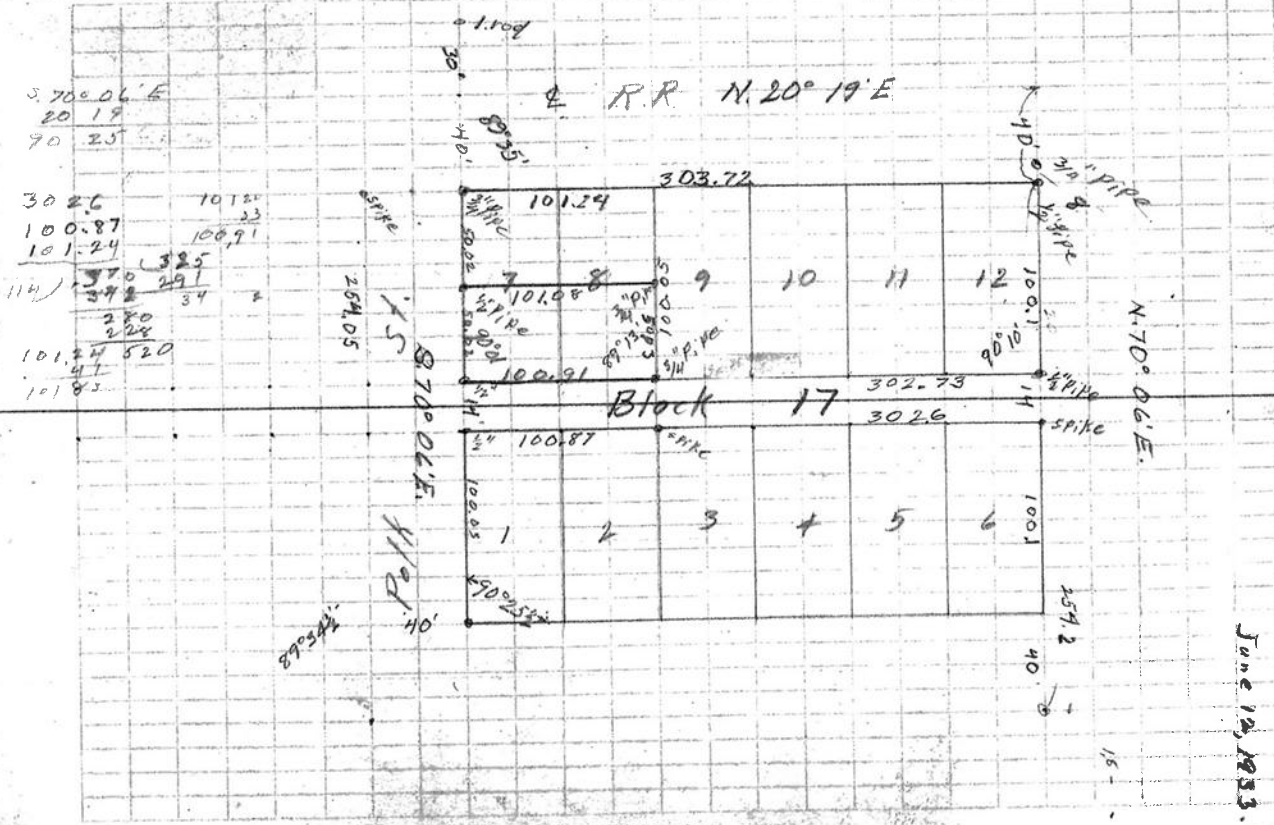

Dixons 2nd Addition

June 12, 1953