

C.S. # 1294

Avery's Addition
Block L


F.B. 85-3

REEL 13 FRAME 232

Recorded on Plot Oct. 19, 1936

90° 19'

5 Th. St.

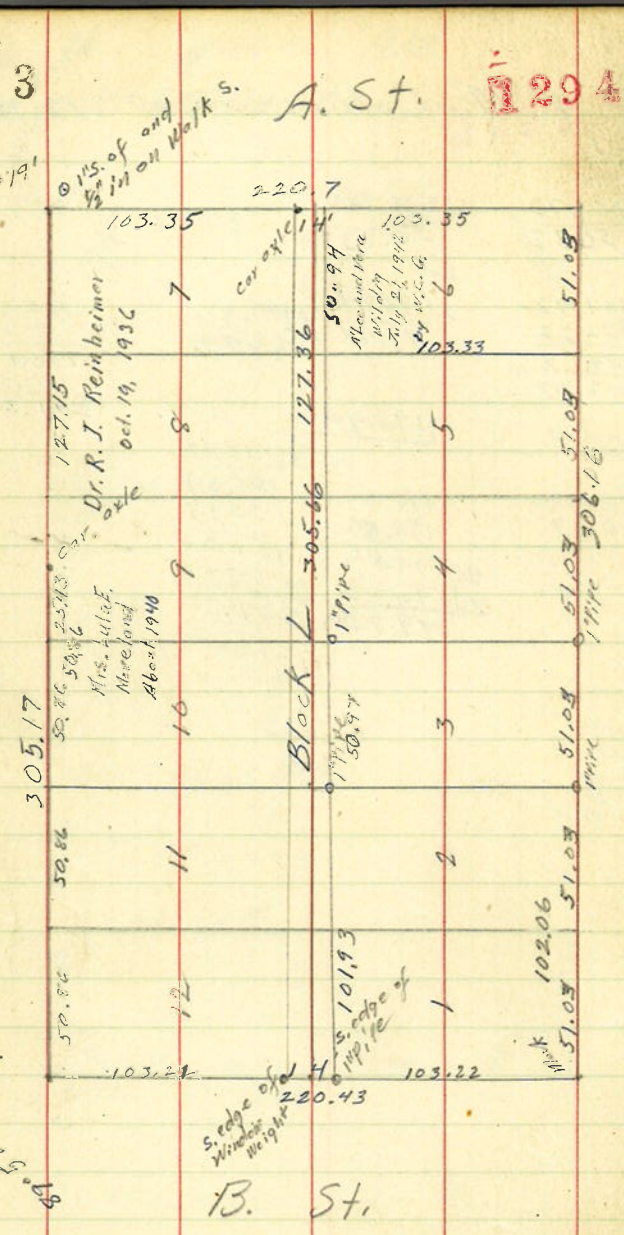

13. St.

A. St. 1294

R. J. Weinheimer, Dr.
Lots 7, 8 & N 1/2 of 9 in Averys Add.
Oct. 19, 1936

| |
|------|
| 125 |
| 25 |
| 625 |
| 250 |
| 3125 |
| 120 |
| 462 |
| 445 |
| 507 |

| |
|---------|
| 306 |
| 127.15 |
| 50.86 |
| 25.48 |
| 25.48 |
| 2445 |
| 2445 |
| 720 |
| 305.17 |
| 50.86 |
| 25 |
| 25430 |
| 10173 |
| 127.150 |

| |
|----------|
| 101.93 |
| 305.77 |
| 21611.33 |
| 505.668 |
| 101.93 |
| 305.79 |
| 6306.11 |
| 51.03 |
| 306.24 |
| 305.17 |
| 21611.41 |
| 305.705 |
| 50.951 |
| 50.951 |
| 25.48 |
| 127.38 |
| 178.28 |
| 6305.66 |
| 50.943 |
| 25 |
| 254715 |
| 101586 |
| 1273575 |