

C.S. # 1301


West Corvallis
Block 11

F.B. 85-7

7

West Corvallis Add.

1301

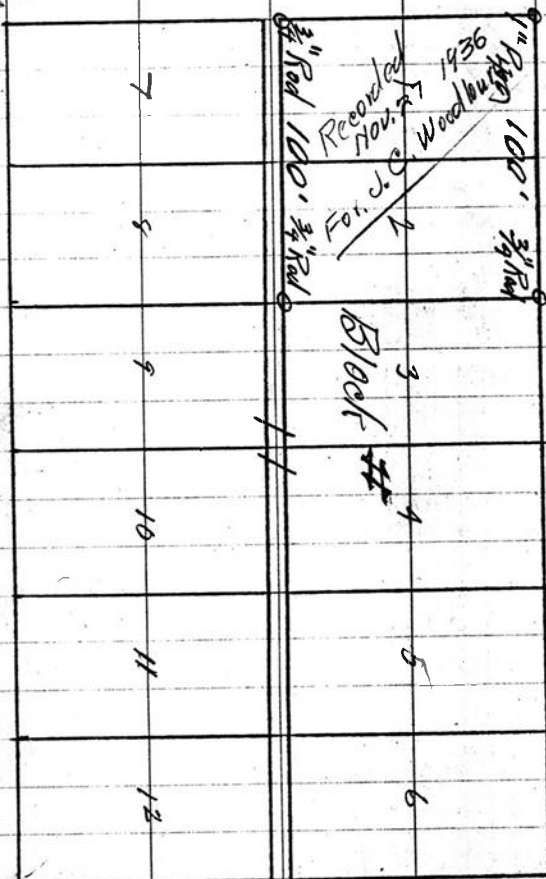

8

J. C. Woodbury Nov 27 1936.

S. 89° 39' W. 90° 00'
 90° 21'
 15'