

C.S. # 1309

Hardcopy 11-6 #4

also see notes in file

F. B. 55-43

43 1309

CS. 170

Bag. at $\frac{45}{78}$ T. 11-6

N. 0° 07' E from witness trees

Correction W. $\frac{3}{4}$ " to W.C.

to Cl. cor.

W. 1° 01' - 2° 5,956

-002 + 5,950

Striking E. of W.C. 006

Wagon spring

Fir 20" S. 66° 40' E. 234

Maple 9" S. 22° E 279

N. 87° 31' W.

2 + 210' 7,535

3 S. 49° 14' W. + 1° 05' 7,061 = 7,060

+ 33' for diversion.

4 S. 48° 21½' W. 9,067 - 134' wood.

set ¾" pipe

B.M. Spike S. 17° 06' E. 120

From sec. cor. S. 1° 28½' W. N.W. cor. Hsc. 618

From sec. cor. S. 11° 02' W. + 45' 393

+ 1° 48' thru

460

S. 9° 04' W. + 1° 40' 340

25' E. Q.

For C. Rosewarne

Jan. 16, 1937

44

Water Right

N. bet. 778 1¼" shaft ash 6" N. 6° 20' E. 1,077

1914

6/5 Fir 6" N 39° E 61 Fir 18" S 42° W. 1,72

7/8 " 6" N 45° W. 64 " 12" N 27½° W. 510

Saguna 6" S 50° W. 36

" 8" S 33° E 56

585 N. of sec. cor.

SW. cor. Rubel F. Buge tt Cl. 57

W.C. 10 E. Wagon spring

Fir 20" S 66° 40' E. 234

" 20" S 13° W. HIL std. dead

39.80 S. 89° 30' E

6 Oak 6" S 15° E 26

7 " 10" N 71° E 235

64.80 field

75.00 stream 15 N. E

22
 = 123
 147

393

460

853

S. 11° 40' W.

S. 12° 34' W. 1195'

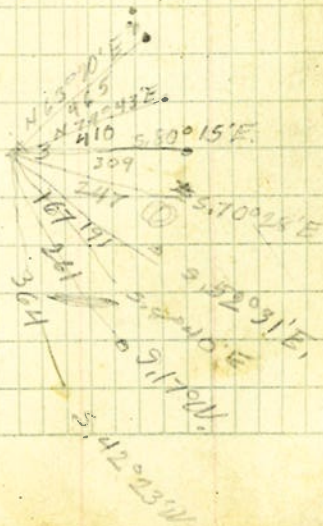
N. 87° 31' W. 7,530

34
N. 86° 37' W.

S. 49° 14' W.

54
S. 50° 09' W.

S. 46° 21½' W.

51
S. 49° 15½' W.

B.S. H.I. F.S. H. (Assumed)

3.51

400.00 BM on 34 ft

403.51

-3.37

11.00 392.51 T.P.

389.14

.44

11.79 377.38

377.79

1.65 376.14 T.P. dam

14.7 363.07 Cr. at E. end

9.78

1.69 376.10

385.88

6.57

10.01 375.77 mistake

382.34

3.86

6.74 375.60

379.46

4.56

4.06 375.40

379.96

3.74

4.80 375.16

378.94

N. 66° 05' E 538

N. 65° 25' E 528 - 110' Cr

N. 42° 55' 259 Same

N. 30° E 150 3.93

N. 30° E 72 3.92

S. 61° 14' 113

273 N. 30° E. 6th str

356 N. 30° E 560 N. 30° E. 4.74

218 N. 22° 10' E 467 * 11 ft

217 N. 10° 30' E 406

222 N. 37° E N. 15° W. 92

150 N. 70° 20' E 67.4 S. 61° 14' 410 str

72 N. 74° E 5th str 6.67

153 N. 65° E

197 N. 63° 10' E 10.01

94 T.P. dam N. 66° E, 350 9.87

328 1.69