


1325

CREST OF SUNSET HILL

SCALE 1"=20'

C.S. File No 1325 T12S R5W SEC. 4

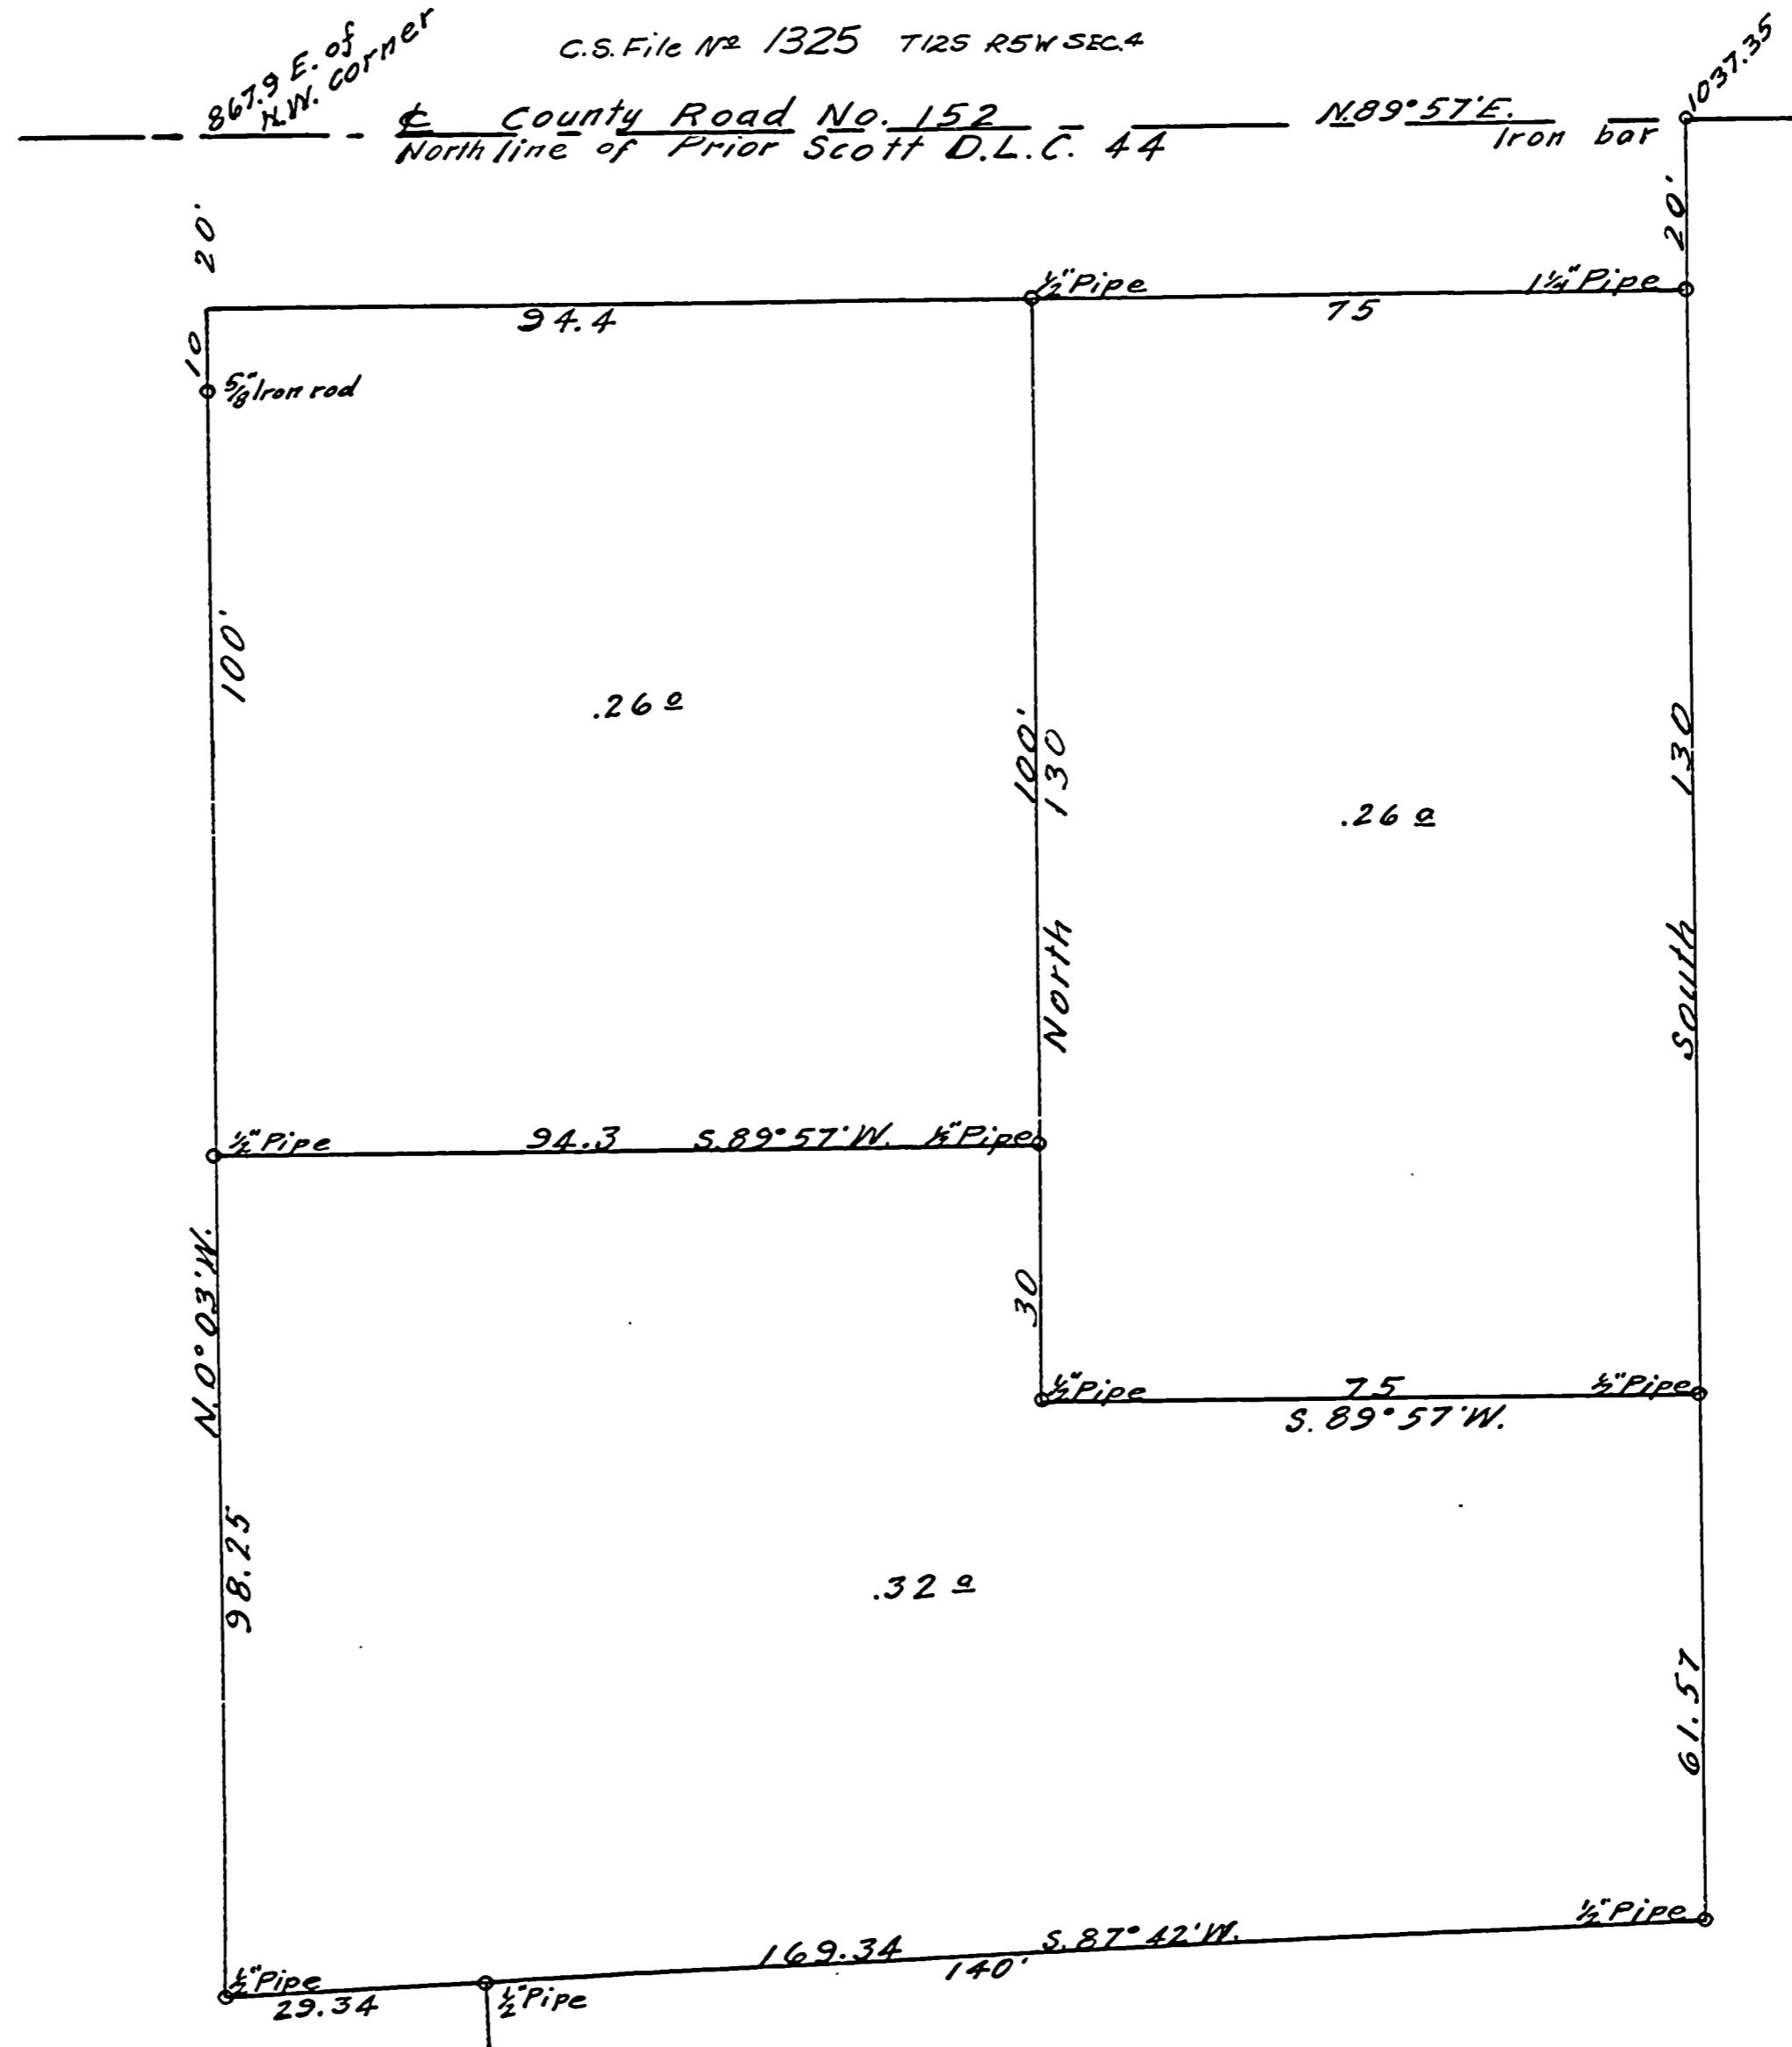

C.S. File No 1325

25