

C.S. # 1328


Hillcrest Addition

F.B. 85-27

FB #85

27

1328

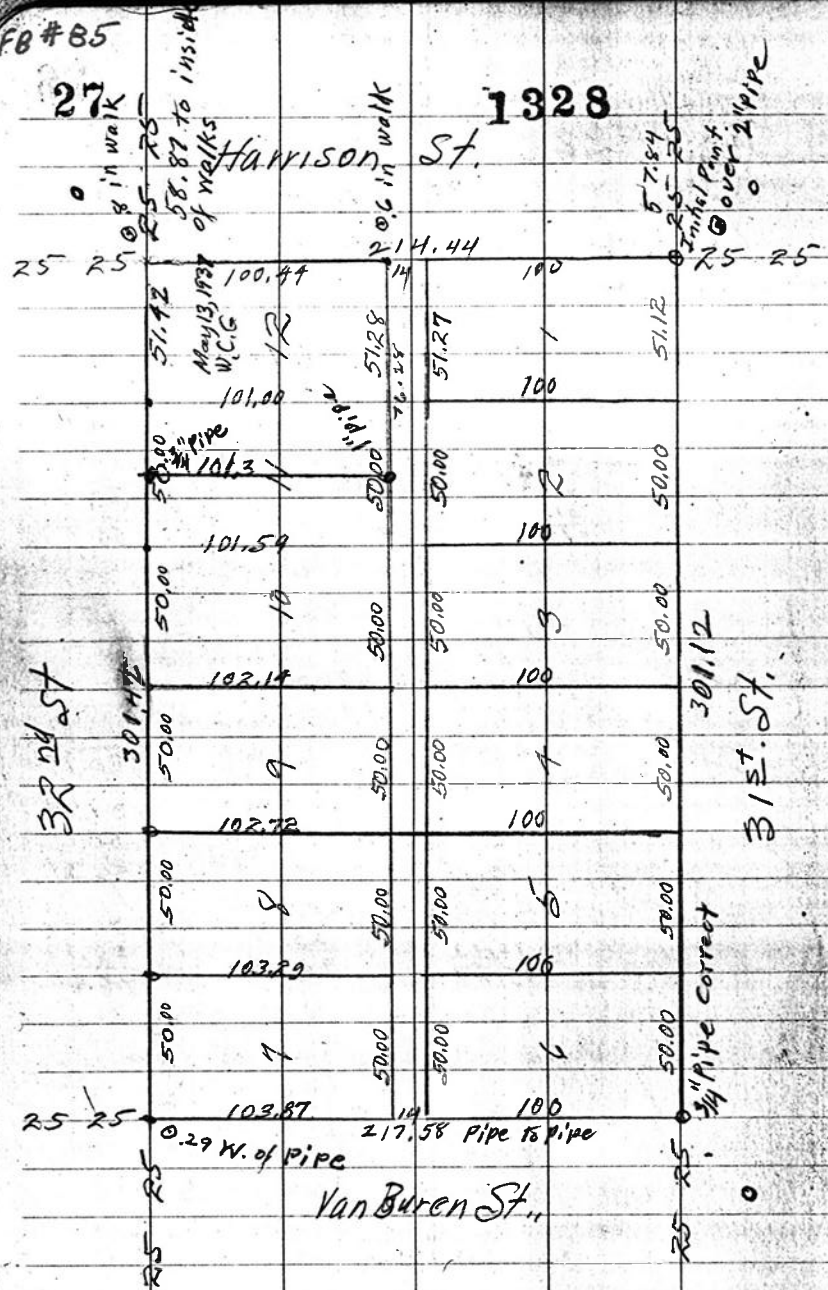

Mr. Sprague

Block 1 Lot 12 & 14 1/2 of Lot 11.
 Hill Crest Add.
 (Lot 1 College Holmes)

5/7/37 R.J.S. 1 hour.